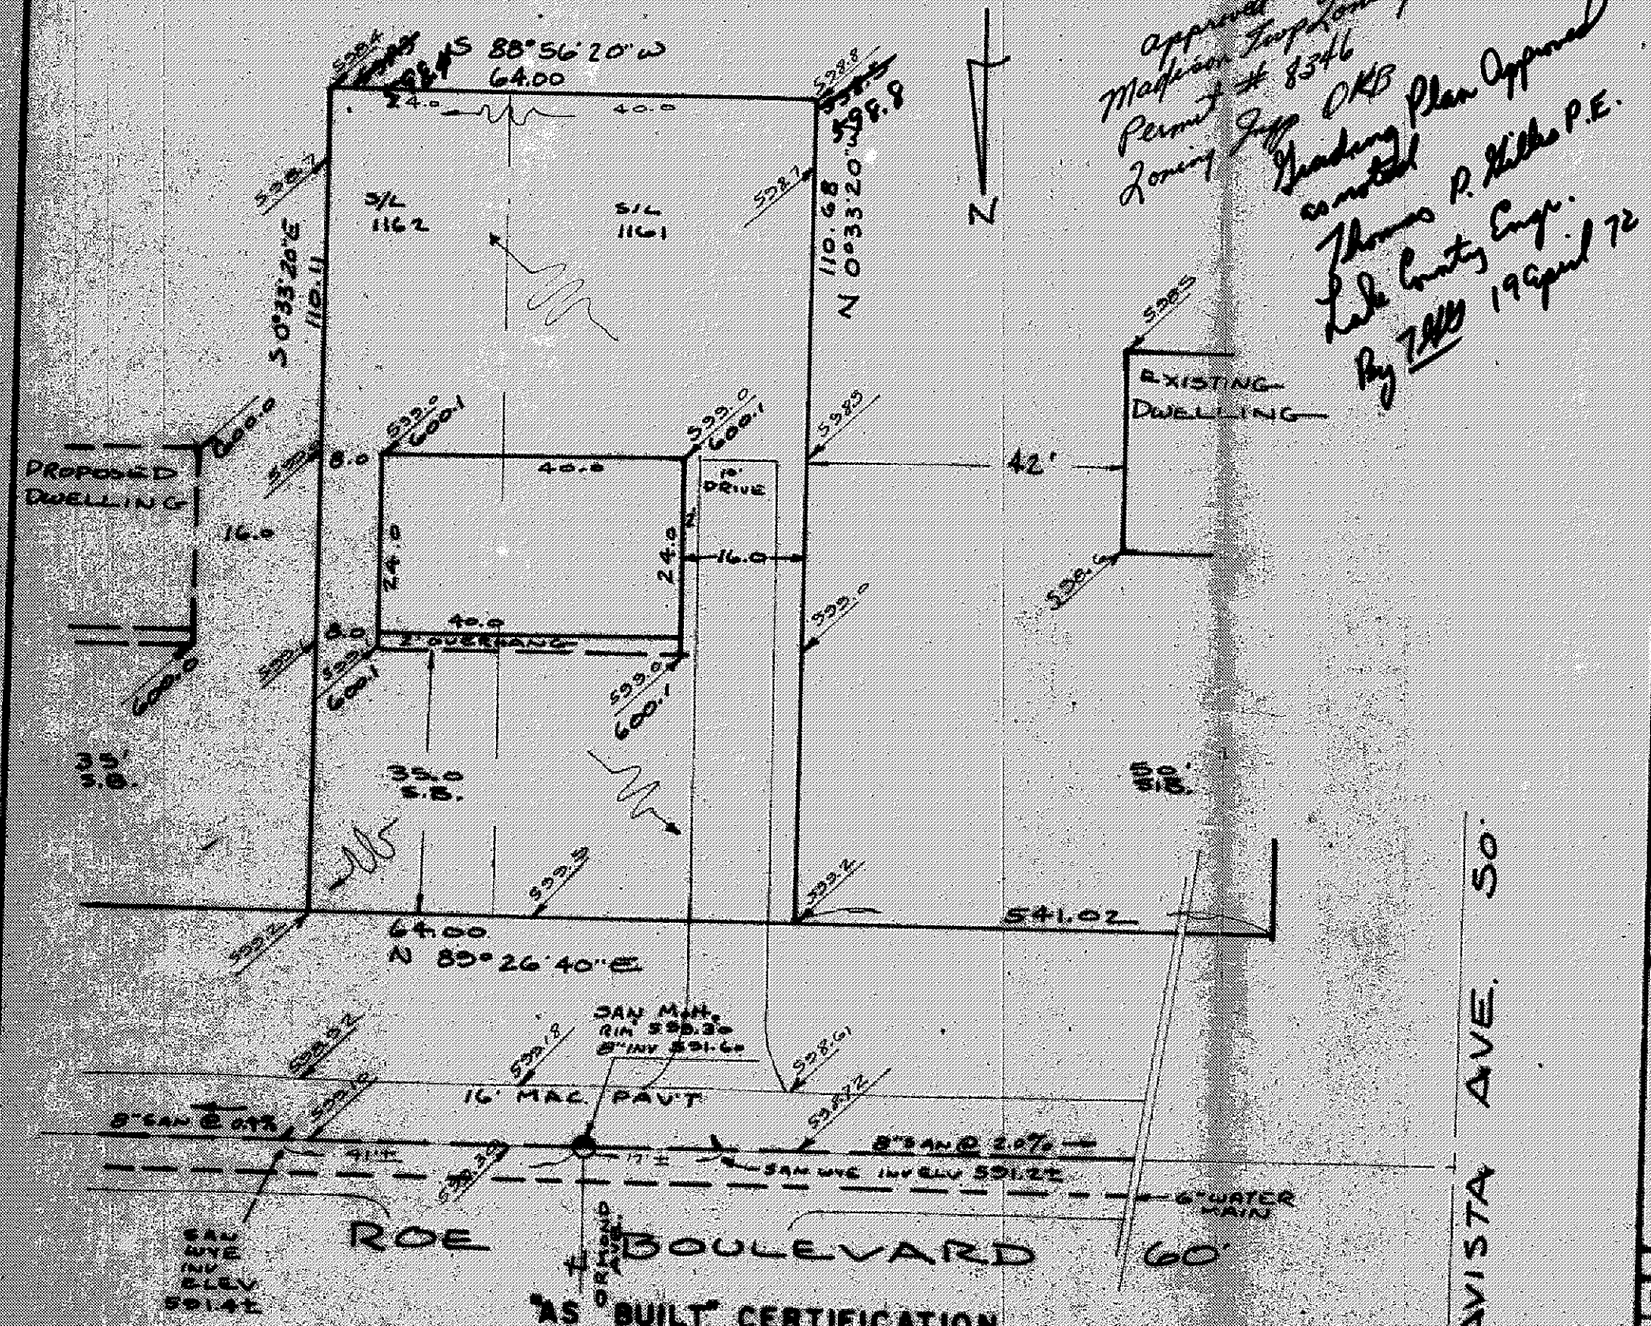

approved Madison Twp Zoning Permit # 8346 Zoning Insp OKB

Grading Plan Approved as noted Thomas P. Gilles P.E. Lake County Engr. By TGG 19 April 72

"AS BUILT" CERTIFICATION

I, HEREBY CERTIFY THAT THE CIRCLED GRADES ARE EXISTING FINISH GRADES CHECKED IN FIELD ON _____ 19__ BY _____ SURVEYING AND ARE CORRECT TO THE BEST OF MY KNOWLEDGE AND BELIEF

REGISTERED SURVEYOR _____ NO _____

SITE PLAN

MADISON (TOWNSHIP) LAKE COUNTY, OHIO

for RYAN HOMES INC (CLIENT OWNER)

6976 (ADDRESS) Roe Blvd (STREET) Madison (CITY) 44057 (ZIP)

CUMINGS BEACH PARK (RECORD SUBDIVISION)

F (VOLUME) 49 (PAGE)

1161-1162 (SUBLOT NO) ROE BLVD (STREET)

LOT _____ TRACT _____

VOLUME _____ PAGE _____

PERM. PARCEL # _____ STREET _____

LEGEND

SANITARY MANHOLE
STORM MANHOLE
INLET OR CATCH BASIN
HYDRANT
EXISTING CONTOURS
PROPOSED CONTOURS
EXIST. ELEV. 100.0 / 100.0 PROP. ELEV.

WATER VALVE (GAS)
WATER METER (GAS)
AS BUILT ELEVATION
DIRECTION OF SURFACE DRAINAGE

REMARKS

ALL BOUNDARY DATA SHOWN WAS OBTAINED FROM (DEEDS, RECORDED SUBDIVISION PLAT, OR OTHER PUBLIC RECORDS)

DESIGN CERTIFICATION

THIS PLAT WAS PREPARED BY ME, AND IS CORRECT TO THE BEST OF MY KNOWLEDGE AND BELIEF

Richard J. Bilski (NAME) PS #5244 (SURVEYOR REGISTRATION NO.)

CHECK LIST

DIMENSIONS
BEARINGS
TIE TO NEAREST STREET
SUBLOT NO PARCEL NO
SURROUNDING OWNERS
BLDG DIMENSIONS FIN GR
BLDG TIES FLR GRADES
APRON TYPE WIDTH THICKNESS
SIDEWALK TYPE WIDTH THICKNESS
CULVERT TYPE DIA LENGTH

WATER MAIN SIZE LOCATION
SAN SEWER SIZE % GR LOC
SAN MH CAST ELEV INV ELEV
SAN CONN SIZE LOC DEPTH
STORM SEWER SIZE % GR LOC
STORM MH CAST ELEV INV ELEV
PAVT TYPE GRADE CURBS
GAS LINE LOC SIZE PRESSURE
SEPTIC TANK SIZE LOC
WELL LOCATION

REVISIONS		
NO	DATE	BY
1		
2		
3		
4		
5		

PLAN PREPARED BY:

DEBEVEC SALO & ASSOC INC (NAME)

130 E. JACKSON ST. PAINESVILLE, O. (ADDRESS)

DRAWN BY RJB	SCALE 1" = 20'	PHONE NO.
CHK'D	DATE MAR 17 '72	DRAWING NO.
CREW CHIEF	APP'D	3528-1161