Approved
Madison Twp Zoning
Permit # 8315
Zoning Insp OKB

Finish plan approved
as noted
Thomas P. Hollis P.E.
Lake County Engr.
19 April 72
By TPH

SITE PLAN

MADISON TOWNSHIP — LAKE COUNTY, OHIO

for RYAN HOMES INC
CLIENT OWNER

6888 Roe Blvd Madison 44057
ADDRESS STREET CITY ZIP

CUMINGS BEACH PARK
RECORD SUBDIVISION

E 43
VOLUME PAGE

1160-1165 ROE BLVD
SUBLOT NO. STREET

LOT TRACT

VOLUME PAGE

PERM. PARCEL # STREET

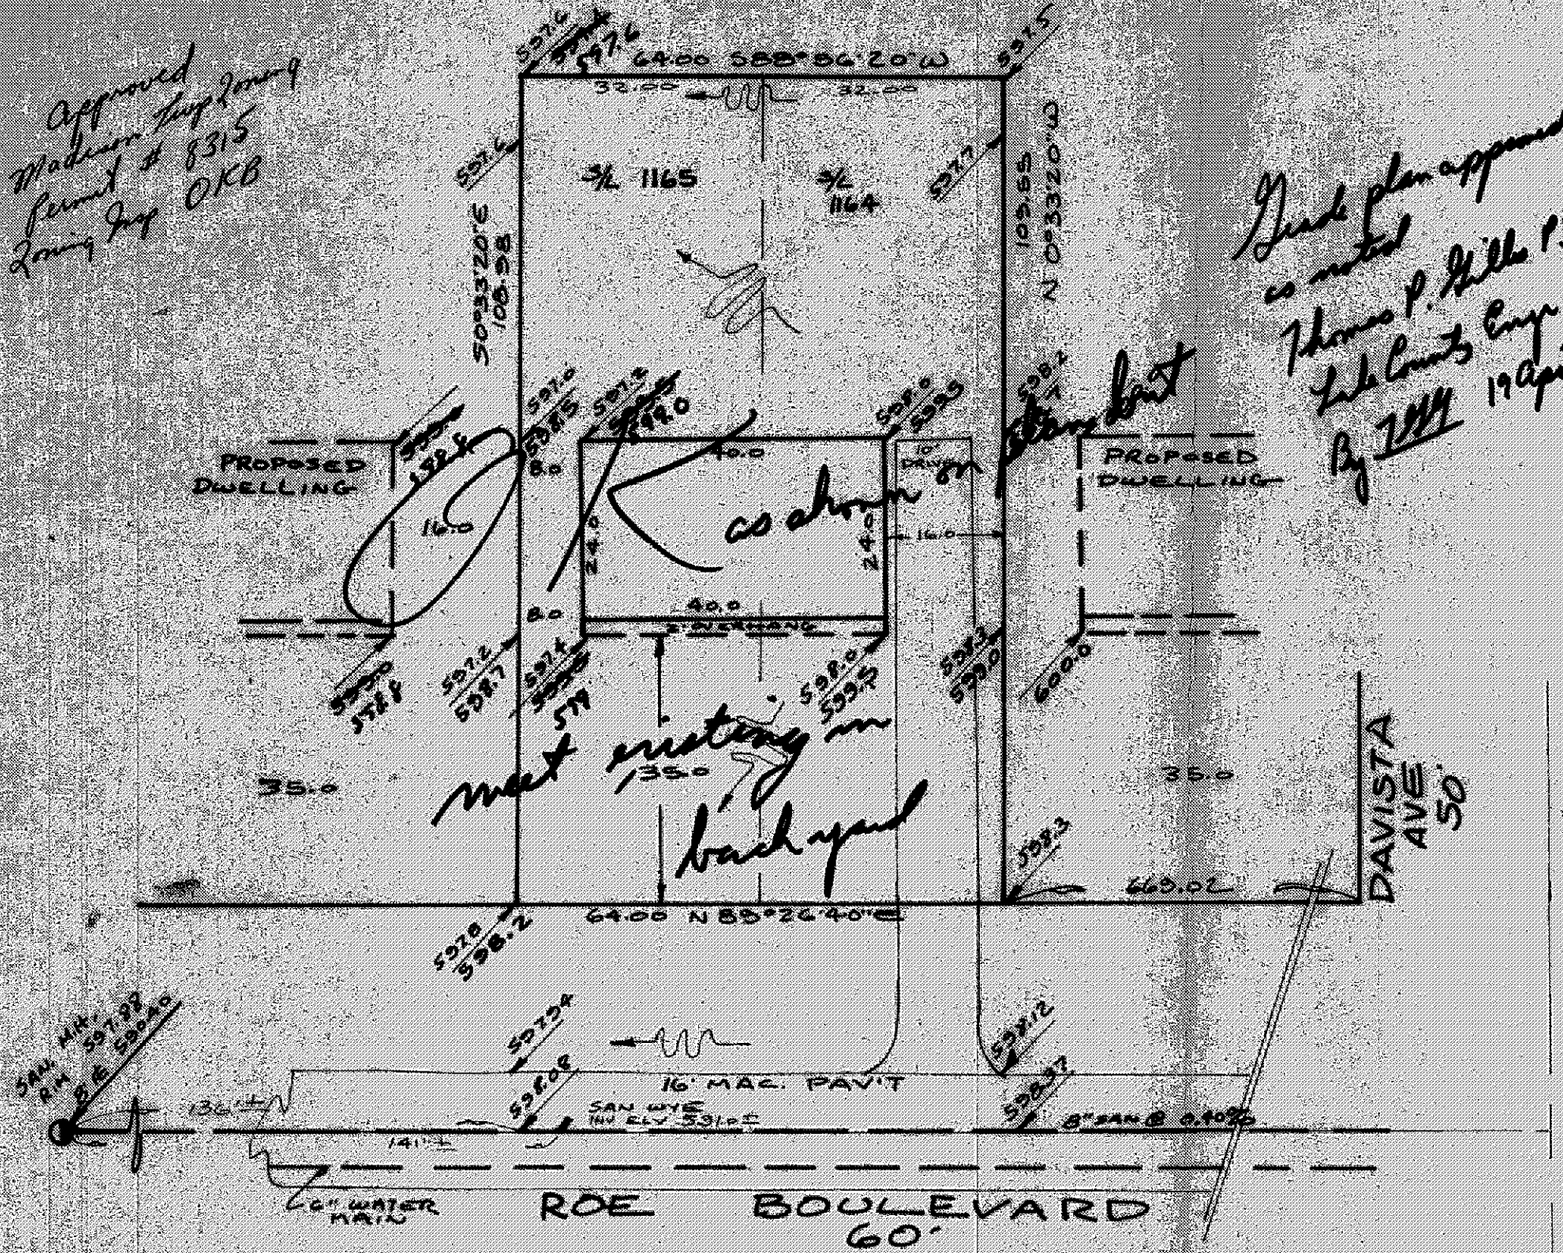
PROPOSED DWELLING
PROPOSED DWELLING
1165
1164
64.00 S88°56'20"W
S03°32'20"E 105.00
N03°32'20"W 105.00
40.0
24.0
8.0
16.0
35.0
35.0
as shown
set existing grade
back yard
DAVISTA AVE. 50'
64.00 N 85°26'40"E
669.02
16' MAC. PAV'T
SAN MH
SAN MH
SAN MH