S/L #3

SITE PLAN FOR

P.A.C. HOMES
P.O. 691
GENEVA, OHIO

BEING PARCEL 3 IN THE MADISON BEACH ESTATES IN MADISON TWP LAKE COUNTY, OHIO

PREPARED BY:

WM. R. GRAY ASSOC. INC
7547 MENTOR AVE
MENTOR OHIO
MODIFIED PAC Homes 4/30/79
SCALE: 1 - 20
DATE: APRIL 28, 1978

CERTIFICATION:

I HEREBY CERTIFY THAT THIS PLAT IS CORRECT TO THE BEST OF MY KNOWLEDGE

BY: Wm. R. Gray
WM. R. GRAY REG SURV. #2752

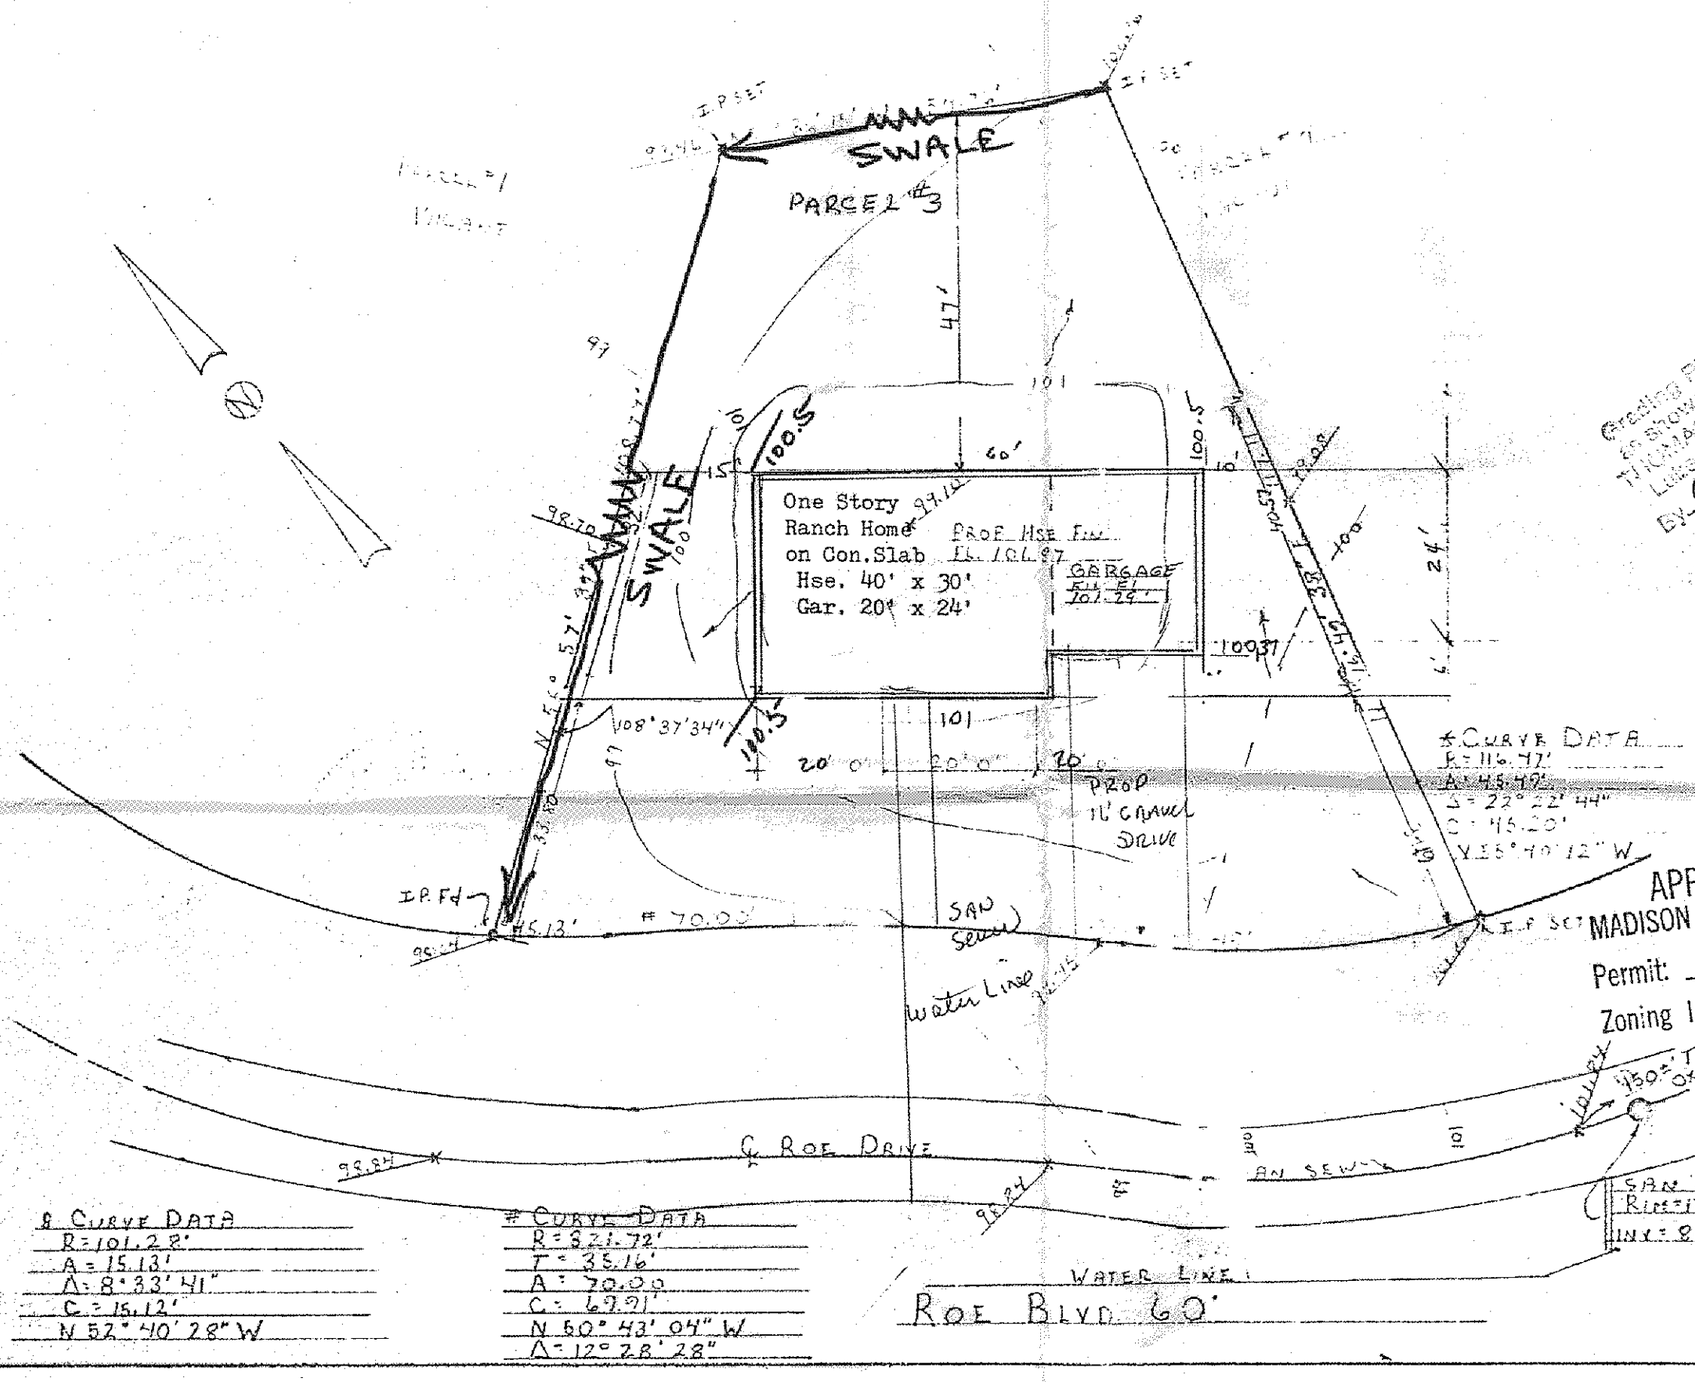

℄ CURVE DATA
R = 101.28'
A = 15.13'
Δ = 8°33'41"
C = 15.12'
N 52°40'28" W

# CURVE DATA
R = 321.72'
T = 35.16'
A = 70.00
C = 69.91'
N 50°43'04" W
Δ = 12°28'28"

APPROVED
MADISON TWP. ZONING
Permit: 10101
Zoning Inspector:

Grading Plan Approved as shown and/or noted
THOMAS P. CULLEN, P.E.
Lake County, Ohio
By

STATE OF OHIO
WM. R. GRAY
2752
REGISTERED
PROFESSIONAL SURVEYOR