Grading Plan Approved
as shown and/or noted
THOMAS P. GILLES, P.E.
Lake County Engineer

By [signature] Date 20 Nov 72

SITE PLAN
for
JOHN LUSTIG
SUBLOT 270 MADISON LAKELAND
MADISON TWP LAKE Co. O.
1" = 30' July 1972

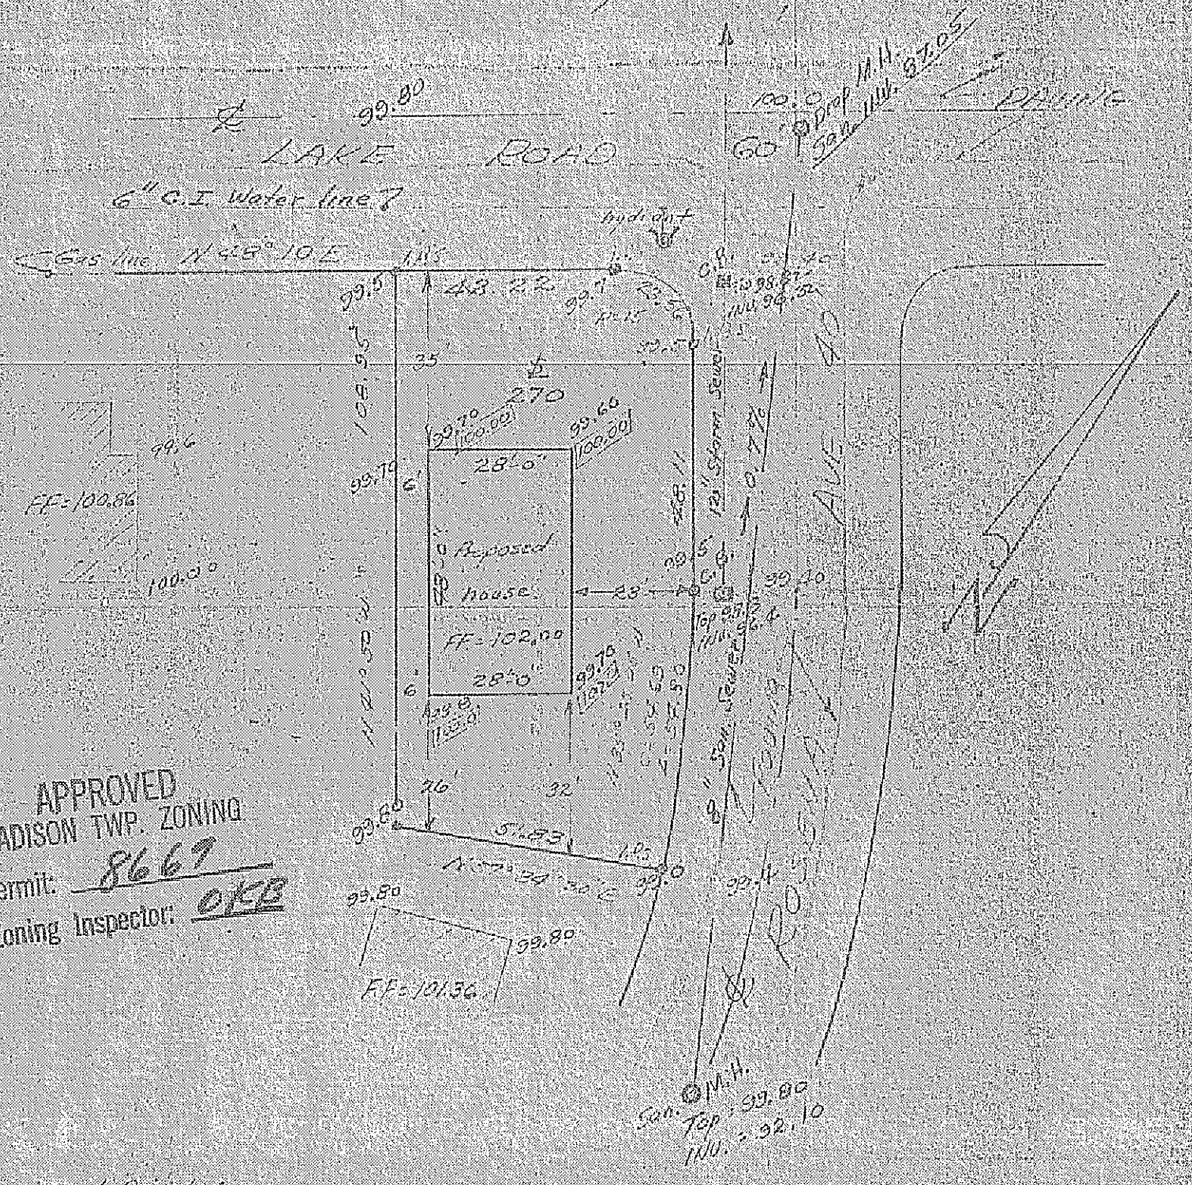

APPROVED
MADISON TWP. ZONING
Permit: 8669
Zoning Inspector: OKB

Certification —

I certify that the grades were checked on _____ day of _____ 1972 and were found as shown in red.

By _____

Milton M. Boomhouser
Reg. Surveyor #4247