08/01/94

KEVIN THOMPSON SITE PLAN
RIVER ROAD
MADISON TOWNSHIP

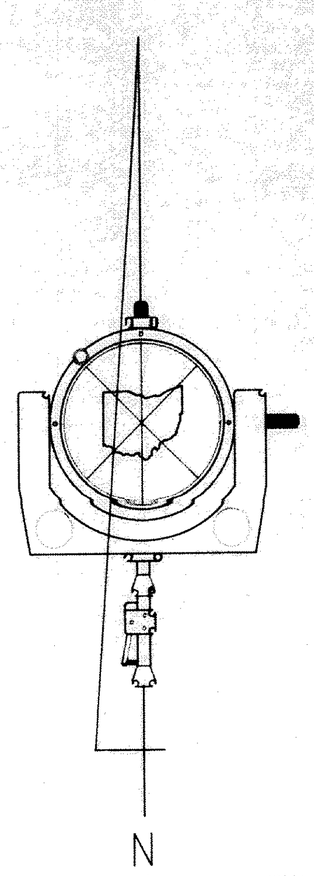

SCALE 1"=30'

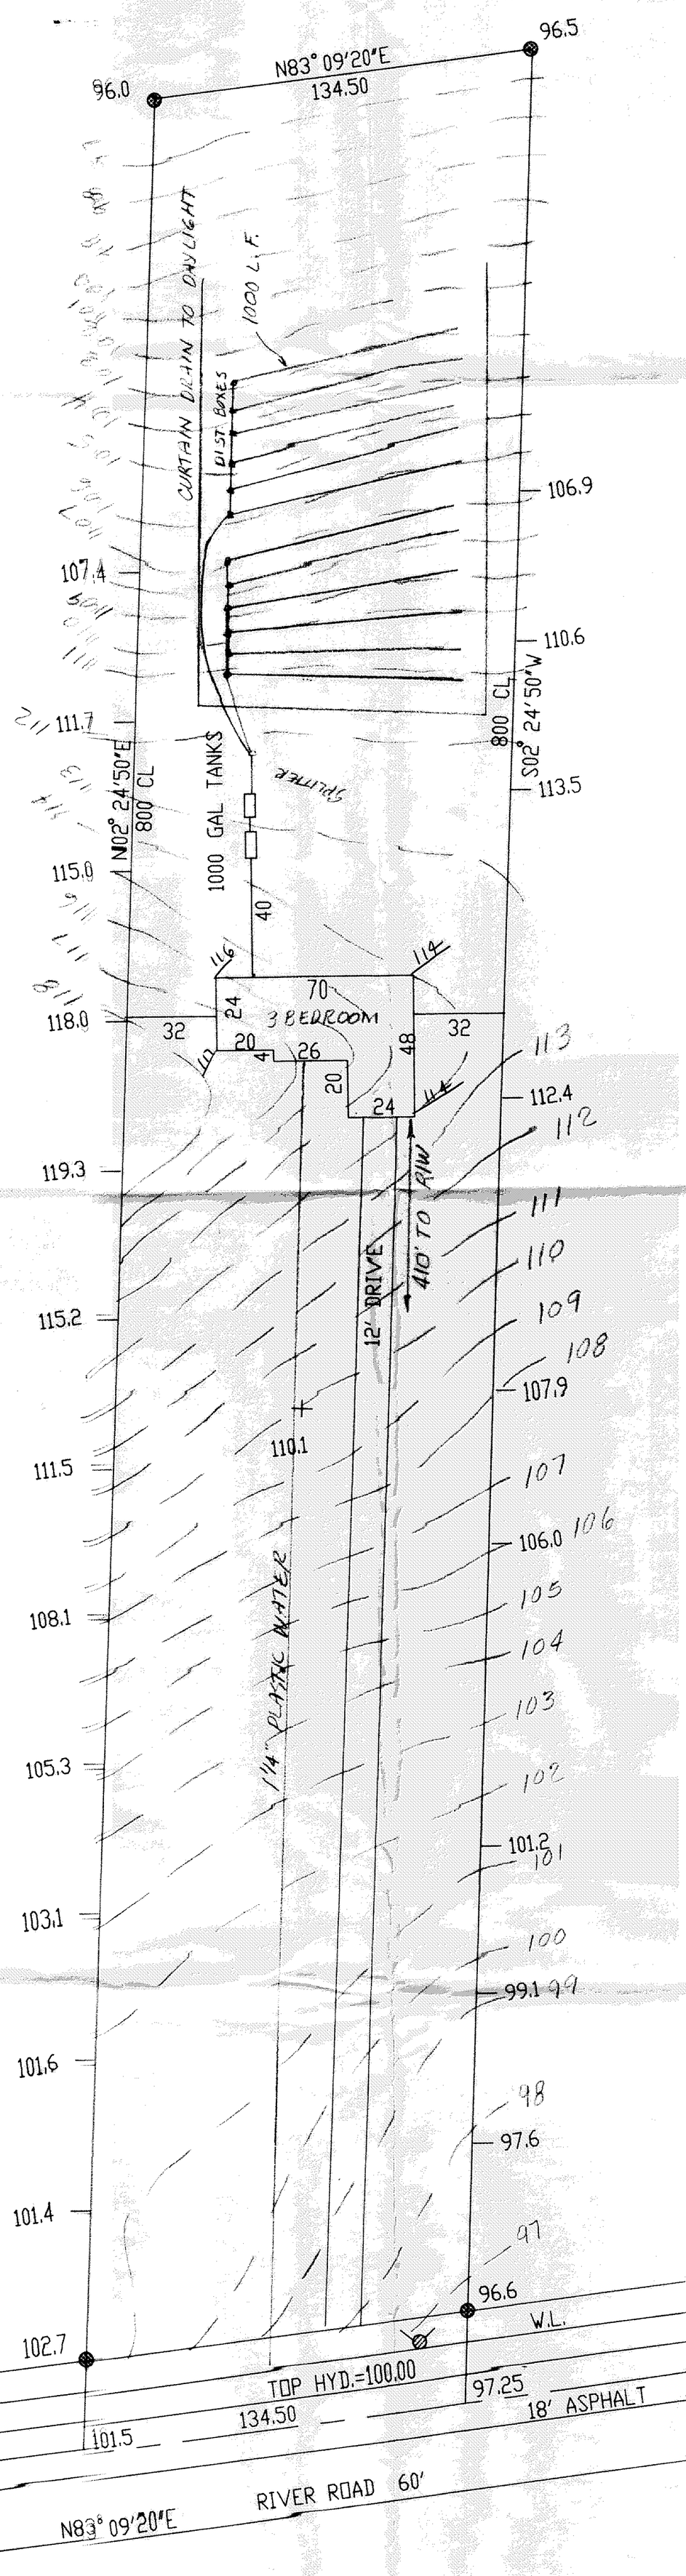

IRON PIN FOUND

Reviewed and Accepted
LAKE COUNTY GENERAL HEALTH DISTRICT
Date 8-3-94
Max drive & water line to east
JOEL LUCIA, R. S., M. P. H.
Health Commissioner
BY J. Lucia

SEWAGE DISPOSAL PERMIT MUST BE OBTAINED BY A LAKE COUNTY LICENSED INSTALLER BEFORE INSTALLATION IS STARTED.

A. To be brought to finished grade
1. Septic tank manhole covers
2. Splitter box cover
3. Distribution box cover

B. No footer drains or downspouts to be discharged into septic tanks
C. All waste water to be discharged into septic tanks

LOW YIELD WATER FIXTURES REQUIRED ON ALL:
__ Shower Head
__ Toilet
__ _____

Grading Plan Approved
as shown and/or noted
THOMAS P. GILLER, P.E.
Lake Co.
By GJH 8 8 94
12" MIN. DRIVE CULVERT

APPROVED
MADISON TWP. ZONING
Permit: 14263
Zoning Inspector: JDL
AUG. 03 1994

Jerry Slay
Ohio Surveyor Number 5298