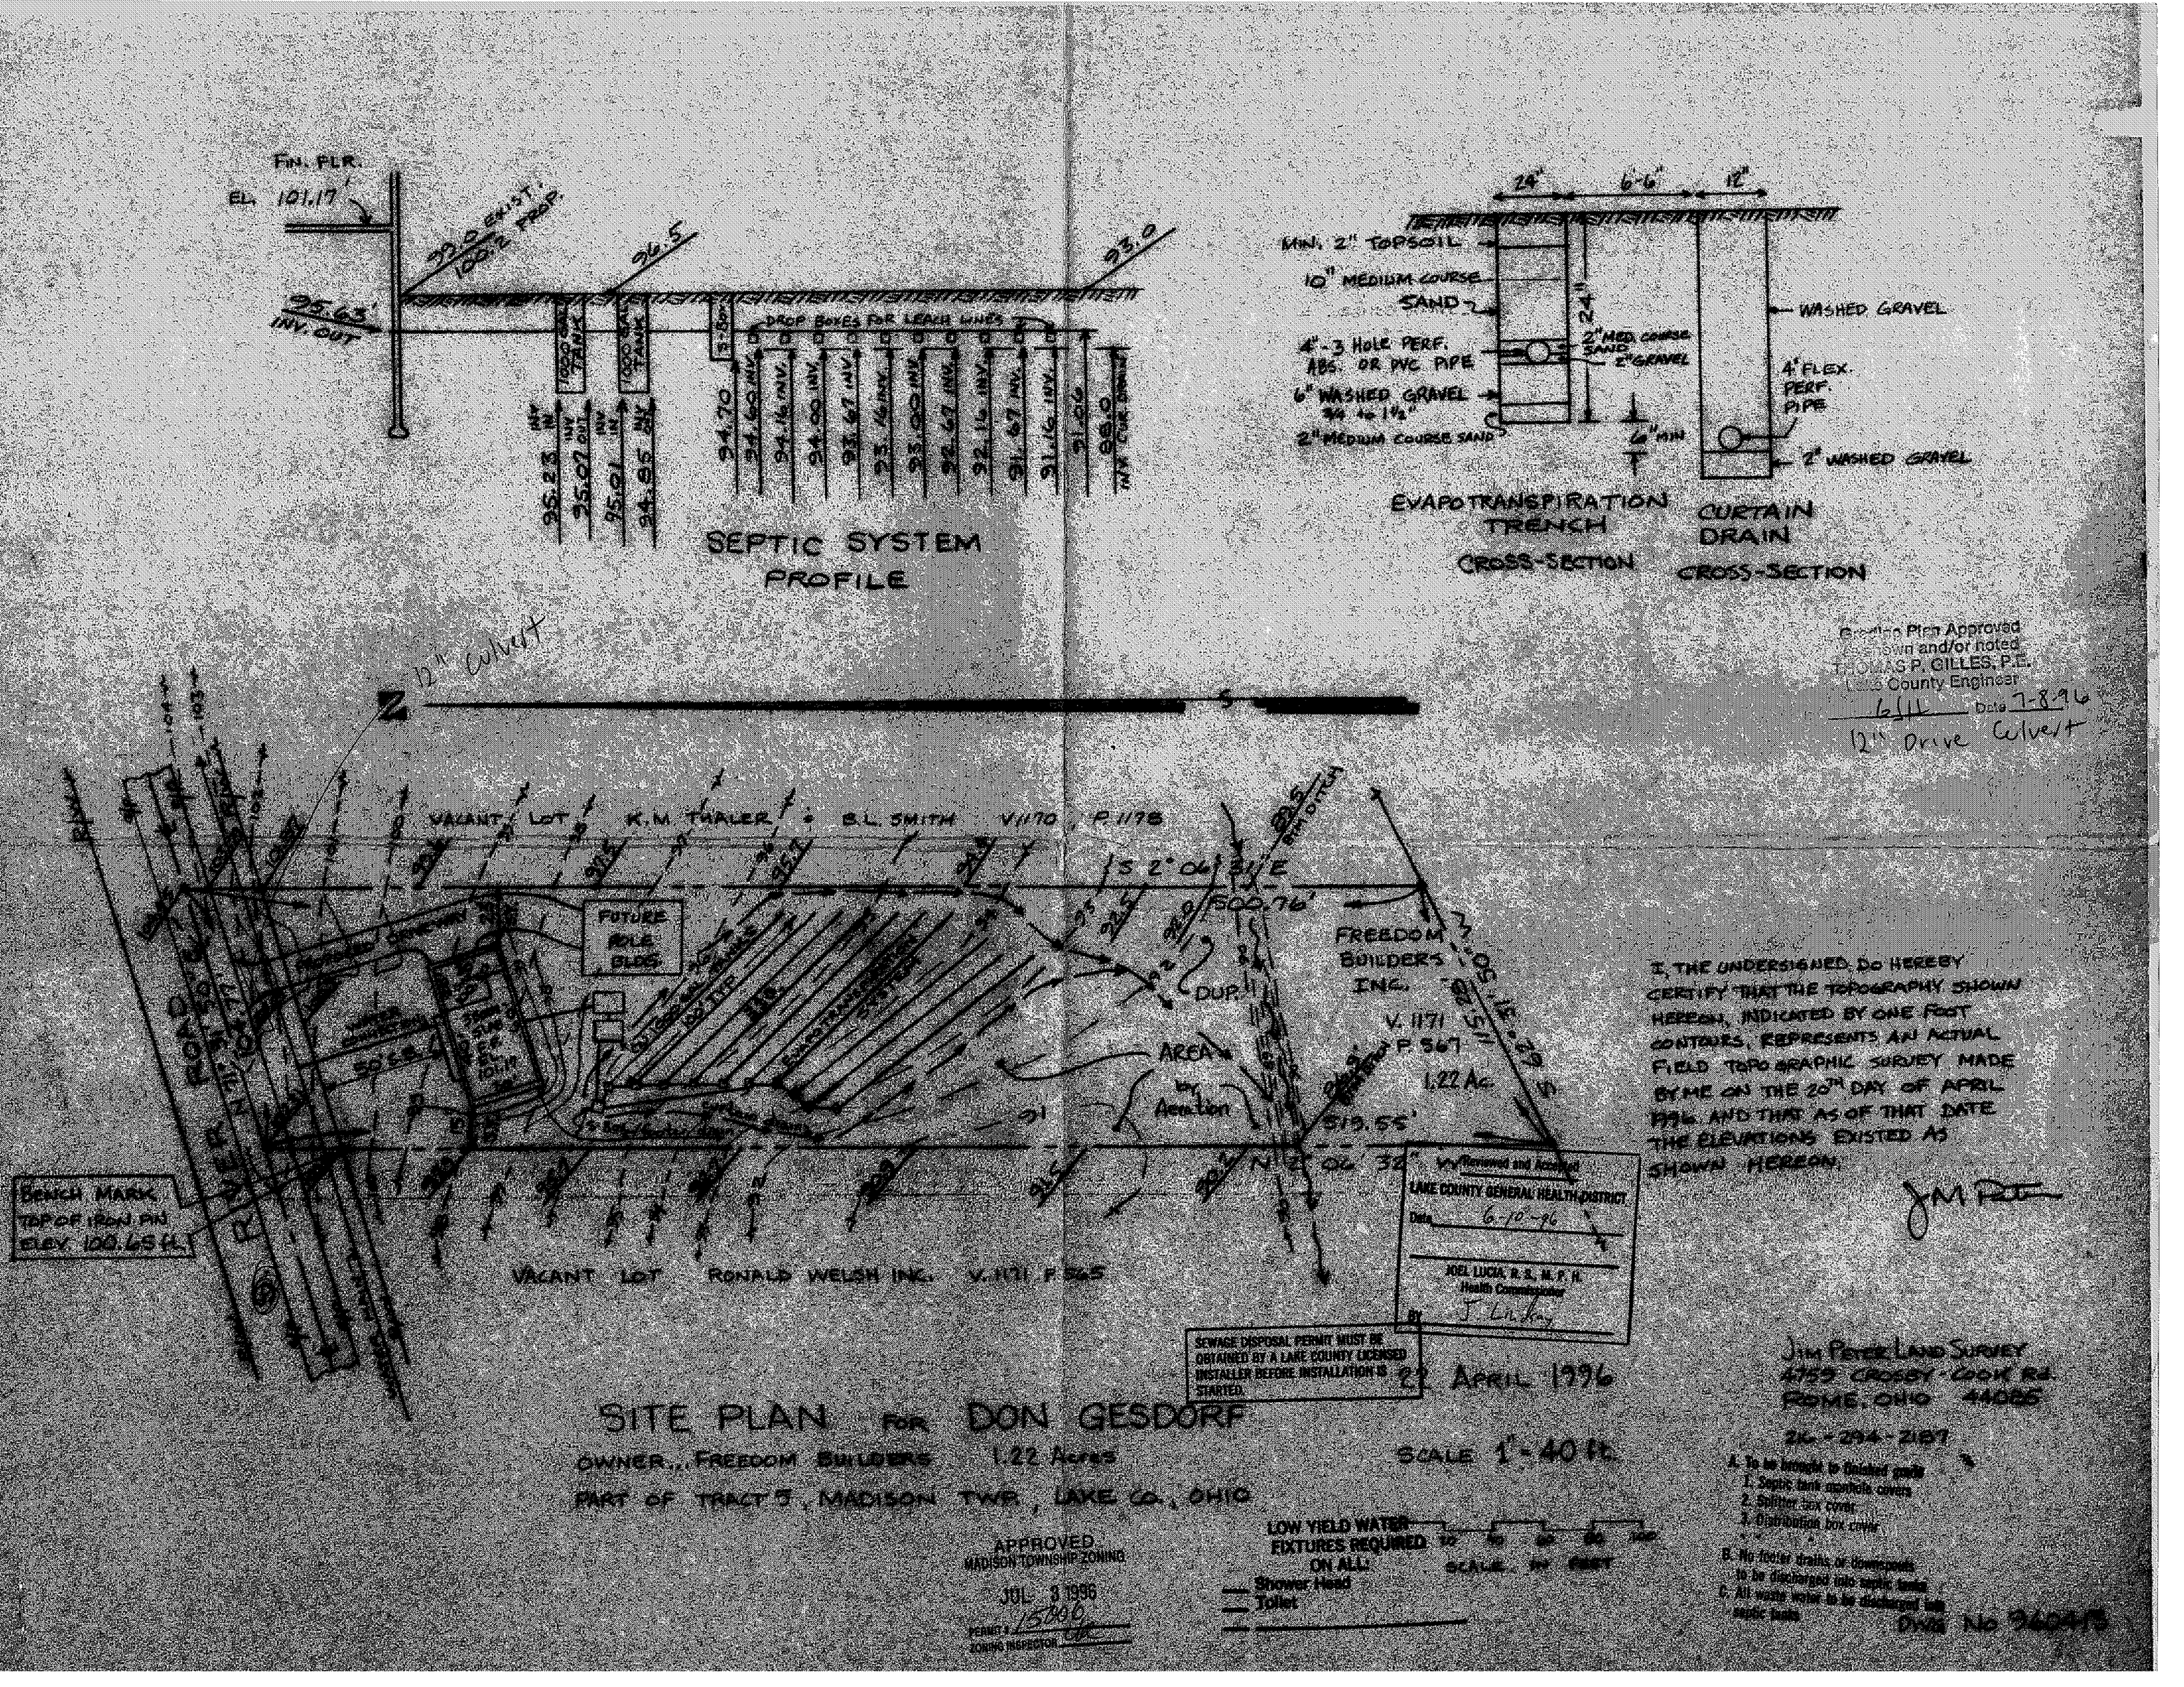

Grading Plan Approved
As shown and/or noted
THOMAS P. GILLES, P.E.
Lake County Engineer
6/11 Date 7-8-96
12" Drive Culvert

I, THE UNDERSIGNED, DO HEREBY CERTIFY THAT THE TOPOGRAPHY SHOWN HEREON, INDICATED BY ONE FOOT CONTOURS, REPRESENTS AN ACTUAL FIELD TOPOGRAPHIC SURVEY MADE BY ME ON THE 20TH DAY OF APRIL 1996 AND THAT AS OF THAT DATE THE ELEVATIONS EXISTED AS SHOWN HEREON.

JM Peter

Reviewed and Accepted
LAKE COUNTY GENERAL HEALTH DISTRICT
Date 6-10-96
JOEL LUCIA, R.S., M.P.H.
Health Commissioner
By J. Lindsay

SEWAGE DISPOSAL PERMIT MUST BE OBTAINED BY A LAKE COUNTY LICENSED INSTALLER BEFORE INSTALLATION IS STARTED.

22 APRIL 1996

SITE PLAN FOR DON GESDORF

OWNER... FREEDOM BUILDERS 1.22 Acres

PART OF TRACT 5, MADISON TWP., LAKE CO., OHIO

SCALE 1" = 40 ft.

APPROVED
MADISON TOWNSHIP ZONING
JUL 3 1996
PERMIT # 15000
ZONING INSPECTOR

LOW YIELD WATER FIXTURES REQUIRED ON ALL:
— Shower Head
— Toilet

SCALE IN FEET

JIM PETER LAND SURVEY
4759 CROSBY-COOK RD.
ROME, OHIO 44085
216-294-2187

A. To be brought to finished grade
1. Septic tank manhole covers
2. Splitter box cover
3. Distribution box cover
B. No footer drains or downspouts to be discharged into septic tanks
C. All waste water to be discharged into septic tanks

DWG No 960413