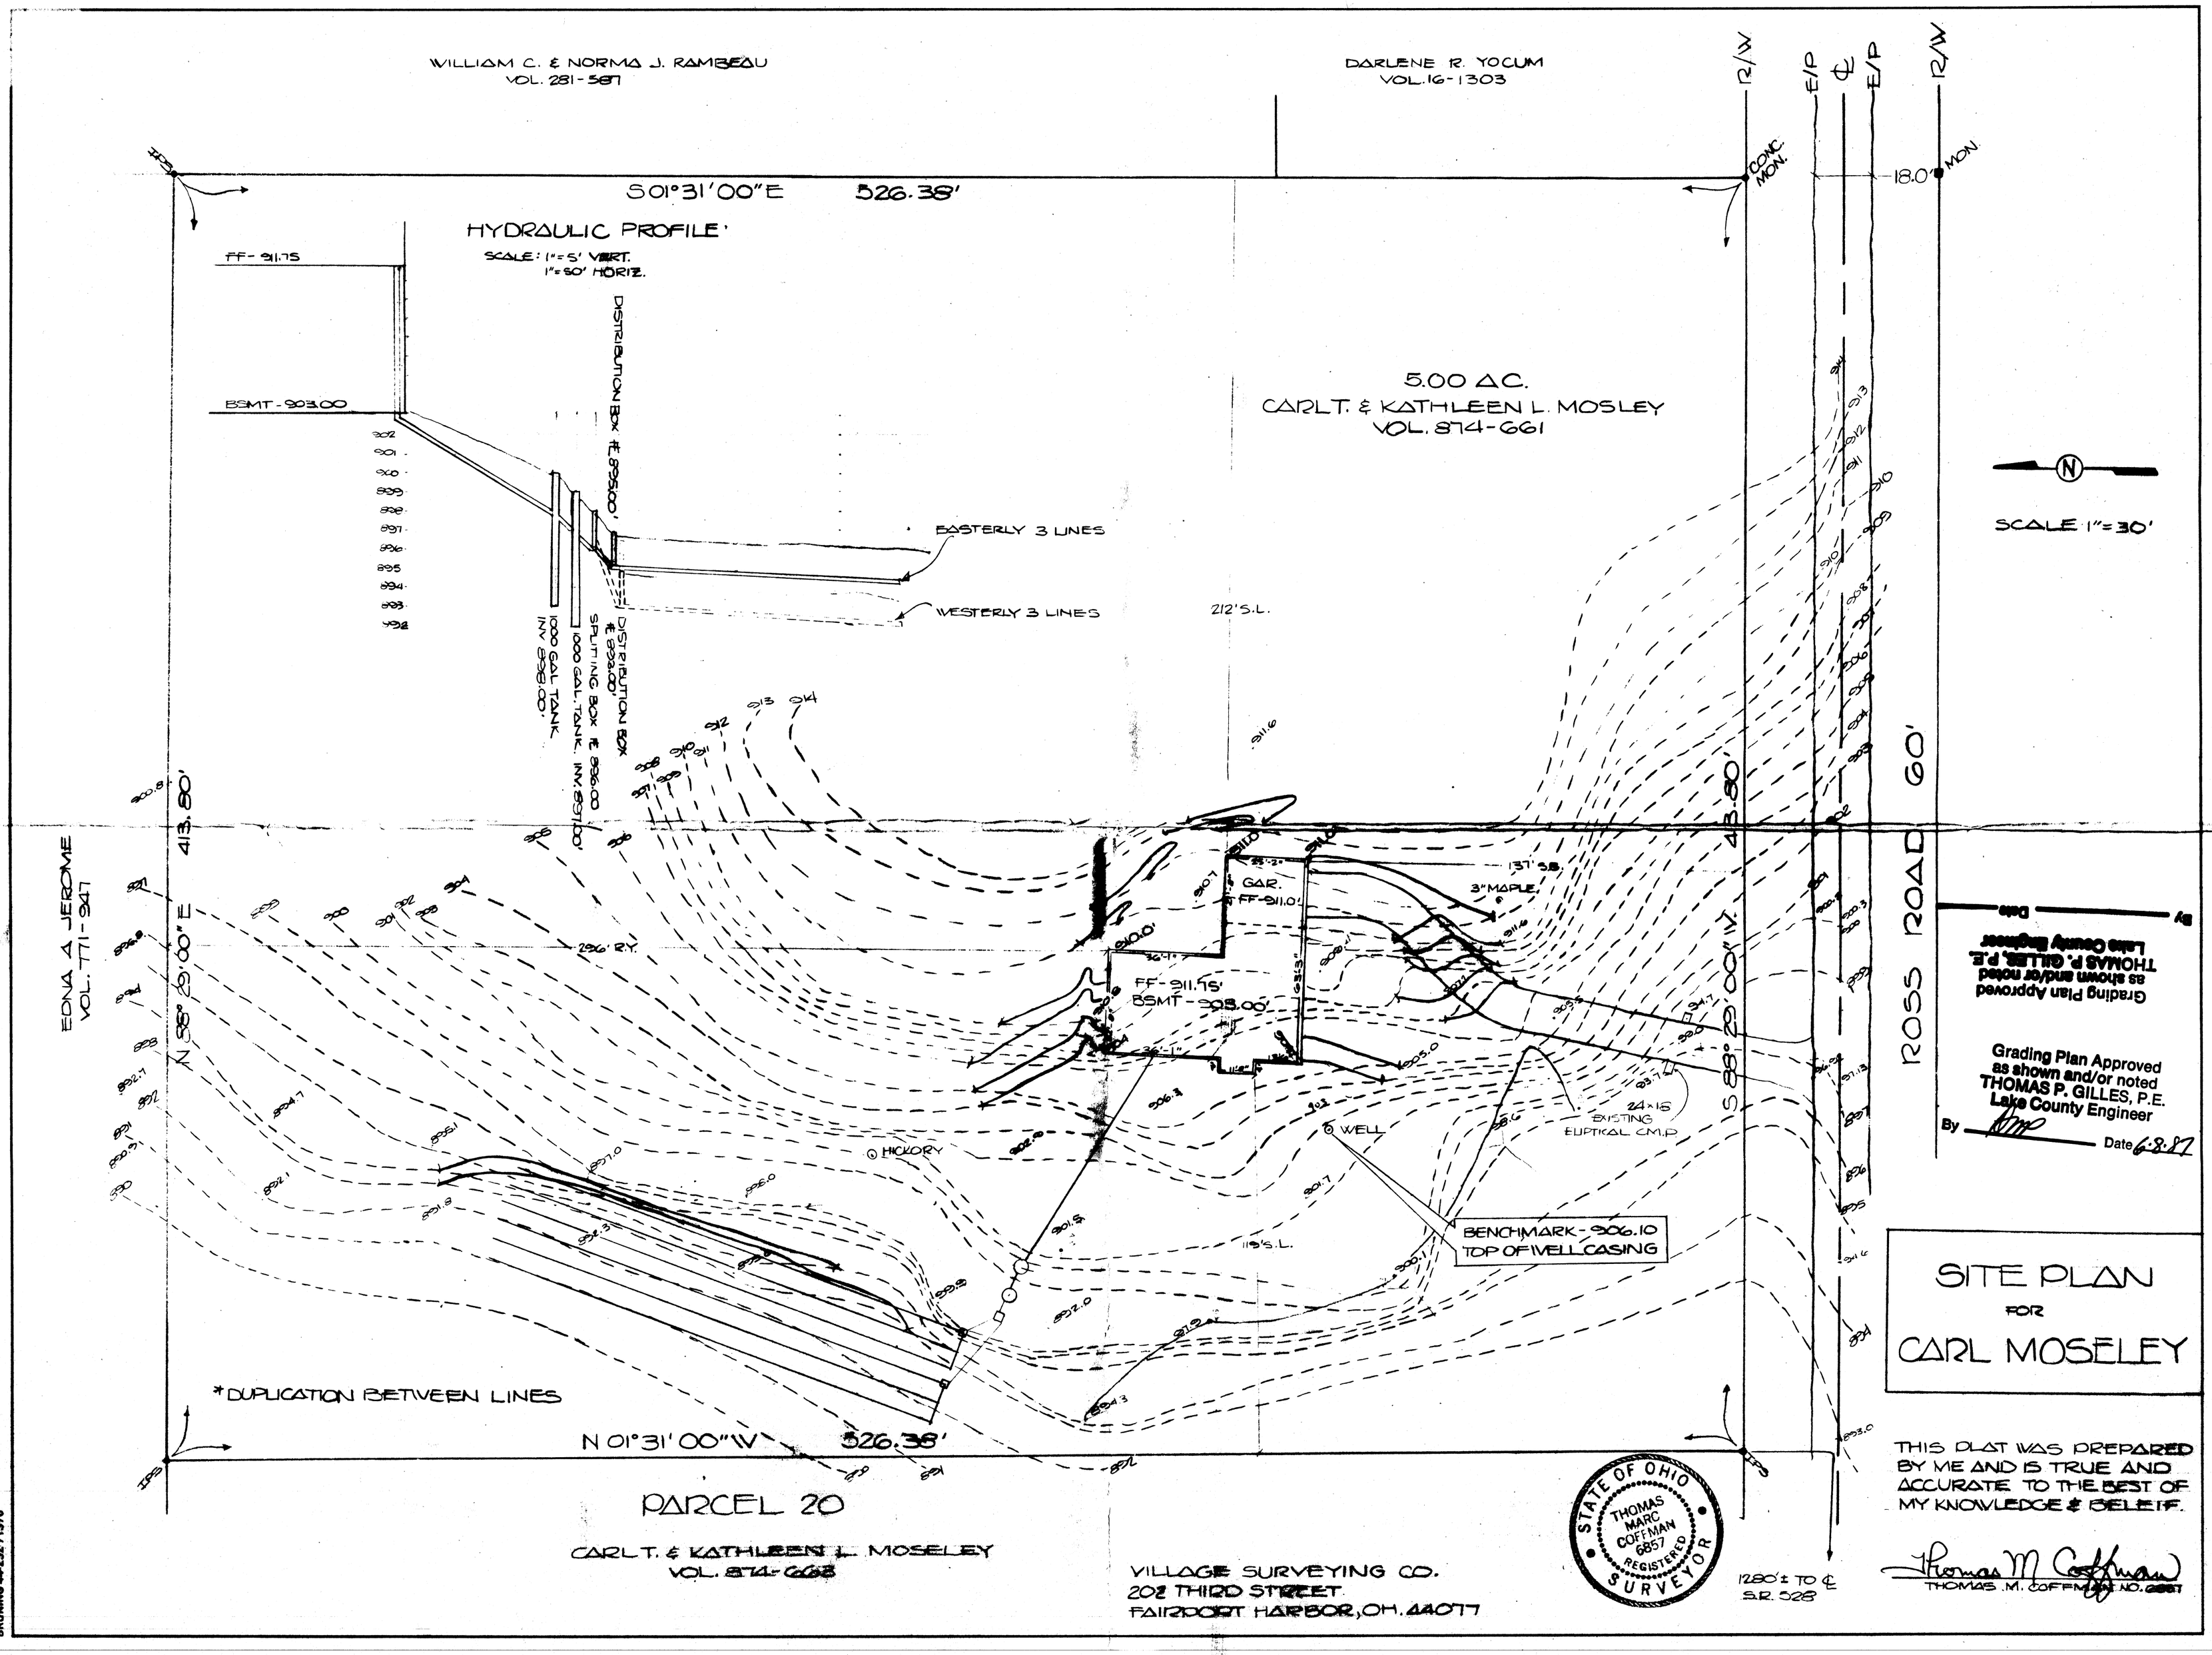

WILLIAM C. & NORMA J. RAMBEAU
VOL. 281-587
DARLENE R. YOCUM
VOL. 16-1303
R/W
E/P
℄
E/P
R/W
CONC. MON.
18.0'
MON.
S01°31'00"E 526.38'
HYDRAULIC PROFILE
SCALE: 1"=5' VERT.
1"=50' HORIZ.
FF-911.75
BSMT-903.00
DISTRIBUTION BOX ℄ 895.00'
EASTERLY 3 LINES
WESTERLY 3 LINES
1000 GAL TANK INV 898.00'
1000 GAL. TANK. INV. 897.00'
SPLITTING BOX ℄ 896.00
DISTRIBUTION BOX ℄ 893.00'
5.00 AC.
CARL T. & KATHLEEN L. MOSLEY
VOL. 874-661
212' S.L.
SCALE 1"=30'
N
EDNA A JEROME
VOL. 771-947
N 88°29'00"E 413.80'
S 88°29'00"W 413.80'
ROSS ROAD 60'
GAR.
FF-911.0'
FF-911.75'
BSMT-903.00'
3" MAPLE
137' S.B.
296' R.Y.
HICKORY
WELL
24x16 EXISTING ELIPTICAL C.M.P.
BENCHMARK-906.10
TOP OF WELL CASING
119' S.L.
*DUPLICATION BETWEEN LINES
N 01°31'00"W 526.38'
PARCEL 20
CARL T. & KATHLEEN L. MOSELEY
VOL. 874-663
VILLAGE SURVEYING CO.
202 THIRD STREET
FAIRPORT HARBOR, OH. 44077
STATE OF OHIO
THOMAS MARC COFFMAN 6857
REGISTERED SURVEYOR
1280'± TO ℄
S.R. 528
Grading Plan Approved as shown and/or noted
THOMAS P. GILLES, P.E.
Lake County Engineer
By
Date 6-8-87
SITE PLAN
FOR
CARL MOSELEY
THIS PLAT WAS PREPARED BY ME AND IS TRUE AND ACCURATE TO THE BEST OF MY KNOWLEDGE & BELIEF.
THOMAS M. COFFMAN NO. 6857
BRUNING 44-232 71376