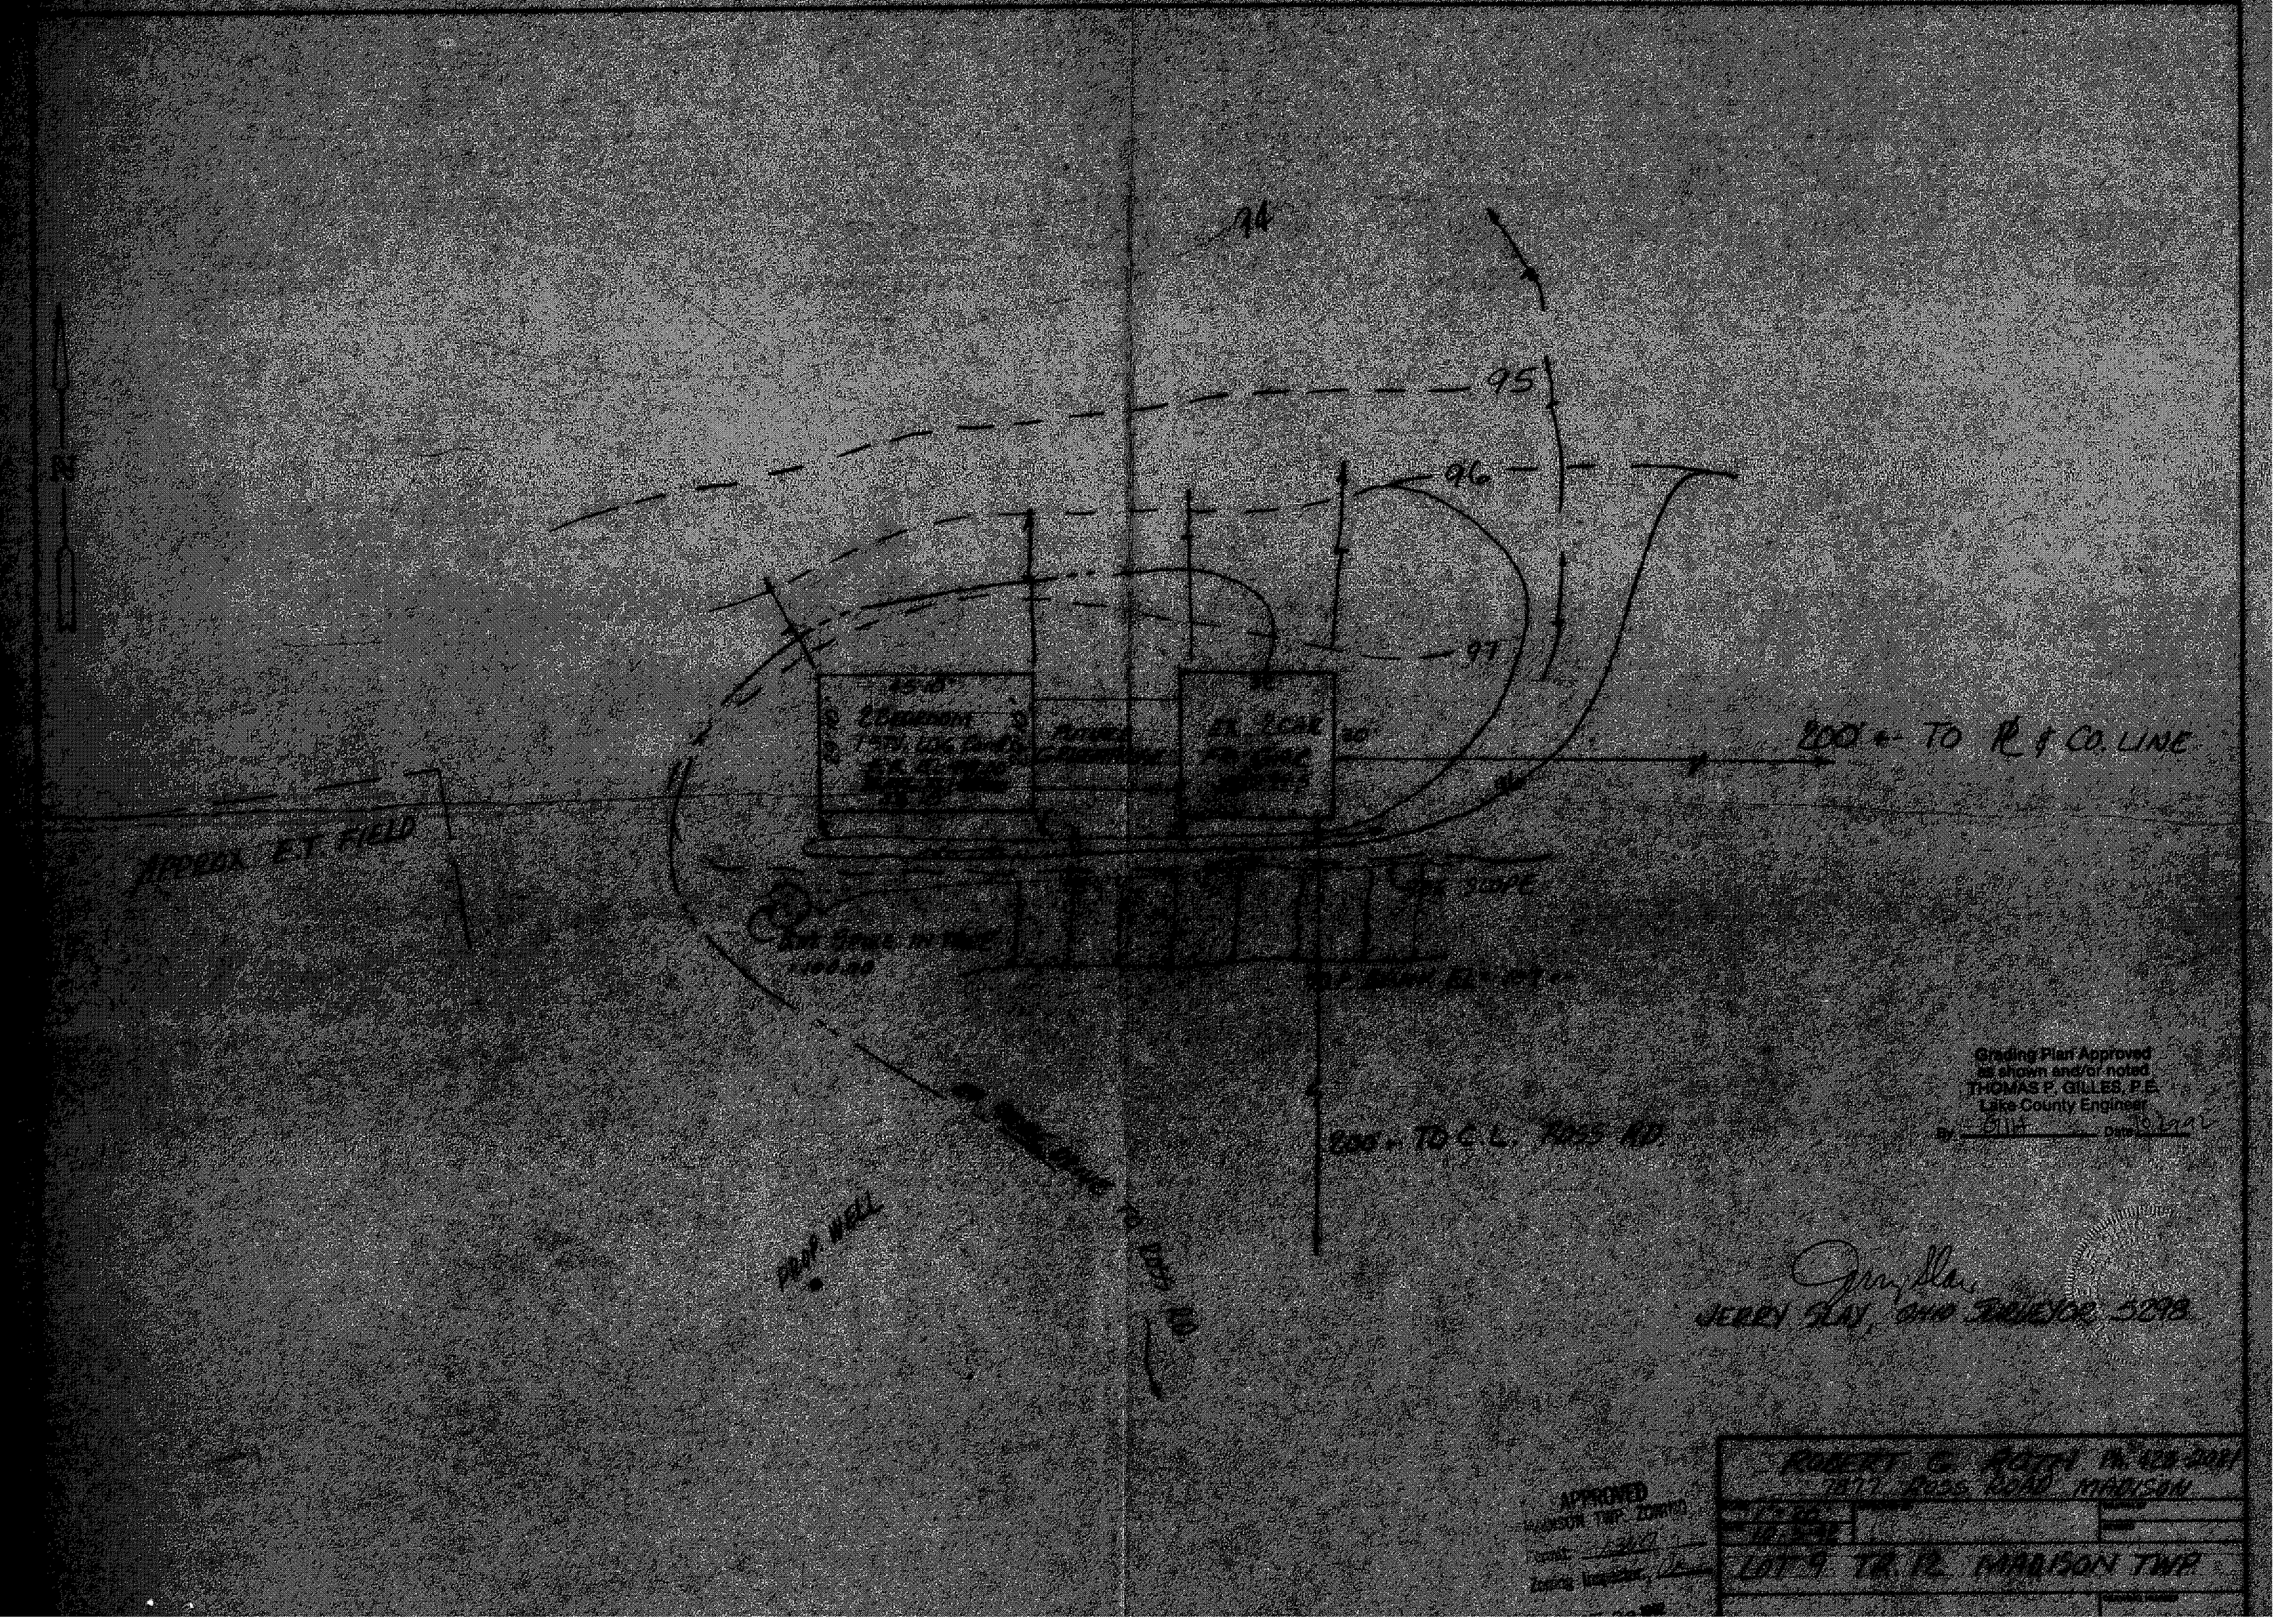
94
95
96
97
200' ← TO ℄ & CO. LINE
APPROX. E.T. FIELD
SCOPE
200' ← TO C.L. ROSS RD.
PROP. WELL
Grading Plan Approved
as shown and/or noted
THOMAS P. GILLES, P.E.
Lake County Engineer
By
Date
JERRY SLAY, OHIO SURVEYOR 5298
APPROVED
MADISON TWP. ZONING
Permit
Zoning Inspector
ROBERT G. ROTH
7877 ROSS ROAD MADISON
LOT 9 TR. 12 MADISON TWP.