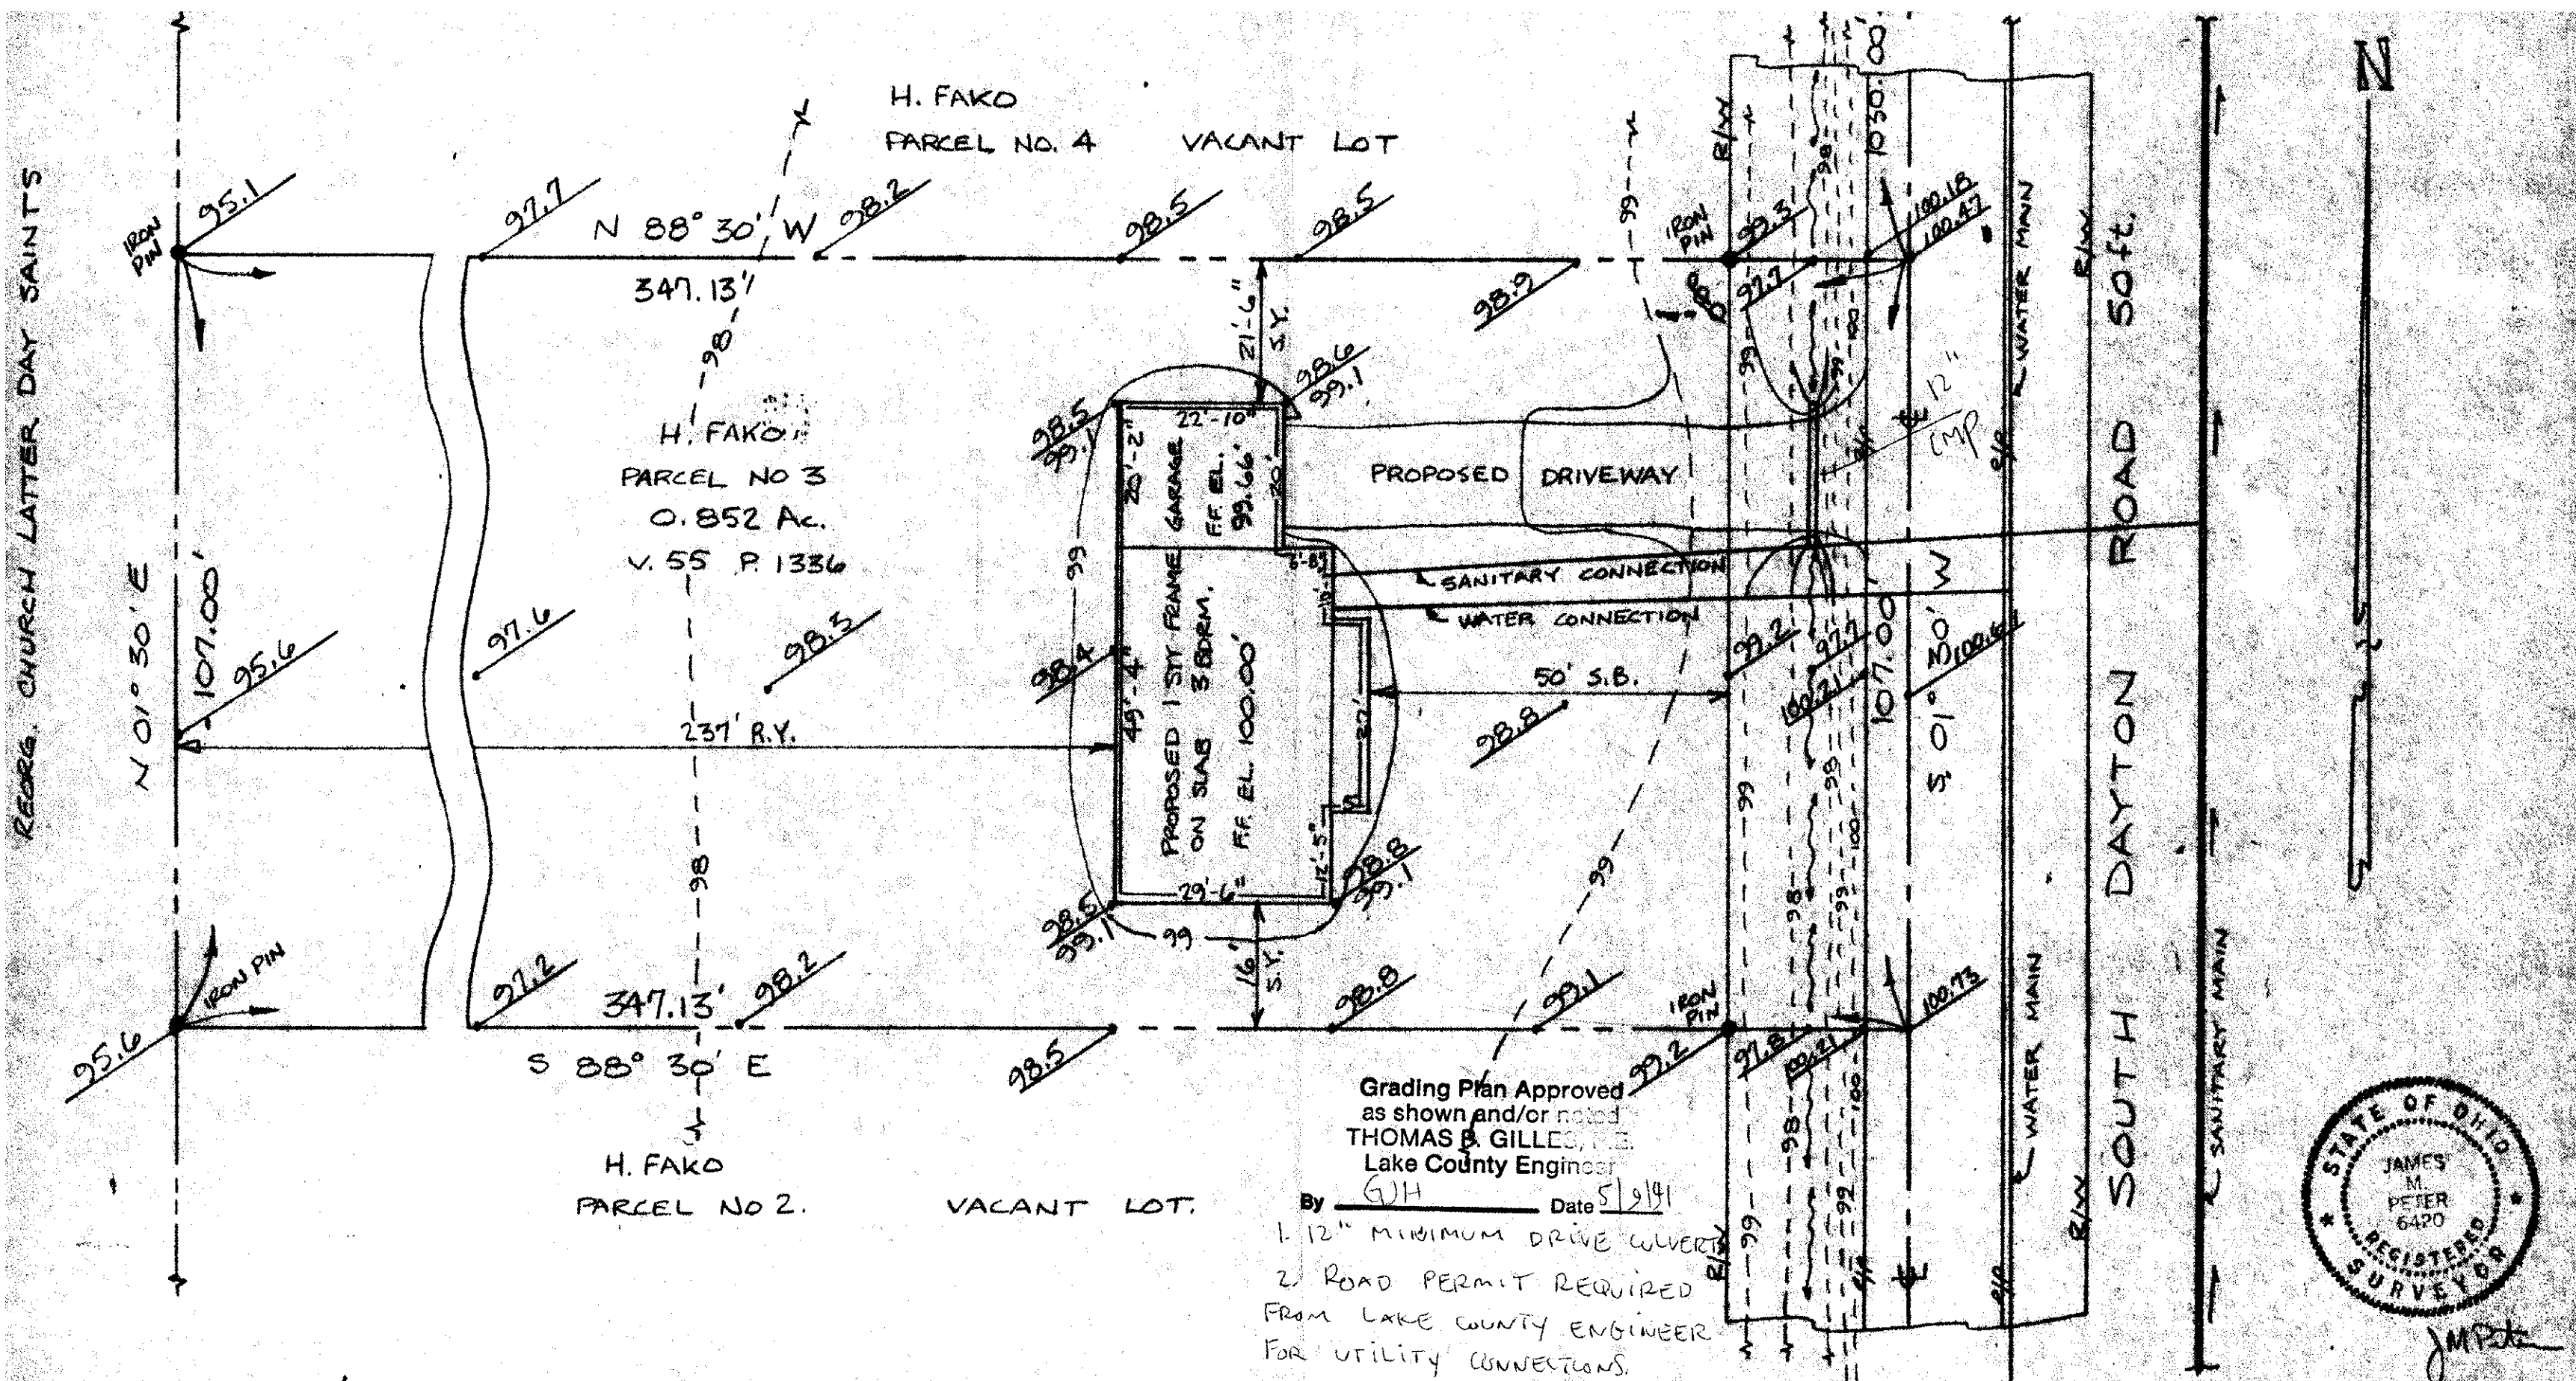

Grading Plan Approved
as shown and/or noted
THOMAS B. GILLES, P.E.
Lake County Engineer
By GJH Date 5/9/91

1. 12" MINIMUM DRIVE CULVERT
2. ROAD PERMIT REQUIRED FROM LAKE COUNTY ENGINEER FOR UTILITY CONNECTIONS.

STATE OF OHIO
JAMES M. PETER
6420
REGISTERED SURVEYOR

JMP

SITE PLAN FOR HILDA FAKO
LOT NO. 13 TRACT NO 3 MADISON TWP.
LAKE COUNTY, OHIO
18 APRIL 1991

JIM PETER LAND SURVEY
4759 CROSBY-COOK RD.
ROME, OHIO 44085