SITE PLAN

MADISON — TOWNSHIP — LAKE COUNTY, OHIO

for: WINSLOW HOMES — CLIENT — OWNER

ADDRESS — STREET — CITY — ZIP

MADISON GOLF LAKELANDS — RECORD SUBDIVISION	LOT — TRACT
E — VOLUME	68 — PAGE
1224 — SUBLOT NO	SELKIRK DR — STREET
VOLUME — PERM PARCEL NO	PAGE — STREET

APPROVED
MADISON TWP. ZONING
Permit: 8408
Zoning Inspector:

Grading Plan Approved as shown
Thomas P. Hilker P.E.
Lake County Engr
By [illegible] 19 April 72

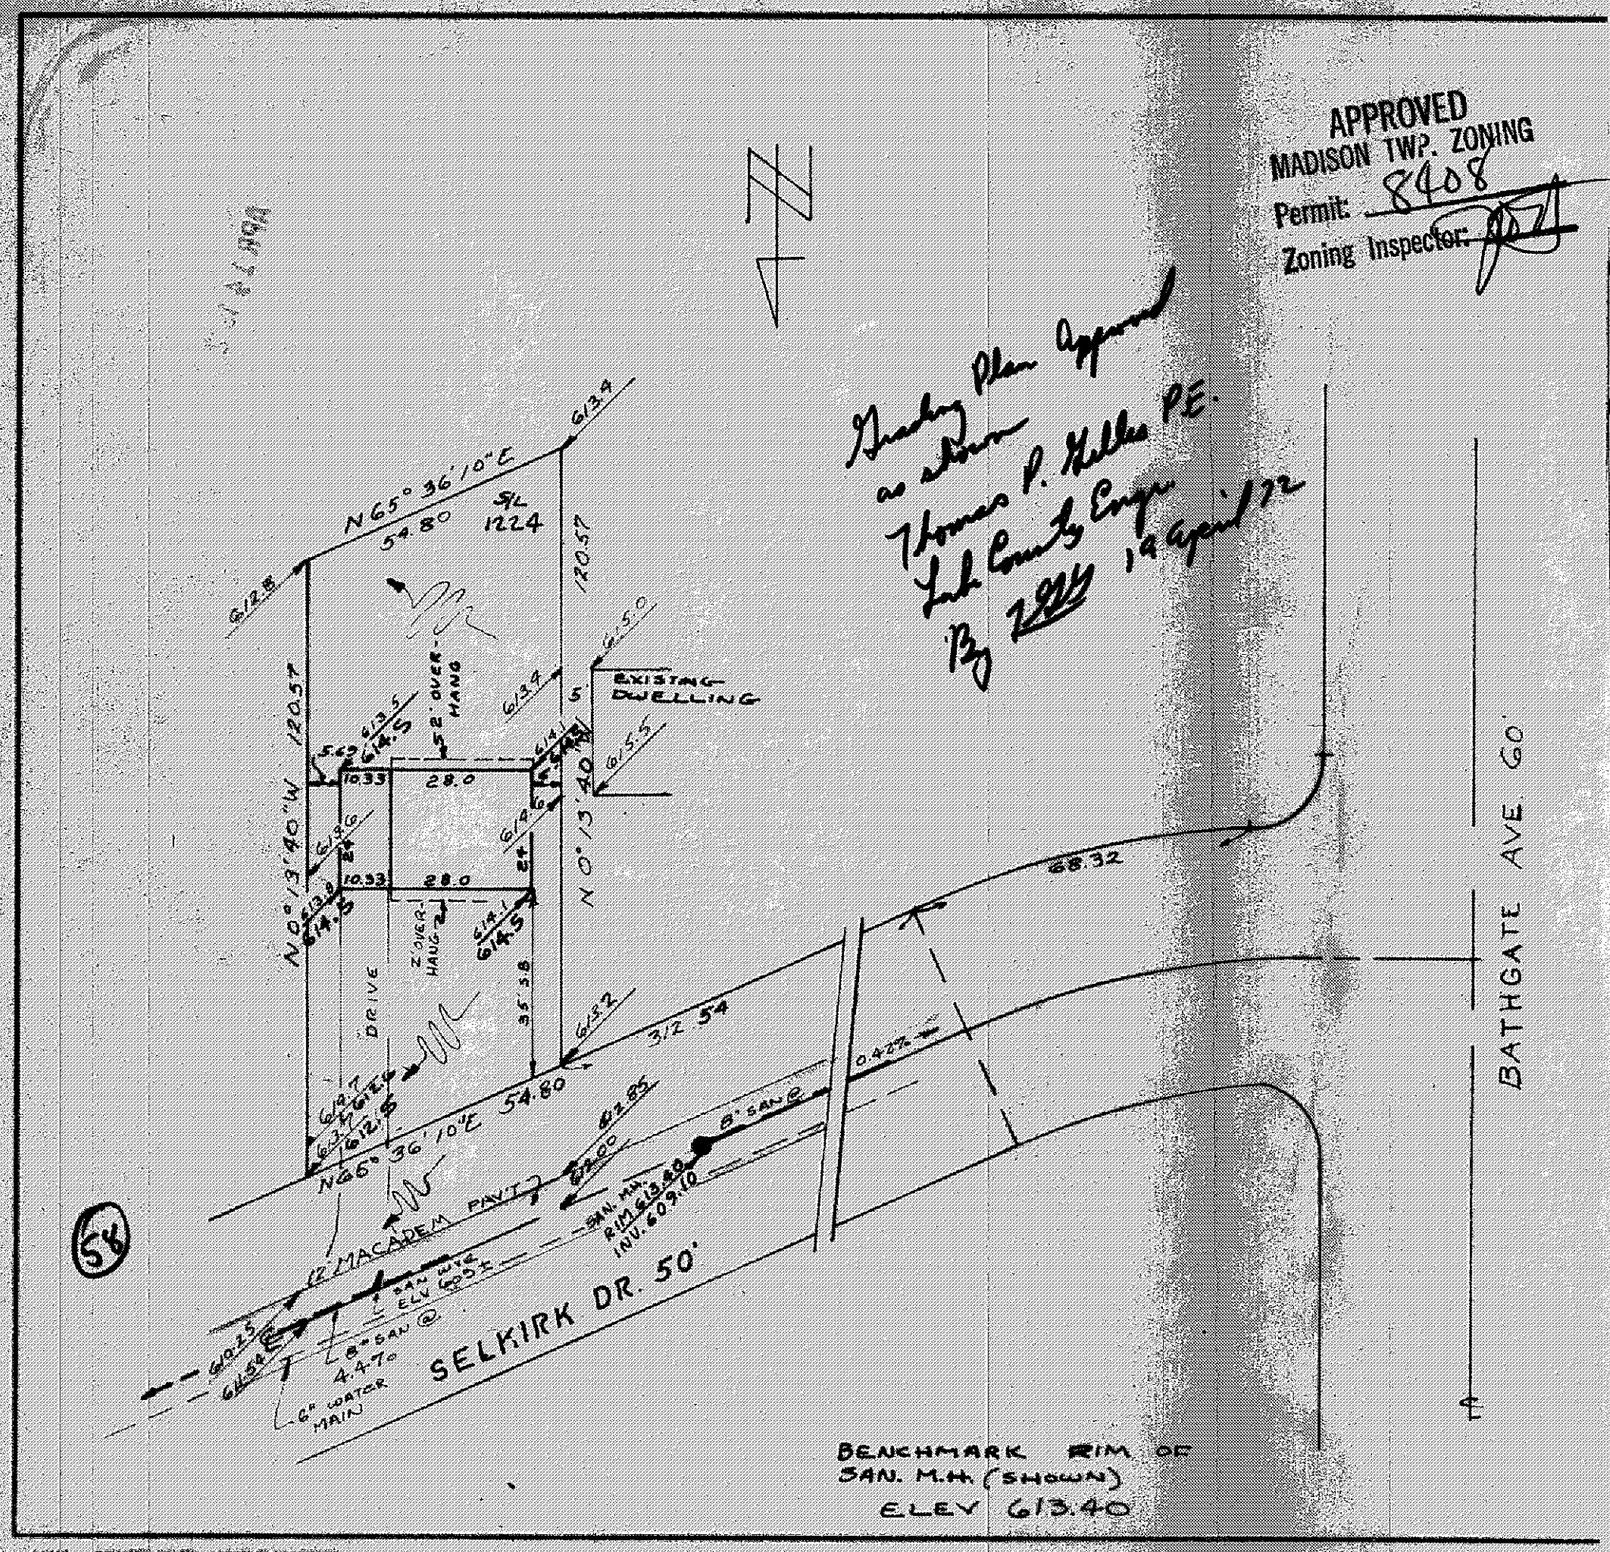

LEGEND

SANITARY MANHOLE
STORM MANHOLE
INLET OR CATCH BASIN
HYDRANT
EXISTING CONTOURS
PROPOSED CONTOURS
EXIST. ELEV. 100.0
100.0 PROP. ELEV.
WATER VALVE (GAS)
WATER METER (GAS)
AS BUILT ELEVATION
DIRECTION OF SURFACE DRAINAGE

REMARKS

ALL BOUNDARY DATA SHOWN WAS OBTAINED FROM (DEEDS, RECORDED SUBDIVISION PLAT, OR OTHER PUBLIC RECORDS)

DESIGN CERTIFICATION

THIS PLAT WAS PREPARED BY ME, AND IS CORRECT TO THE BEST OF MY KNOWLEDGE AND BELIEF.

Richard J. Bilaki — PS # 5244

NAME — SURVEYOR — REGISTRATION NO.

CHECK LIST

DIMENSIONS
BEARINGS
TIE TO NEAREST STREET
SUBLOT NO. PARCEL NO
SURROUNDING OWNERS
BLDG DIMENSIONS FIN GR
BLDG TIES FLR GRADES
APRON TYPE WIDTH THICKNESS
SIDEWALK TYPE WIDTH THICKNESS
CULVERT TYPE DIA LENGTH

WATER MAIN SIZE LOCATION
SAN SEWER SIZE % GR. LOC.
SAN M.H. CAST ELEV. INV. ELEV.
SAN CONN SIZE LOC. DEPTH
STORM SEWER SIZE % GR. LOC.
STORM MH. CAST ELEV. INV. ELEV.
PAVT. TYPE GRADE CURBS
GAS LINE LOC SIZE PRESSURE
SEPTIC TANK SIZE LOC.
WELL LOCATION

REVISIONS		
NO	DATE	BY
1	4/14/72	RJB
2		
3		
4		
5		

PLAN PREPARED BY:

DEBELVEC-SALO & ASSOC, INC.
CIVIL ENGINEERS - SURVEYORS — NAME
130 E. JACKSON ST PAINESVILLE, O. — ADDRESS

DRAWN BY W.B.	SCALE 1" = 30	PHONE NO
CHK'D	DATE 3/72	DRAWING NO 3574-1224
CREW CHIEF	APP'D	

(58)