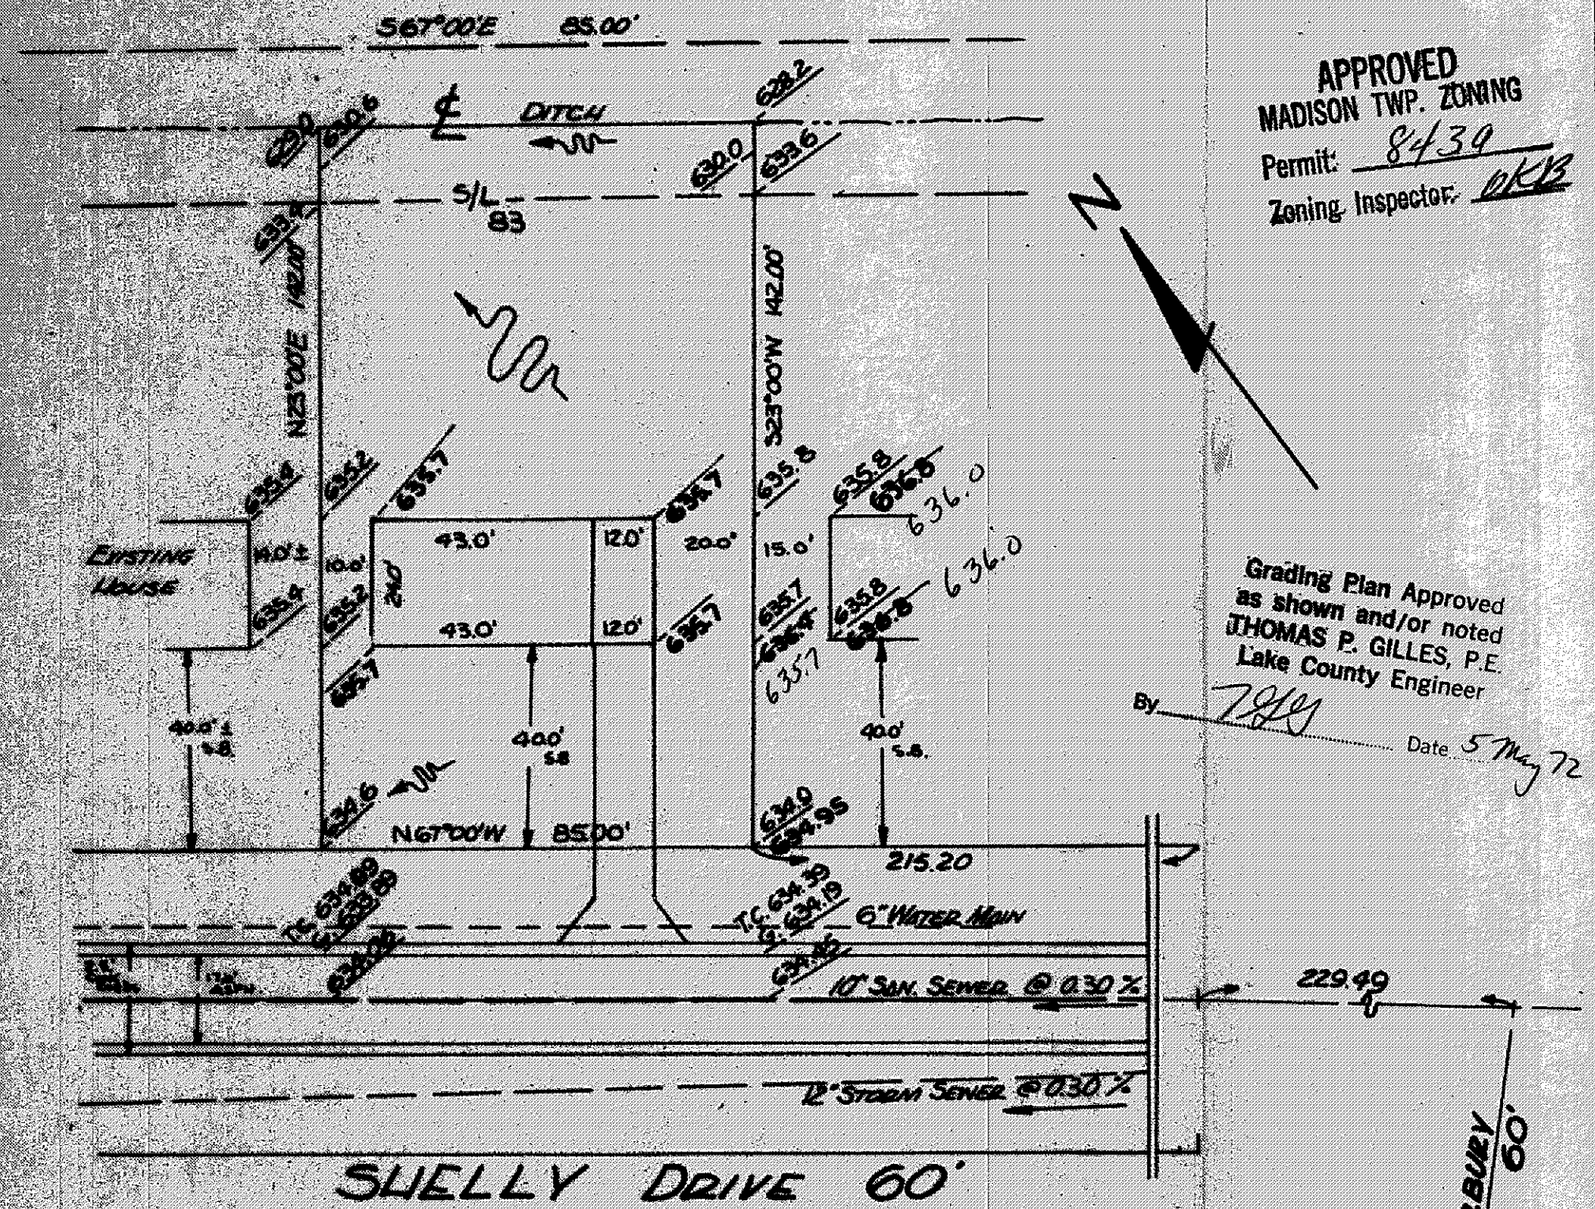

APPROVED
MADISON TWP. ZONING
Permit: 8439
Zoning Inspector: OKB

Grading Plan Approved
as shown and/or noted
THOMAS P. GILLES, P.E.
Lake County Engineer
By TPG
Date 5 May 72

SITE PLAN

MADISON (TOWNSHIP) LAKE COUNTY, OHIO

for HALLMARK BLDRS (CLIENT OWNER)

6843 Shelly Dr. Madison 44057
ADDRESS STREET CITY ZIP

RECORD SUBDIVISION: CHAPEL GROVE	LOT:
VOLUME: O	TRACT:
PAGE: 14	VOLUME:
SUBLOT NO.: 83	PAGE:
STREET: SUELLY	PERM PARCEL #:
	STREET:

LEGEND

SANITARY MANHOLE
STORM MANHOLE
INLET OR CATCH BASIN
HYDRANT
EXISTING CONTOURS
PROPOSED CONTOURS
EXIST. ELEV. 100.0
100.0 PROP. ELEV.
WATER VALVE (GAS)
WATER METER (GAS)
AS BUILT ELEVATION
DIRECTION OF SURFACE DRAINAGE

REMARKS

ALL BOUNDARY DATA SHOWN WAS OBTAINED FROM (DEEDS, RECORDED SUBDIVISION PLAT, OR OTHER PUBLIC RECORDS)

DESIGN CERTIFICATION

THIS PLAT WAS PREPARED BY ME, AND IS CORRECT TO THE BEST OF MY KNOWLEDGE AND BELIEF.

Michael J. Balo PS #5244
NAME SURVEYOR REGISTRATION NO.

CHECK LIST

DIMENSIONS
BEARINGS
TIE TO NEAREST STREET
SUBLOT NO PARCEL NO
SURROUNDING OWNERS
BLDG DIMENSIONS FIN GR
BLDG TIES FLR GRADES
APRON TYPE WIDTH THICKNESS
SIDEWALK TYPE WIDTH THICKNESS
CULVERT TYPE DIA LENGTH
WATER MAIN SIZE LOCATION
SAN SEWER SIZE % GR. LOC.
SAN M.H. CAST ELEV. INV. ELEV.
SAN. CONN. SIZE LOC. DEPTH
STORM SEWER SIZE % GR. LOC.
STORM MH. CAST ELEV. INV. ELEV.
PAVT TYPE GRADE CURBS
GAS LINE LOC SIZE PRESSURE
SEPTIC TANK SIZE LOC
WELL LOCATION

"AS BUILT" CERTIFICATION

I, HEREBY CERTIFY THAT THE CIRCLED GRADES ARE EXISTING FINISH GRADES CHECKED IN FIELD ON _____ 19__ BY _____ SURVEYING AND ARE CORRECT TO THE BEST OF MY KNOWLEDGE AND BELIEF

REGISTERED SURVEYOR _____ NO. _____

REVISIONS		
NO	DATE	BY
1		
2		
3		
4		
5		

PLAN PREPARED BY:
DEBEVEC-SALO & ASSOC, INC.
CIVIL ENGINEERS - SURVEYORS NAME
130 E. JACKSON ST PAINESVILLE, O.
ADDRESS

DRAWN BY SWARTZ	SCALE 1"=30'	PHONE NO.
CHK'D	DATE 5-2-72	DRAWING NO. 3609-83
CREW CHIEF	APP'D	