SITE PLAN

MADISON TOWNSHIP — LAKE COUNTY, OHIO

for HALLMARK BLDRS
CLIENT — OWNER

ADDRESS — STREET — CITY — ZIP

CHAPEL GROVE SUBD
RECORD SUBDIVISION

"O" — 14'
VOLUME — PAGE

77 — SHELLY DRIVE
SUBLOT NO — STREET

LOT — TRACT
VOLUME — PAGE
PERM PARCEL # — STREET

Grading Plan Approved
as shown and/or noted
THOMAS P. GILLES, P.E.
Lake County Engineer
By _____ Date 5-2-72

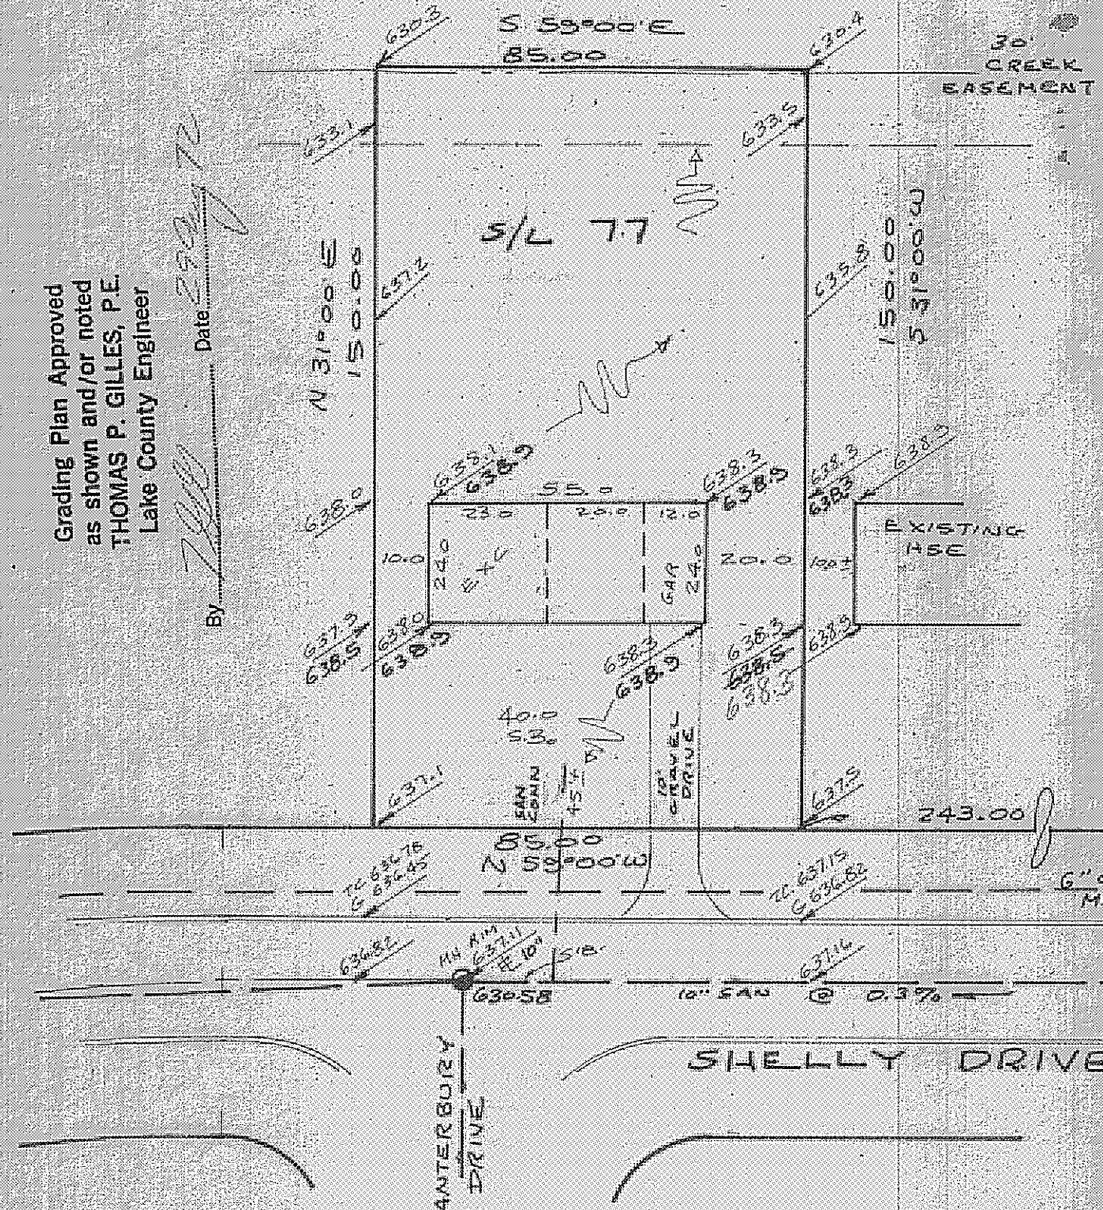

LEGEND

SANITARY MANHOLE
STORM MANHOLE
INLET OR CATCH BASIN
HYDRANT
EXISTING CONTOURS
PROPOSED CONTOURS
EXIST. ELEV. 100.0
@638.0—PROP ELEV

WATER VALVE (GAS)
WATER METER (GAS)
BUILT ELEVATION
DIRECTION OF SURFACE DRAINAGE

REMARKS

ALL BOUNDARY DATA SHOWN WAS OBTAINED FROM (DEEDS, RECORDED SUBDIVISION PLAT, OR OTHER PUBLIC RECORDS)

DESIGN CERTIFICATION

THIS PLAT WAS PREPARED BY ME, AND IS CORRECT TO THE BEST OF MY KNOWLEDGE AND BELIEF.

Richard J. Blair — PS #5244
NAME — SURVEYOR REGISTRATION NO.

CHECK LIST

DIMENSIONS
BEARINGS
TIE TO NEAREST STREET
SUBLOT NO PARCEL NO
SURROUNDING OWNERS
BLDG DIMENSIONS FIN GR
BLDG TIES FLR GRADES
APRON TYPE WIDTH THICKNESS
SIDEWALK TYPE WIDTH THICKNESS
CULVERT TYPE DIA LENGTH

WATER MAIN SIZE LOCATION
SAN SEWER SIZE % GR. LOC.
SAN MH CAST ELEV. INV ELEV.
S.M. CONN SIZE LOC DEPTH
STORM SEWER SIZE % GR. LOC.
STORM MH. CAST ELEV. INV. ELEV.
PAVT TYPE GRADE CURBS
GAS LINE LOC SIZE PRESSURE
SEPTIC TANK SIZE LOC
WELL LOCATION

"AS BUILT" CERTIFICATION

I, HEREBY CERTIFY THAT THE CIRCLED GRADES ARE EXISTING FIN. GRADES CHECKED IN FIELD ON _____ 19__ BY _____ SURVEYING AND ARE CORRECT TO THE BEST OF MY KNOWLEDGE AND BELIEF

REGISTERED SURVEYOR _____ NO _____

APPROVED
MADISON TWP. ZONING
Permit: 8615
Zoning Inspector: DKB

REVISIONS		
NO	DATE	BY
1		
2		
3		
4		
5		

PLAN PREPARED BY:

DEBELEC-SALO & ASSOC., INC.
CIVIL ENGINEERS — SURVEYORS
150 E. JACKSON ST. PAINESVILLE, O.

DRAWN BY	KJB	SCALE	1"=30'
CHKD		DATE	8/17/72
F.B.		APP'D	

JOB NO. 3609-77