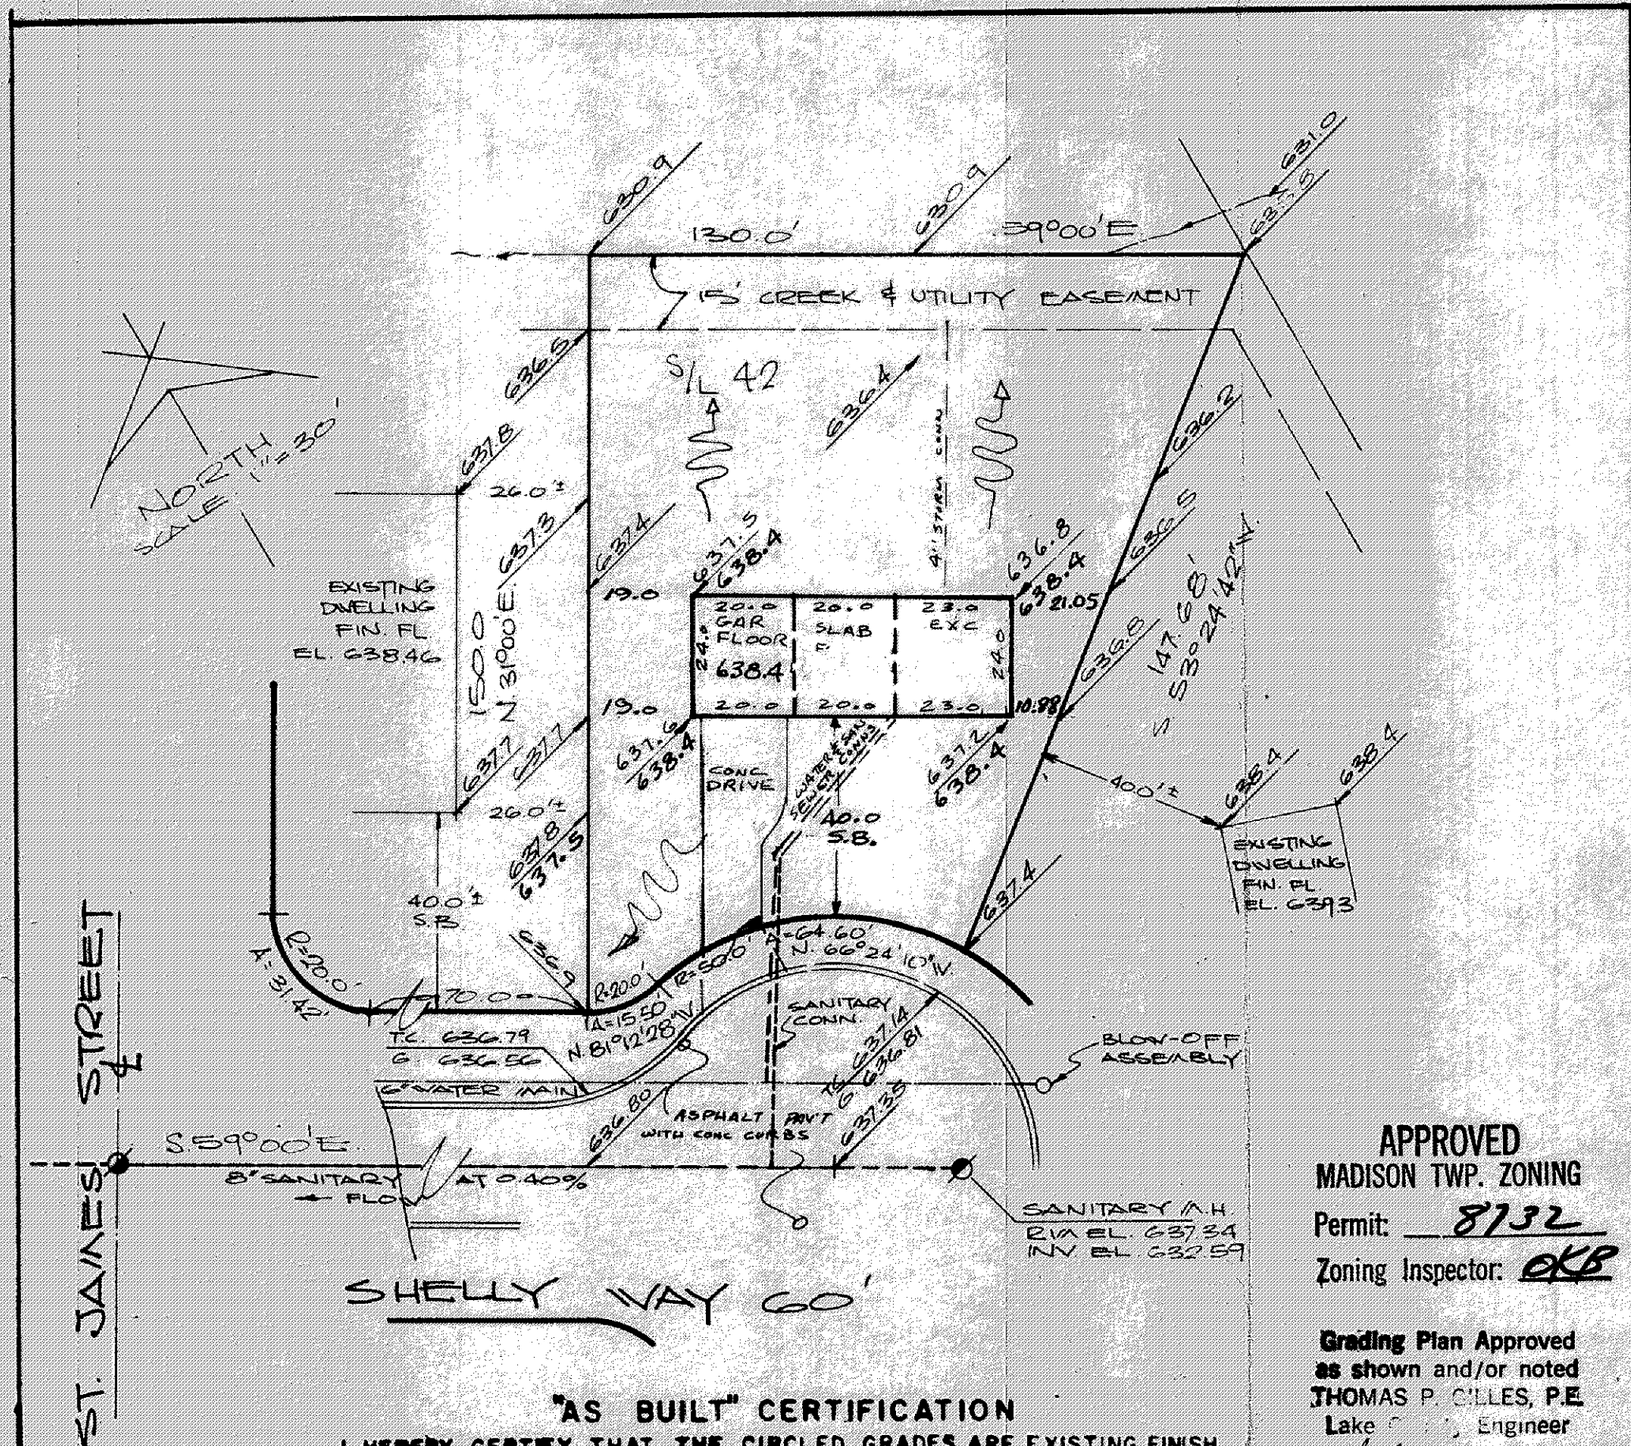

SITE PLAN

MADISON — TOWNSHIP — LAKE COUNTY, OHIO

for HALLMARK BUILDERS, INC. — CLIENT — OWNER

6931 Shelley Way — ADDRESS — STREET — Madison — CITY — 44057 — ZIP

CHAPEL GROVE — SUBDIVISION — NAME — 0-14 — VOL - PG

S/L 42 — SUBLOT NO. — SHELLY WAY — STREET

LOT — TRACT — VOLUME — PAGE — PERM PARCEL # — STREET

LEGEND

SANITARY MANHOLE
STORM MANHOLE
INLET OR CATCH BASIN
HYDRANT
EXISTING CONTOURS
PROPOSED CONTOURS
EXIST. ELEV. 100.0 / 100.0 PROP. ELEV.

WATER VALVE (GAS)
WATER METER (GAS)
AS BUILT ELEVATION 100.0
INDICATES DIRECTION OF SURFACE DRAINAGE

REMARKS

ALL BOUNDARY DATA SHOWN WAS OBTAINED FROM (DEEDS, RECORDED SUBDIVISION PLAT, OR OTHER PUBLIC RECORDS)

DESIGN CERTIFICATION

THIS PLAT WAS PREPARED BY ME, AND IS CORRECT TO THE BEST OF MY KNOWLEDGE AND BELIEF.

Richard J. Bilski — PS #5244

NAME — SURVEYOR — REGISTRATION NO.

CHECK LIST

DIMENSIONS
BEARINGS
TIE TO NEAREST STREET
SUBLOT NO. PARCEL NO.
SURROUNDING OWNERS
BLDG DIMENSIONS FIN GR
BLDG TIES FLR GRADES
APRON TYPE WIDTH THICKNESS
SIDEWALK TYPE WIDTH THICKNESS
CULVERT TYPE DIA LENGTH

WATER MAIN SIZE LOCATION
SAN SEWER SIZE % GR LOC
SAN M.H. CAST ELEV INV ELEV
SAN CONN SIZE LOC DEPTH
STORM SEWER SIZE % GR LOC
STORM MH. CAST ELEV. INV. ELEV.
PAVT TYPE GRADE CURBS
GAS LINE LOC SIZE PRESSURE
SEPTIC TANK SIZE LOC
WELL LOCATION

APPROVED
MADISON TWP. ZONING
Permit: 8732
Zoning Inspector: OKB

Grading Plan Approved as shown and/or noted
THOMAS P. GILLES, P.E.
Lake [illegible], Engineer
By [illegible] Date 3 Mar 73

"AS BUILT" CERTIFICATION

I, HEREBY CERTIFY THAT THE CIRCLED GRADES ARE EXISTING FINISH GRADES CHECKED IN FIELD ON _____ 19__ BY SURVEYING AND ARE CORRECT TO THE BEST OF MY KNOWLEDGE AND BELIEF

REGISTERED SURVEYOR — REG. NO.

REVISIONS		
NO	DATE	BY
1	2/8/73	[illegible]
2		
3		
4		
5		

PLAN PREPARED BY:
DEBEVEC-SALO & ASSOC, INC — NAME
130 EAST JACKSON ST, PAINESVILLE — ADDRESS

DRAWN BY AG	SCALE 1"=30'	PHONE NO.
CHK'D [illegible]	DATE 12/26/72	DRAWING NO 3609-42
CREW CHIEF	APP'D	