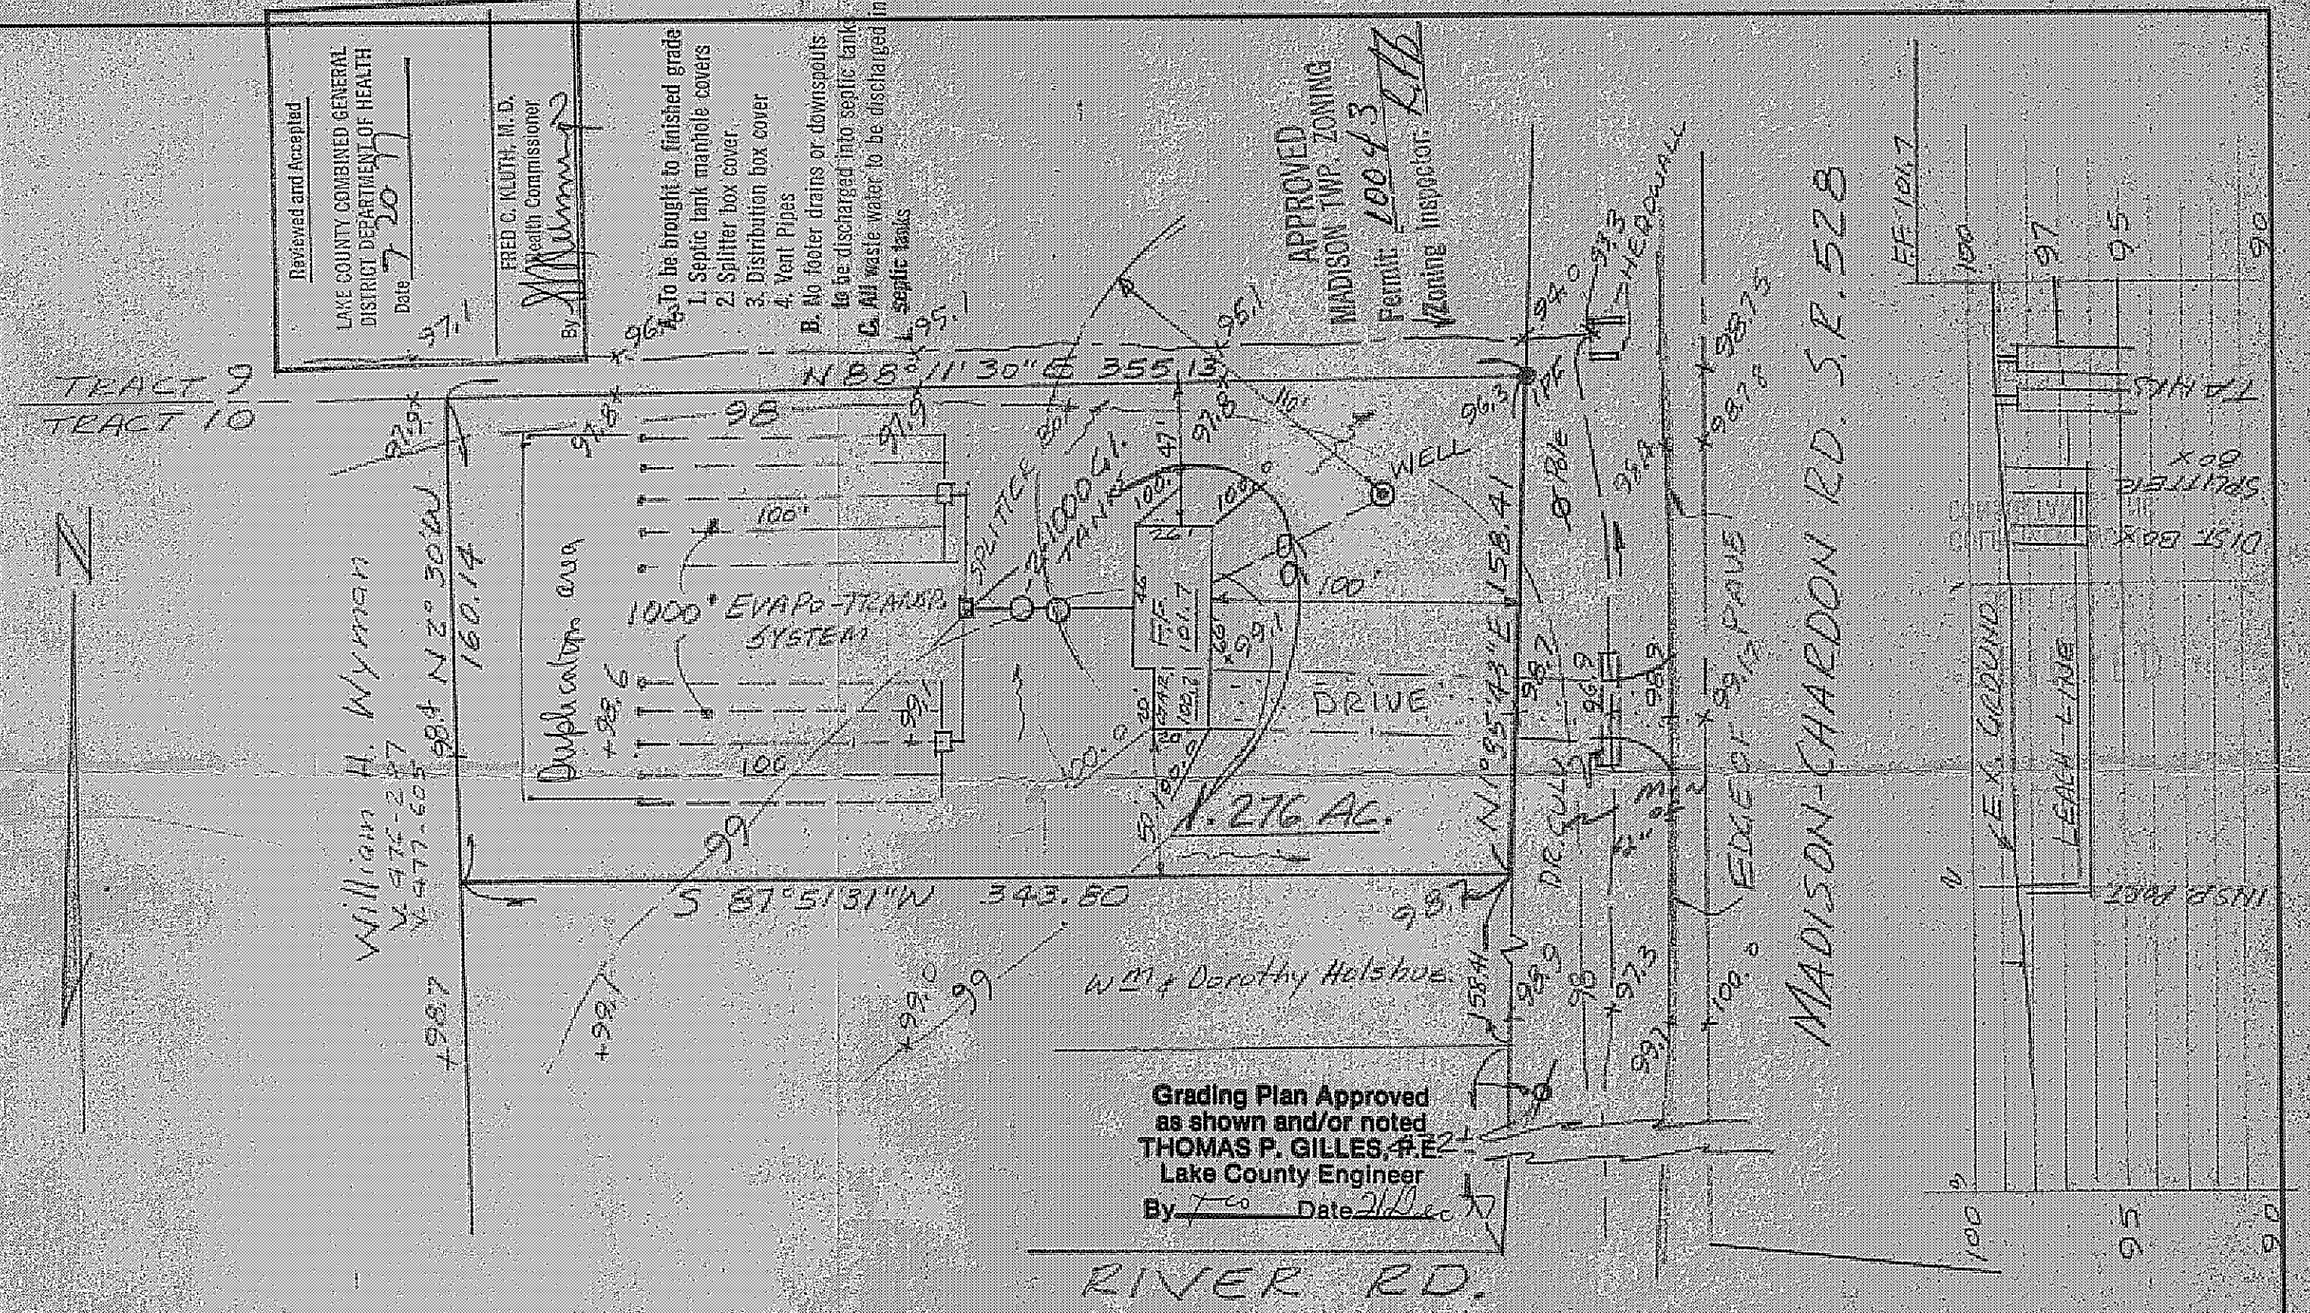

DESIGN CERTIFICATION	AS BUILT CERTIFICATION			
THIS PLAT WAS PREPARED BY ME AND IS CORRECT TO THE BEST OF MY KNOWLEDGE AND BELIEF.	I HEREBY CERTIFY THAT THE CIRCLED GRADES ARE EXISTING FINISH GRADES CHECKED IN THE FIELD ON _____ AND THAT SURVEY IS CORRECT TO THE BEST OF MY KNOWLEDGE AND BELIEF.	COLPETZER · WOODS CONSULTANTS, INC. 180 SOUTH STATE STREET • PAINESVILLE, OHIO 44077 • (216) 357-7569	DATE 7-77 SCALE 1"=50' DRWN BY CHKD BY JOB NO. 75189 FB 272 PG 104	SITE PLAN for GLENN DAVIS PART OF TRACT 10 MADISON TWP. LAKE COUNTY, OHIO
REG. SURVEYOR NO. 4785	REG. SURVEYOR NO. _____			