Grading Plan Approved
as shown and/or noted
THOMAS P. GILLES, P.E.
Lake County Engineer
By JWK Date 2-5-74

APPROVED
MADISON TWP. ZONING
Permit 8996
Zoning Inspector

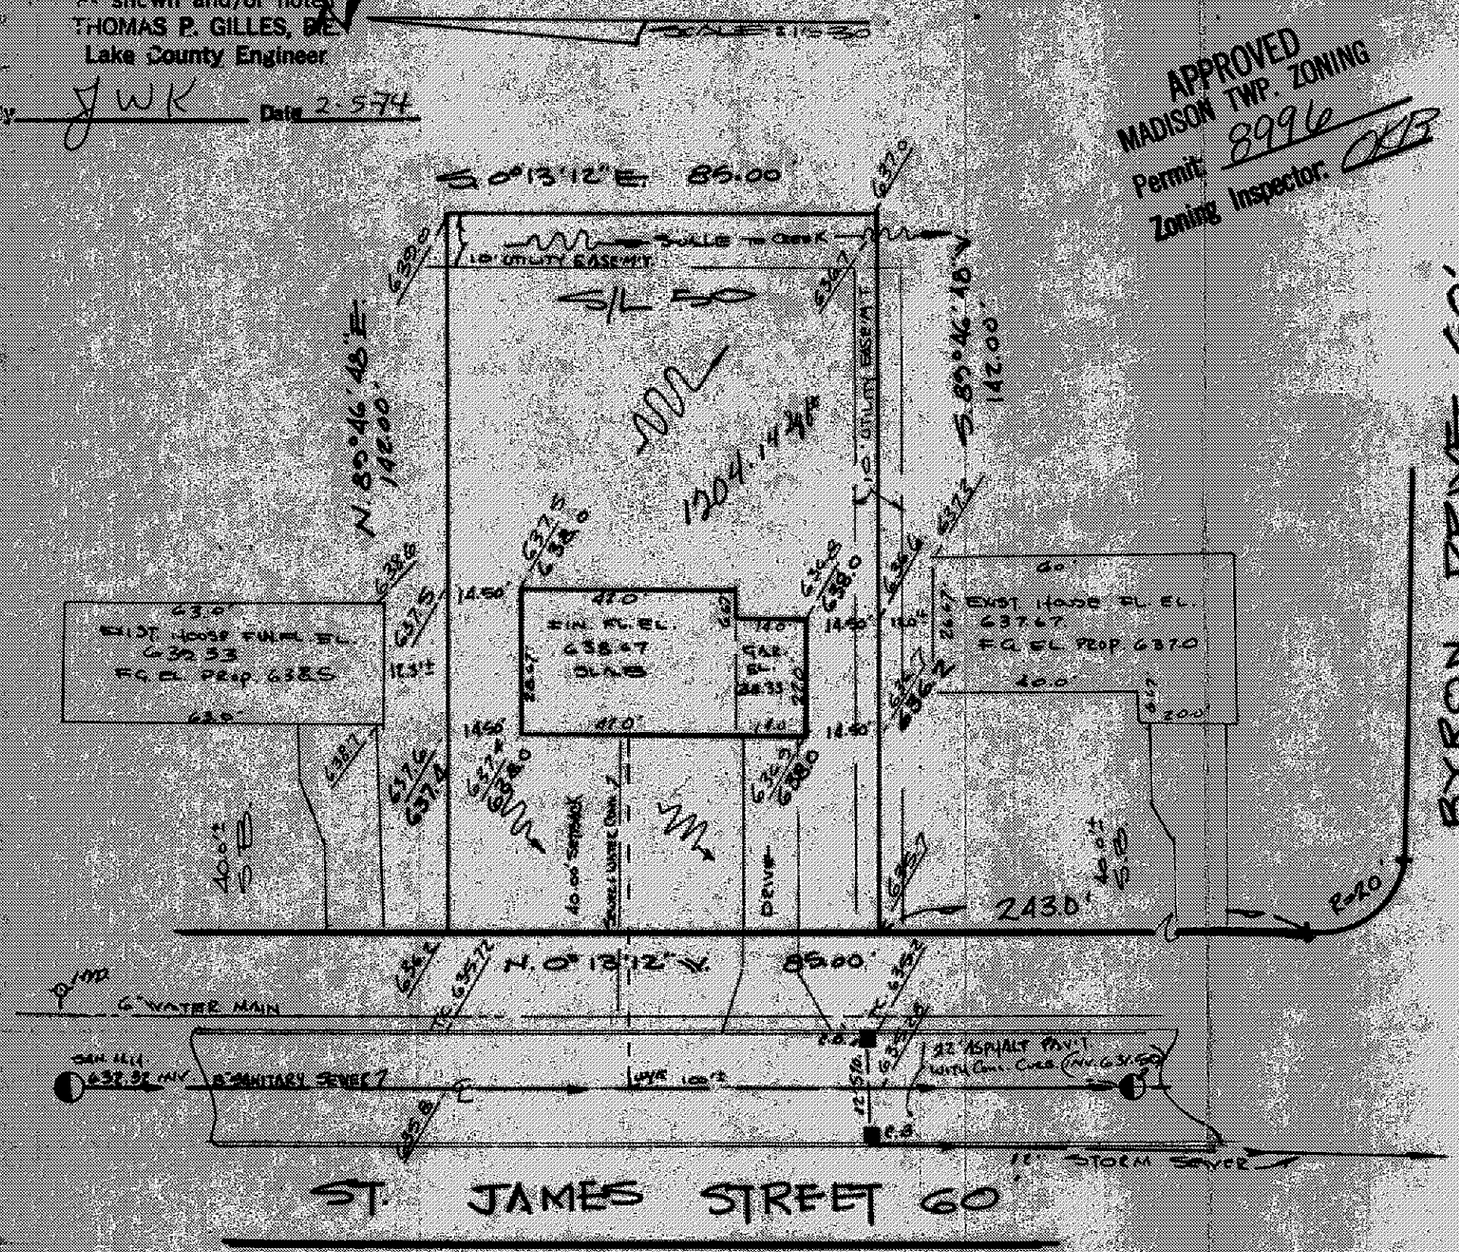

"AS BUILT" CERTIFICATION

I, HEREBY CERTIFY THAT THE CIRCLED GRADES ARE EXISTING FINISH GRADES CHECKED IN FIELD ON _____ 19__ BY SURVEYING AND ARE CORRECT TO THE BEST OF MY KNOWLEDGE AND BELIEF

REGISTERED SURVEYOR REG. NO.

SITE PLAN

MADISON TOWNSHIP LAKE COUNTY, OHIO

FOR: HALLMARK BUILDERS CLIENT / OWNER

2171 St James St. Madison 44057
ADDRESS STREET CITY ZIP

CHAPEL GROVE SUBD. SUBDIVISION NAME
VOL. - PG.
SUBLOT NO. STREET

LOT TRACT
VOLUME PAGE
PERM PARCEL # STREET

LEGEND

SANITARY MANHOLE
STORM MANHOLE
INLET OR CATCH BASIN
HYDRANT
EXISTING CONTOURS
PROPOSED CONTOURS
EXIST. ELEV. 100.0 PROP. ELEV. 100.0
WATER VALVE (GAS)
WATER METER (GAS)
AS BUILT ELEVATION 630.0
INDICATES DIRECTION OF SURFACE DRAINAGE

REMARKS

ALL BOUNDARY DATA SHOWN WAS OBTAINED FROM (DEEDS RECORDED SUBDIVISION PLAT OR OTHER PUBLIC RECORDS)

DESIGN CERTIFICATION

THIS PLAT WAS PREPARED BY ME, AND IS CORRECT TO THE BEST OF MY KNOWLEDGE AND BELIEF

Richard Debevec 75 #5244
NAME SURVEYOR REGISTRATION NO

CHECK LIST

DIMENSIONS
BEARINGS
TIE TO NEAREST STREET
SUBLOT NO. PARCEL NO.
SURROUNDING OWNERS
BLDG DIMENSIONS FIN. GR.
BLDG TIES FLR GRADES
APRON TYPE WIDTH THICKNESS
SIDEWALK TYPE WIDTH THICKNESS
CULVERT TYPE DIA, LENGTH
WATER MAIN SIZE LOCATION
SAN SEWER SIZE % GR LOC.
SAN MH CAST ELEV INV ELEV
SAN CONN. SIZE LOC DEPTH
STORM SEWER SIZE % GR LOC.
STORM MH CAST ELEV INV ELEV
PAVT TYPE GRADE CURBS
GAS LINE LOC SIZE PRESSURE
SEPTIC TANK SIZE LOC
WELL LOCATION

REVISIONS		
NO	DATE	BY
1		
2		
3		
4		
5		

PLAN PREPARED BY:
DEBEVEC-SALO & ASSOC, INC.
130 EAST JACKSON ST. PAINESVILLE

DRAWN BY	SCALE 1"=30'	PHONE NO.
CHK'D	DATE 1-22-74	DRAWING NO.
CREW CHIEF	APP'D	3609-30