Grading Plan Approved
as shown and/or noted
THOMAS P. GILLES, P.E.
Lake County Engineer

By JWK Date 6 June 73

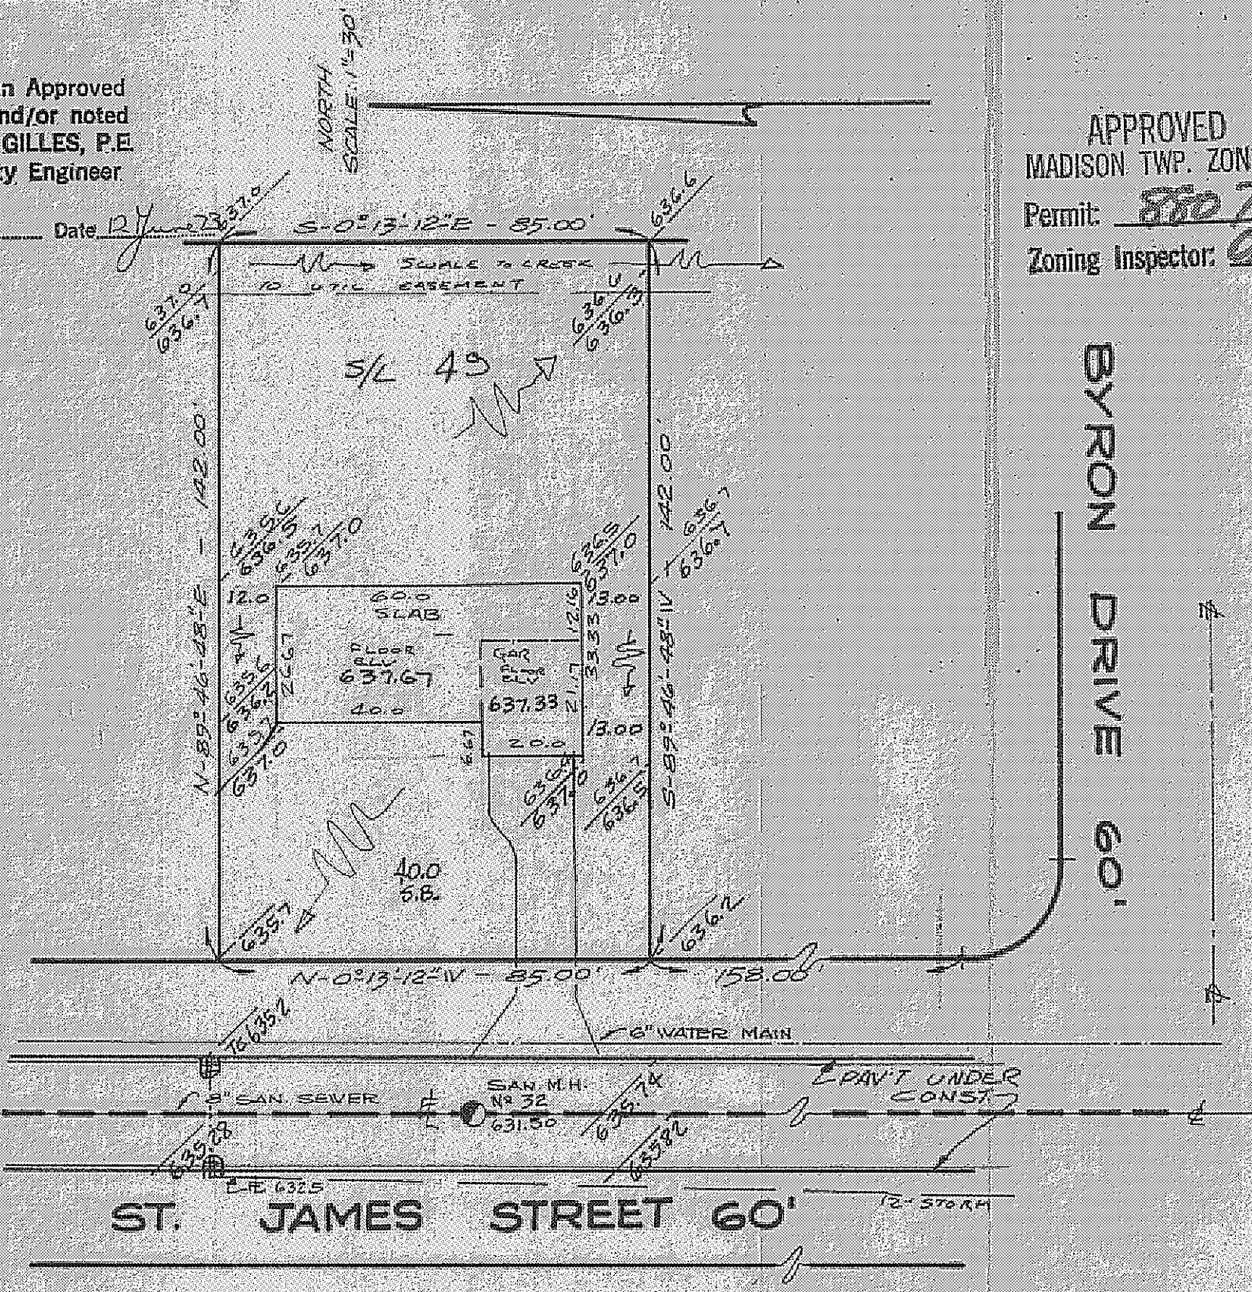

APPROVED
MADISON TWP. ZONING
Permit: 560 2
Zoning Inspector: DKB

BYRON DRIVE 60'

SITE PLAN

Madison TOWNSHIP LAKE COUNTY, OHIO

for Hallmark Builders CLIENT OWNER

2175 Jefferson STREET Madison CITY 44057 ZIP

Chapel Grove Sub. SUBDIVISION NAME — LOT — TRACT

VOL. PG

49 SUBLOT NO — St. James STREET — VOLUME — PAGE

PERM. PARCEL # — STREET

LEGEND

SANITARY MANHOLE
STORM MANHOLE
INLET OR CATCH BASIN
HYDRANT
EXISTING CONTOURS
PROPOSED CONTOURS
EXIST. ELEV. 100.0
PROP. ELEV. 100.0
WATER VALVE (GAS)
WATER METER (GAS)
AS BUILT ELEVATION 100.0
INDICATES DIRECTION OF SURFACE DRAINAGE

REMARKS

ALL BOUNDARY DATA SHOWN WAS OBTAINED FROM (DEEDS, RECORDED SUBDIVISION PLAT, OR OTHER PUBLIC RECORDS)

DESIGN CERTIFICATION

THIS PLAT WAS PREPARED BY ME, AND IS CORRECT TO THE BEST OF MY KNOWLEDGE AND BELIEF.

Richard M. Seiger PS# 5244
NAME SURVEYOR REGISTRATION NO.

CHECK LIST

- DIMENSIONS
- BEARINGS
- TIE TO NEAREST STREET
- SUBLOT NO. PARCEL NO.
- SURROUNDING OWNERS
- BLDG. DIMENSIONS FIN. GR.
- BLDG. TIES FLR. GRADES
- APRON TYPE WIDTH THICKNESS
- SIDEWALK TYPE WIDTH THICKNESS
- CULVERT TYPE DIA. LENGTH
- WATER MAIN SIZE LOCATION
- SAN. SEWER SIZE % GR. LOC.
- SAN. M.H. CAST ELEV. INV. ELEV.
- SAN. CONN. SIZE LOC. DEPTH
- STORM SEWER SIZE % GR. LOC.
- STORM MH. CAST ELEV. INV. ELEV.
- PAVT. TYPE GRADE CURBS
- GAS LINE LOC. SIZE PRESSURE
- SEPTIC TANK SIZE LOC.
- WELL LOCATION

"AS BUILT" CERTIFICATION

I, HEREBY CERTIFY THAT THE CIRCLED GRADES ARE EXISTING FINISH GRADES CHECKED IN FIELD ON _____ 19__ BY SURVEYING AND ARE CORRECT TO THE BEST OF MY KNOWLEDGE AND BELIEF.

REGISTERED SURVEYOR REG. NO.

REVISIONS		
NO	DATE	BY
1	6/6/73	RJB
2		
3		
4		
5		

PLAN PREPARED BY:
DE BEVEC-SALO & ASSOC., INC.
NAME
130 EAST JACKSON ST. PAINESVILLE
ADDRESS

DRAWN BY RJB	SCALE 1"=30'	PHONE NO.
CHK'D RJB	DATE 3-22-73	DRAWING NO. 3609-49
CREW CHIEF	APP'D	