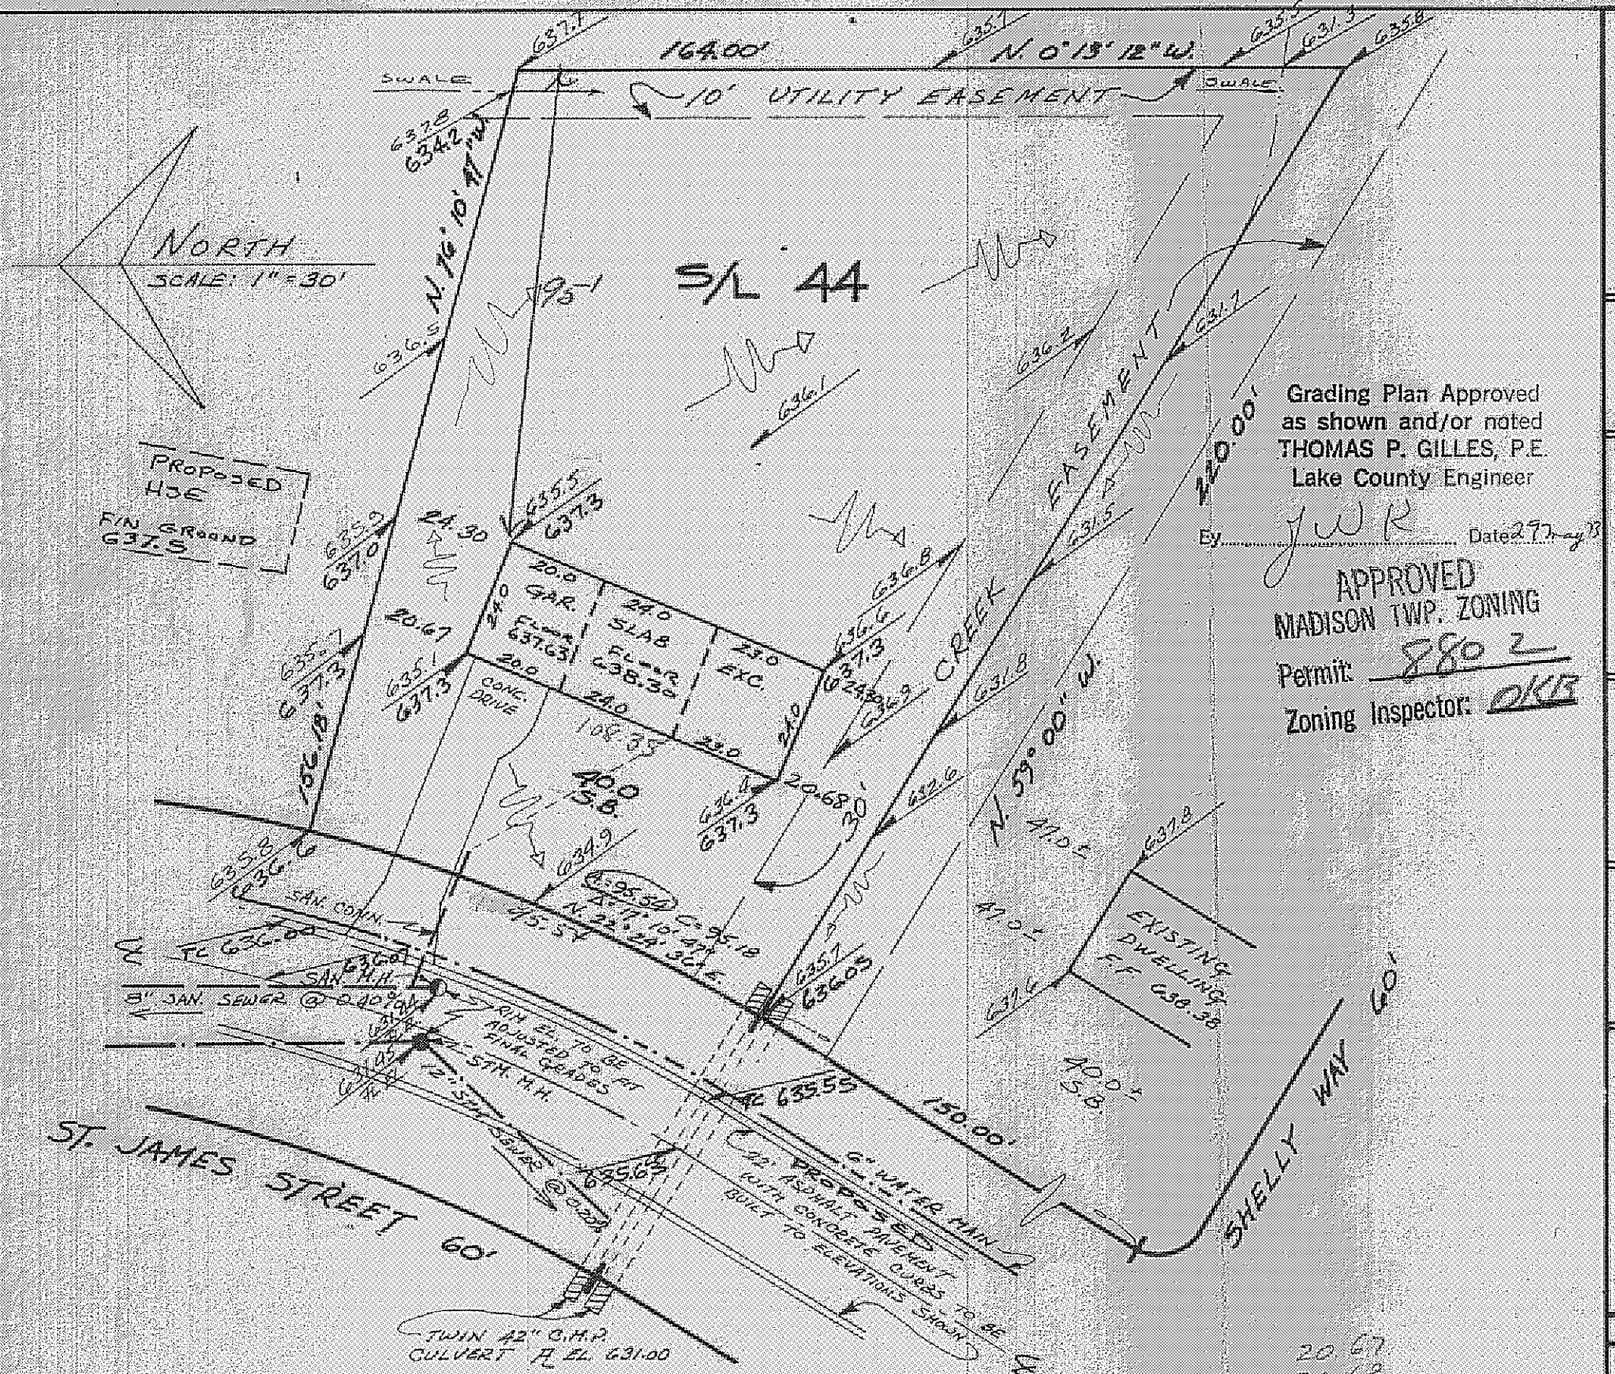

Grading Plan Approved as shown and/or noted
THOMAS P. GILLES, P.E.
Lake County Engineer

By JWR Date 29 May 73

APPROVED
MADISON TWP. ZONING
Permit: 8802
Zoning Inspector: OKB

20.67
20.68
44.00
23
108.35

"AS BUILT" CERTIFICATION

I, HEREBY CERTIFY THAT THE CIRCLED GRADES ARE EXISTING FINISH GRADES CHECKED IN FIELD ON _____ 19__ BY _____ SURVEYING AND ARE CORRECT TO THE BEST OF MY KNOWLEDGE AND BELIEF

REGISTERED SURVEYOR _____ REG. NO. _____

SITE PLAN

MADISON (TOWNSHIP) LAKE COUNTY, OHIO

for: PURITAN HOMES (CLIENT OWNER)

2225 James Street Madison 44057
ADDRESS STREET CITY ZIP

CHAPEL GROVE (SUB. NAME)
0-14 (VOL. NO.)
S/L-44 (SUBLOT NO.) ST. JAMES (STREET)

LOT TRACT
VOLUME PAGE
FERM PARCEL # STREET

LEGEND

SANITARY MANHOLE
STORM MANHOLE
INLET OR CATCH BASIN
HYDRANT
EXISTING CONTOURS
PROPOSED CONTOURS
EXIST. ELEV. 100.0 / 100.0 PROP. ELEV.

WATER VALVE (GAS)
WATER METER (GAS)
AS BUILT ELEVATION (100.0)
INDICATES DIRECTION OF SURFACE DRAINAGE

REMARKS

ALL BOUNDARY DATA SHOWN WAS OBTAINED FROM (DEEDS, RECORDED SUBDIVISION PLAT, OR OTHER PUBLIC RECORDS)

DESIGN CERTIFICATION

THIS PLAT WAS PREPARED BY ME, AND IS CORRECT TO THE BEST OF MY KNOWLEDGE AND BELIEF

Richard J. Bilski PS # 5244
NAME SURVEYOR REGISTRATION NO.

CHECK LIST

DIMENSIONS
BEARINGS
TIE TO NEAREST STREET
SUBLOT NO. PARCEL NO.
SURROUNDING OWNERS
BLDG DIMENSIONS FIN GR.
BLDG TIES FLR GRADES
APRON TYPE WIDTH THICKNESS
SIDEWALK TYPE WIDTH THICKNESS
CULVERT TYPE DIA LENGTH

WATER MAIN SIZE LOCATION
SAN SEWER SIZE % GR LOC
SAN M H CAST ELEV INV ELEV
SAN CONN SIZE LOC DEPTH
STORM SEWER SIZE % GR LOC
STORM MH CAST ELEV INV ELEV
PAVT TYPE GRADE CURBS
GAS LINE LOC SIZE PRESSURE
SEPTIC TANK SIZE LOC
WELL LOCATION

REVISIONS		
NO	DATE	BY
1	5/22/73	DJB
2		
3		
4		
5		

PLAN PREPARED BY:
DEBEVEC SALO & ASSOC, INC.
NAME
130 EAST JACKSON ST, PAINESVILLE
ADDRESS

DRAWN BY JRZ	SCALE 1" = 30'	PHONE NO
CHK'D	DATE 2/20/73	DRAWING NO 3855-44
CREW CHIEF	APP'D	