Grading Plan Approved
as shown and/or noted
THOMAS P. GILLES, P.E.
Lake County Engineer

By PLG Date 5 Dec 72

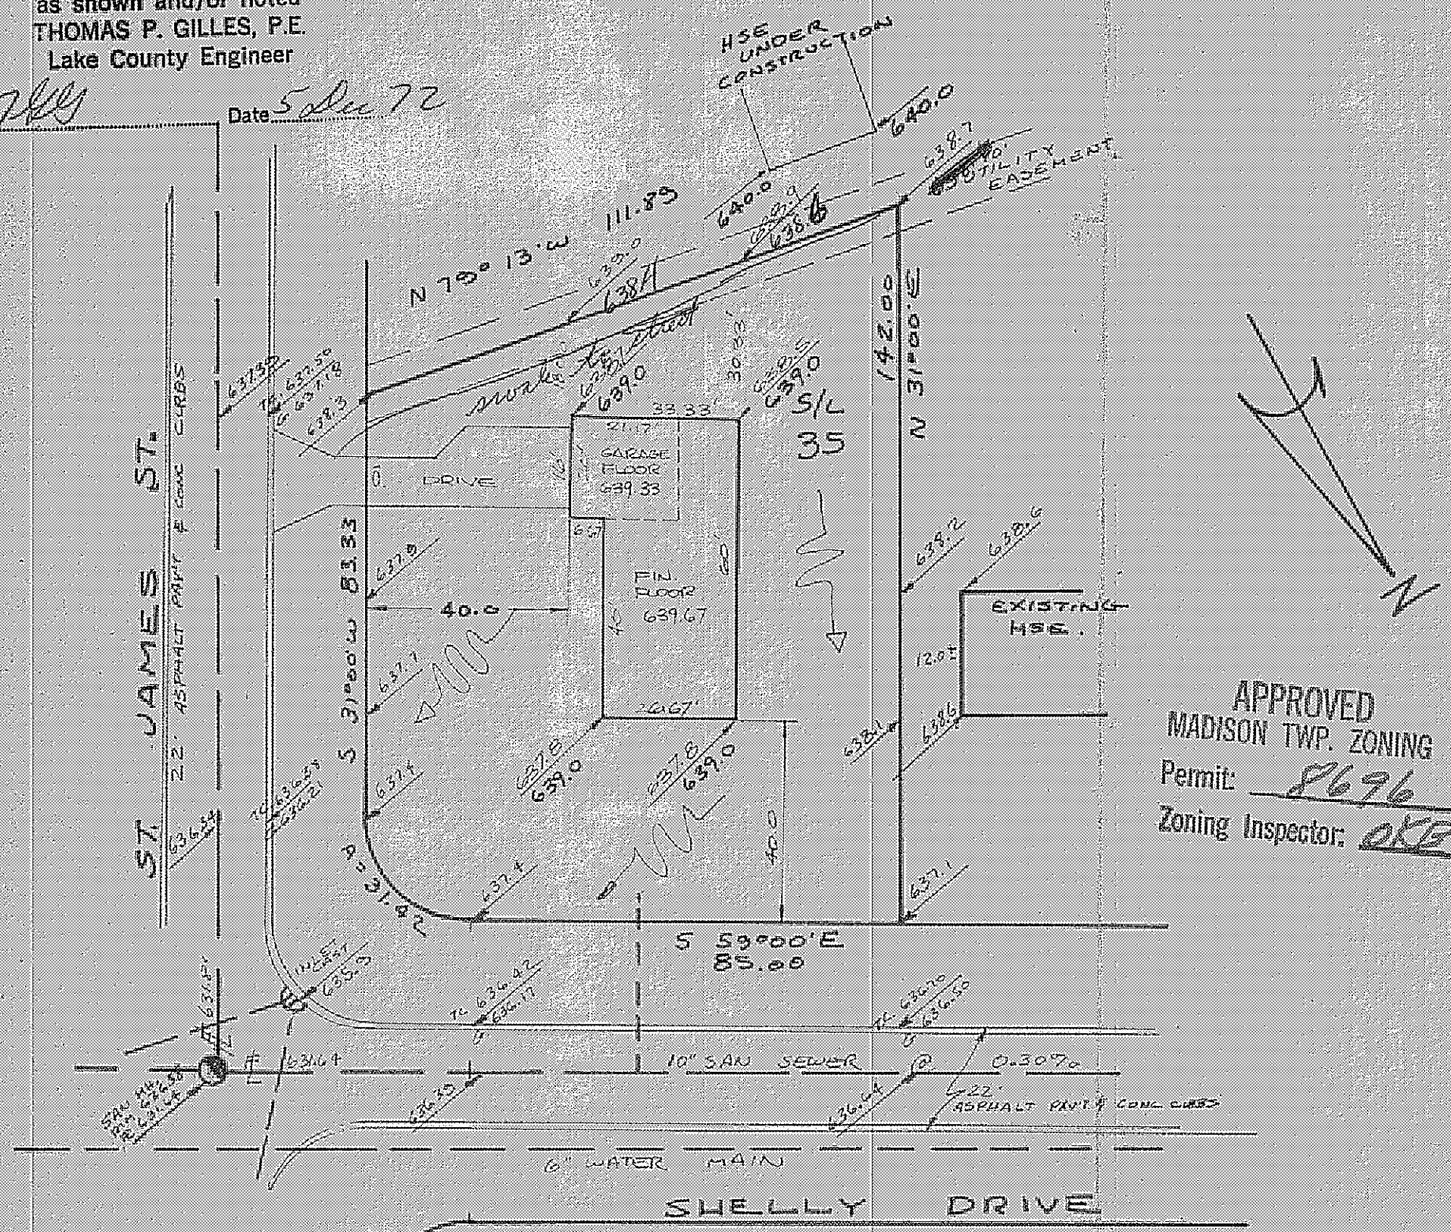

APPROVED
MADISON TWP. ZONING
Permit: #696
Zoning Inspector: OKE

"AS BUILT" CERTIFICATION

I, HEREBY CERTIFY THAT THE CIRCLED GRADES ARE EXISTING FINISH GRADES CHECKED IN FIELD ON _____ 19__ BY SURVEYING AND ARE CORRECT TO THE BEST OF MY KNOWLEDGE AND BELIEF

SITE PLAN

MADISON TOWNSHIP LAKE COUNTY, OHIO

for: HALLMARK BLDRS INC
CLIENT OWNER

6900 Shelly Drive Madison 44057
ADDRESS STREET CITY ZIP

CHAPEL GROVE SUBDIVISION NAME
O-14 VOL. PG.
35 SUBLOT NO. SHELLY DR. STREET

LOT TRACT
VOLUME PAGE
PERM. PARCEL # STREET

LEGEND

SANITARY MANHOLE
STORM MANHOLE
INLET OR CATCH BASIN
HYDRANT
EXISTING CONTOURS
PROPOSED CONTOURS
EXIST. ELEV. 100.0
100.0 PROP. ELEV.
WATER VALVE (GAS)
WATER METER (GAS)
AS BUILT ELEVATION 100.0
INDICATES DIRECTION OF SURFACE DRAINAGE

REMARKS

ALL BOUNDARY DATA SHOWN WAS OBTAINED FROM (DEEDS, RECORDED SUBDIVISION PLAT, OR OTHER PUBLIC RECORDS)

DESIGN CERTIFICATION

THIS PLAT WAS PREPARED BY ME, AND IS CORRECT TO THE BEST OF MY KNOWLEDGE AND BELIEF

Richard J. Calvert PS#5244
NAME SURVEYOR REGISTRATION NO.

CHECK LIST

DIMENSIONS
BEARINGS
TIE TO NEAREST STREET
SUBLOT NO. PARCEL NO
SURROUNDING OWNERS
BLDG DIMENSIONS FIN GR
BLDG TIES FLR GRADES
APRON TYPE WIDTH THICKNESS
SIDEWALK TYPE WIDTH THICKNESS
CULVERT TYPE DIA LENGTH
WATER MAIN SIZE LOCATION
SAN SEWER SIZE % GR LOC
SAN M.H. CAST ELEV INV ELEV
SAN. CONN. SIZE LOC DEPTH
STORM SEWER SIZE % GR LOC
STORM MH CAST ELEV INV ELEV
PAVT TYPE GRADE CURBS
GAS LINE LOC SIZE PRESSURE
SEPTIC TANK SIZE LOC
WELL LOCATION

REVISIONS		
NO	DATE	BY
1	11-20-72	AG
2		
3		

PLAN PREPARED BY:
DEBEVEC-SALO & ASSOC., INC.
NAME
130 EAST JACKSON ST. PAINESVILLE
ADDRESS

DRAWN BY PJB | SCALE 1" = 30' | PHONE NO.
CHK'D | DATE | DRAWING NO.