SITE PLAN

MADISON TOWNSHIP — LAKE COUNTY, OHIO

for T. HALLMARK HOMES, INC.

2264 James ST. Madison
ADDRESS STREET CITY ZIP

APPROVED
MADISON TWP. ZONING
Zoning Inspector: OSB

NORTH

CHAPEL GROVE SUBDIVISION
RECORD SUBDIVISION

VOLUME 8 PAGE 14

SUBLOT NO 37 STREET ST. JAMES ST.

LOT
VOLUME PAGE
TOWN TOWNSHIP STREET

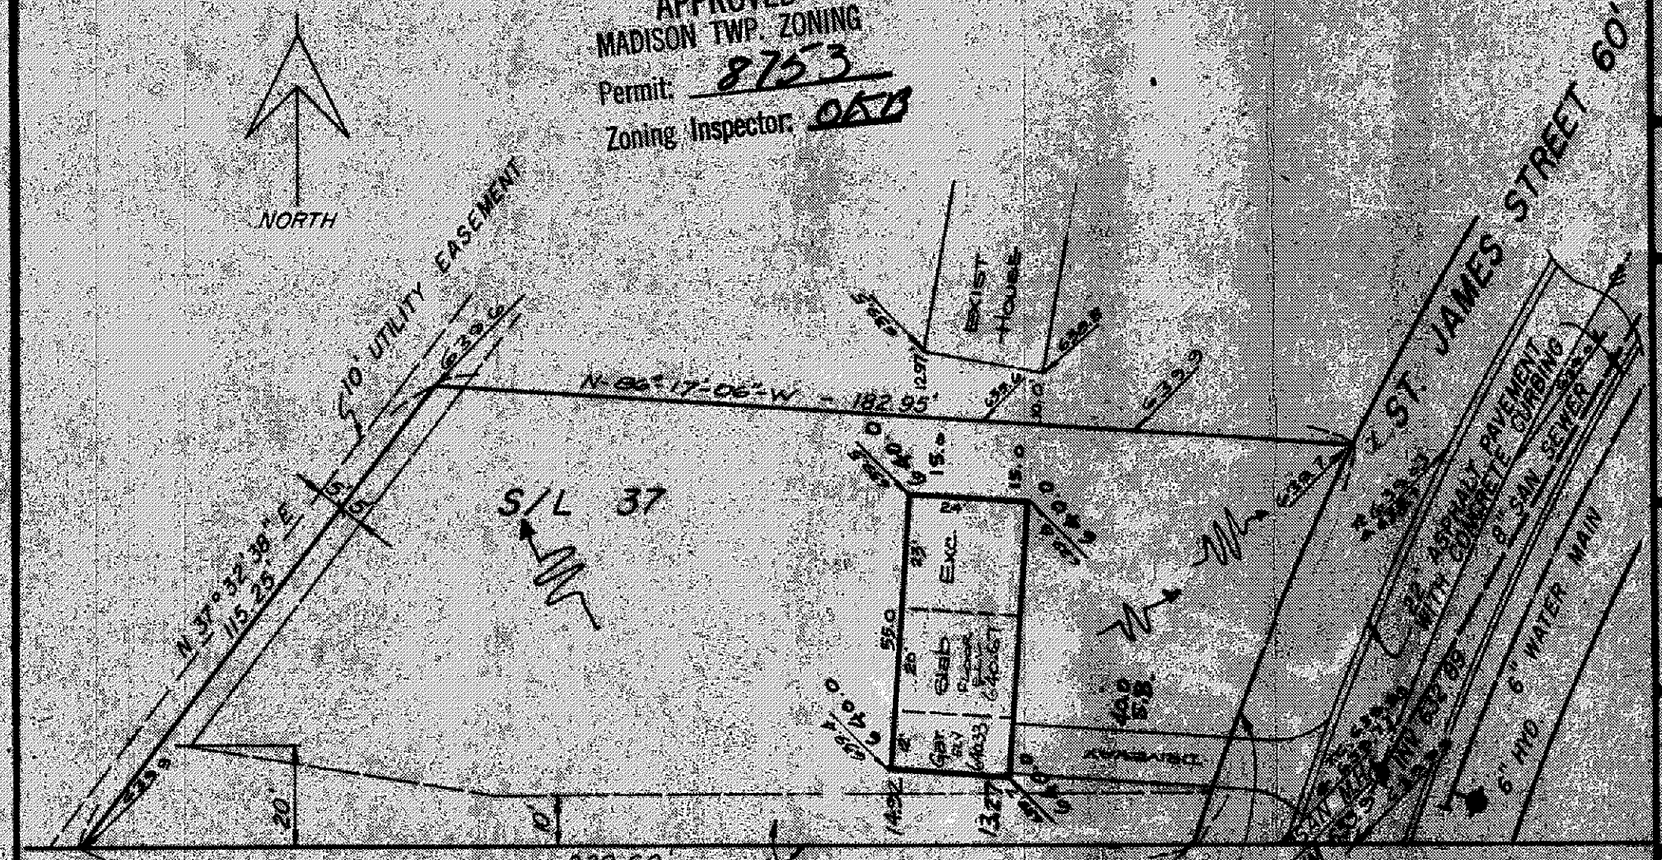
10' UTILITY EASEMENT
N 89° 17' 06" W 182.95'
EXIST HOUSE
S/L 37
N 37° 32' 38" E 115.25'
435'±
20'
0'
220.60'
N 89° 46' 37" E
10' UTILITY EASEMENT
ST. JAMES STREET 60'
22' ASPHALT PAVEMENT WITH CONCRETE CURBING
8" SAN. SEWER
6" WATER MAIN
6" HYD
Slab
Gar.
Exc.
Apron
