PLOT PLAN

for BOYD WALKER
OF SUBLOT NO. 1101 IN THE MADISON GOLF LAKELANDS SUBDIVISION AS RECORDED IN VOLUME E PAGE 68 OF LAKE COUNTY MAP RECORDS AND SITUATED IN THE TOWNSHIP OF
MADISON, OHIO

SCALE: 1" = 20'

MAY, 1979

NOTES:

1. PROPOSED GROUND GRADES
   EXISTING GROUND GRADES
2. OVERLAND DRAINAGE
3. BENCH MARK: TOP OF HYDRANT ON EAST SIDE OF STERLING RD. APPROX. 32'± SOUTH OF SOUTH ℄ OF SUBLOT NO. 1101. ELEV. 100.00

JAMES E. BEULEY, JR.
REG. SURVEYOR No. 4999

STATE OF OHIO
JAMES E. BEULEY, JR.
4999
REGISTERED
SURVEYOR

Directions as shown and/or noted
Approved
THOMAS P. GILLES, P.E.
Lake County Engineer
By
Date 3-26-79

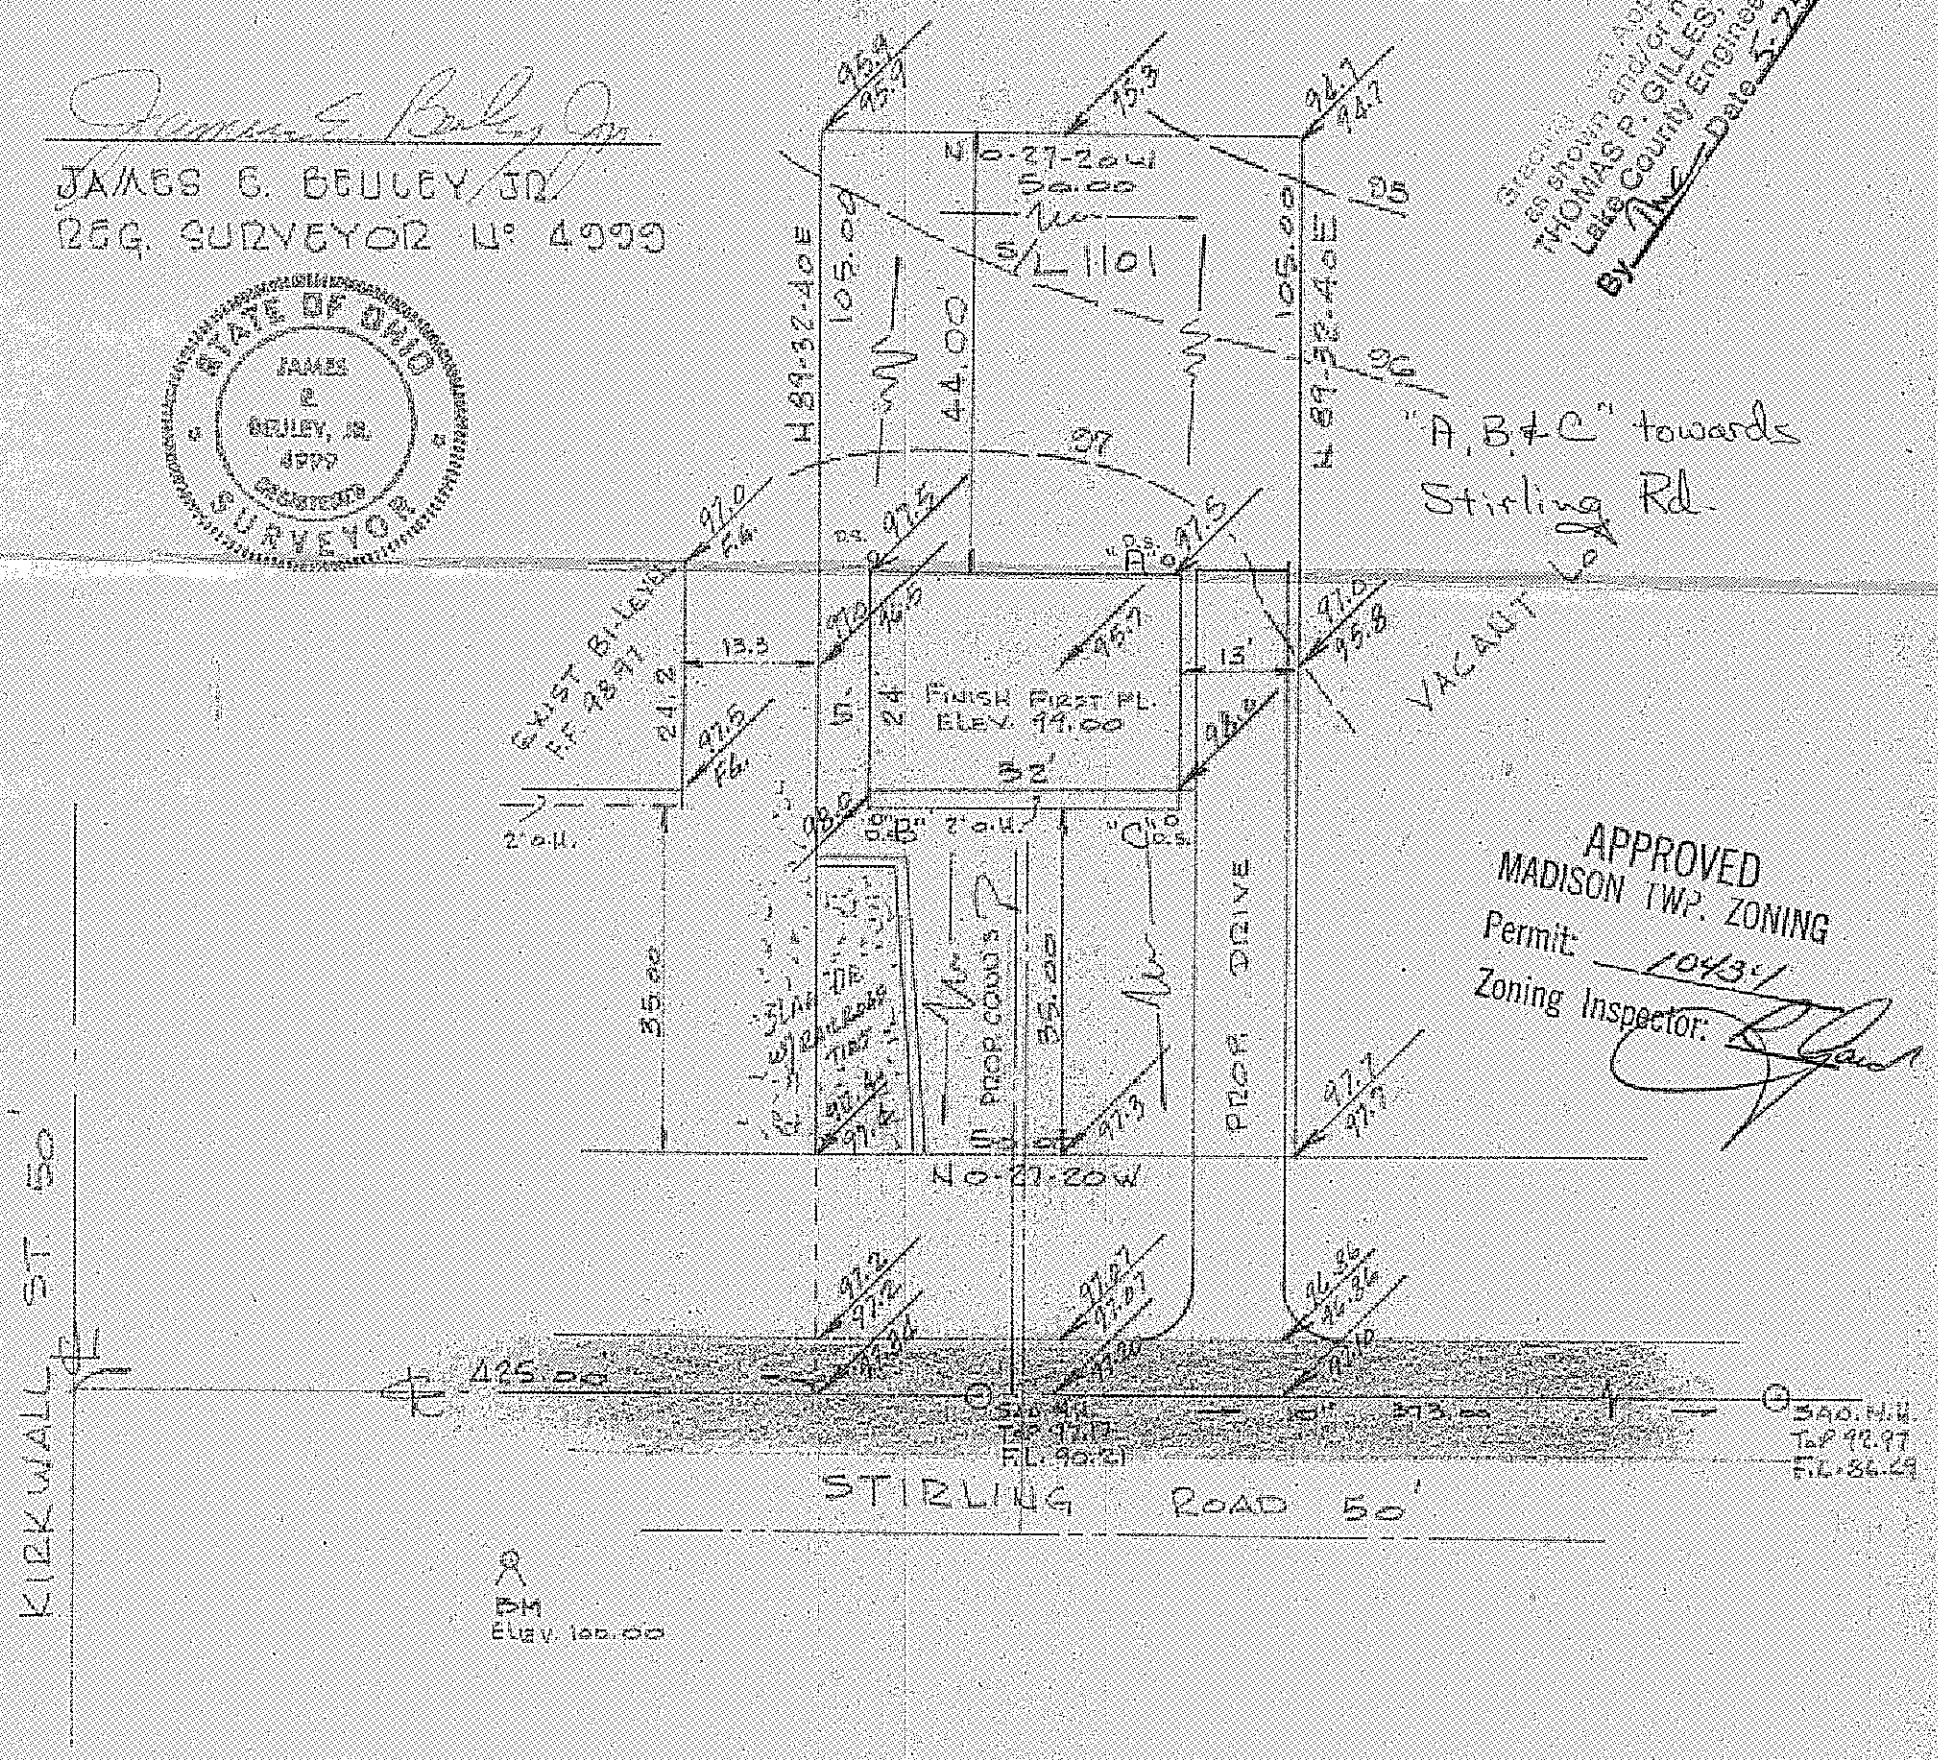

APPROVED
MADISON TWP. ZONING
Permit: 10431
Zoning Inspector:

THIS PLOT PLAN PREPARED BY
LAKE, INC.
ENGINEERS · SURVEYORS
30575 EUCLID AVE. WICKLIFFE, OHIO