ZONE 9707

SITE PLAN FOR:

P.A.C. HOMES
2736 NORTH RIDGE RD
PAINESVILLE OHIO

BEING SUBLOT No. 729 IN THE MADISON GOLF LAKELANDS SUBDIVISION IN MADISON TOWNSHIP, OHIO.

PREPARED BY:

WM. R. GRAY ASSOC. INC.
7547 MENTOR AVENUE
MENTOR, OHIO.

DATE SEPT. 22, 1976 SCALE 1"=20'
REVISED: JUNE 1, 1977

CERTIFICATION:

I HEREBY CERTIFY THAT THIS PLAT IS CORRECT TO THE BEST OF MY KNOWLEDGE

BY Wm. R. Gray.
WM. R. GRAY REG. SURV. #2752

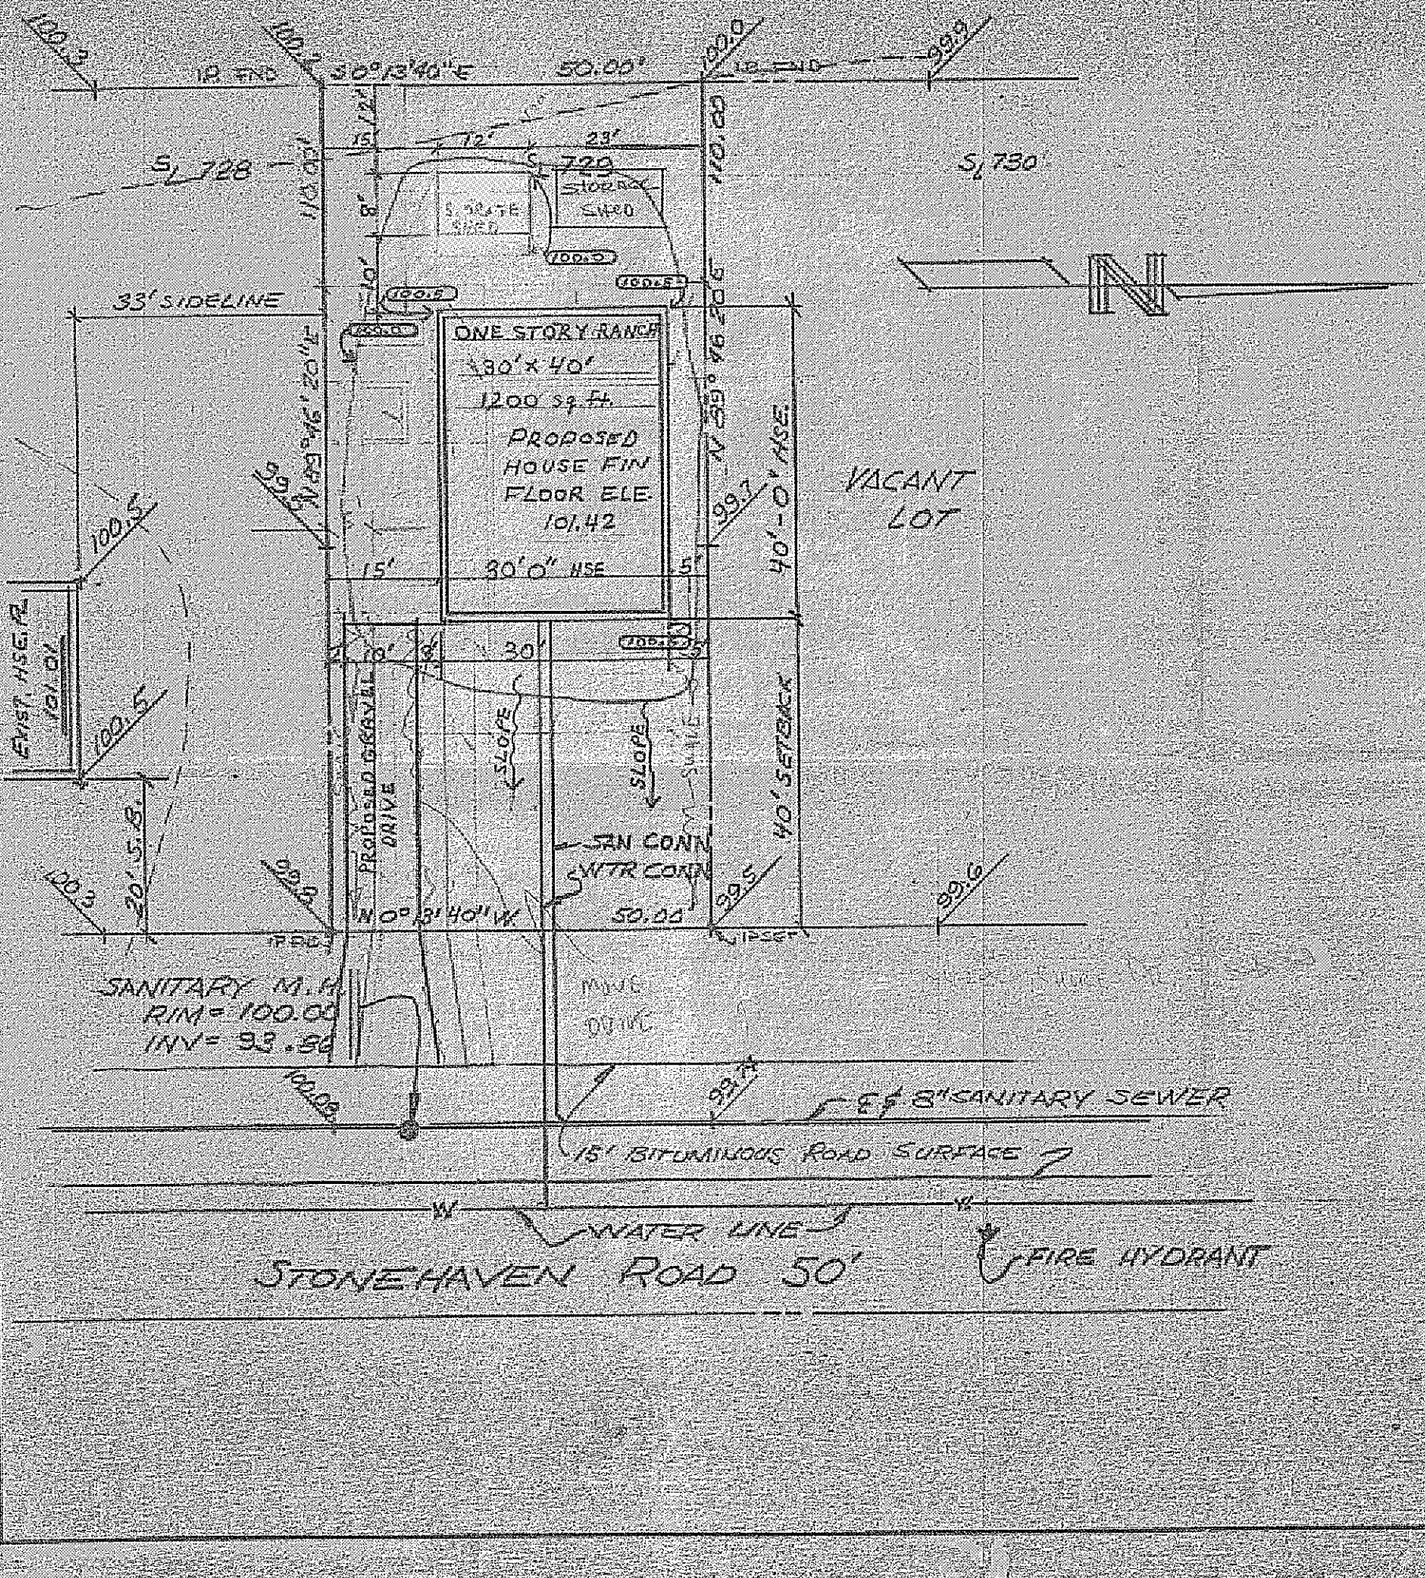

Grading Plan Approved as shown and/or noted
THOMAS P. GILLES, P.E.
Lake County Engineer
By: _____ Date 5/12/77

STATE OF OHIO
WM. R. GRAY
2752
REGISTERED PROFESSIONAL SURVEYOR

S 76-18