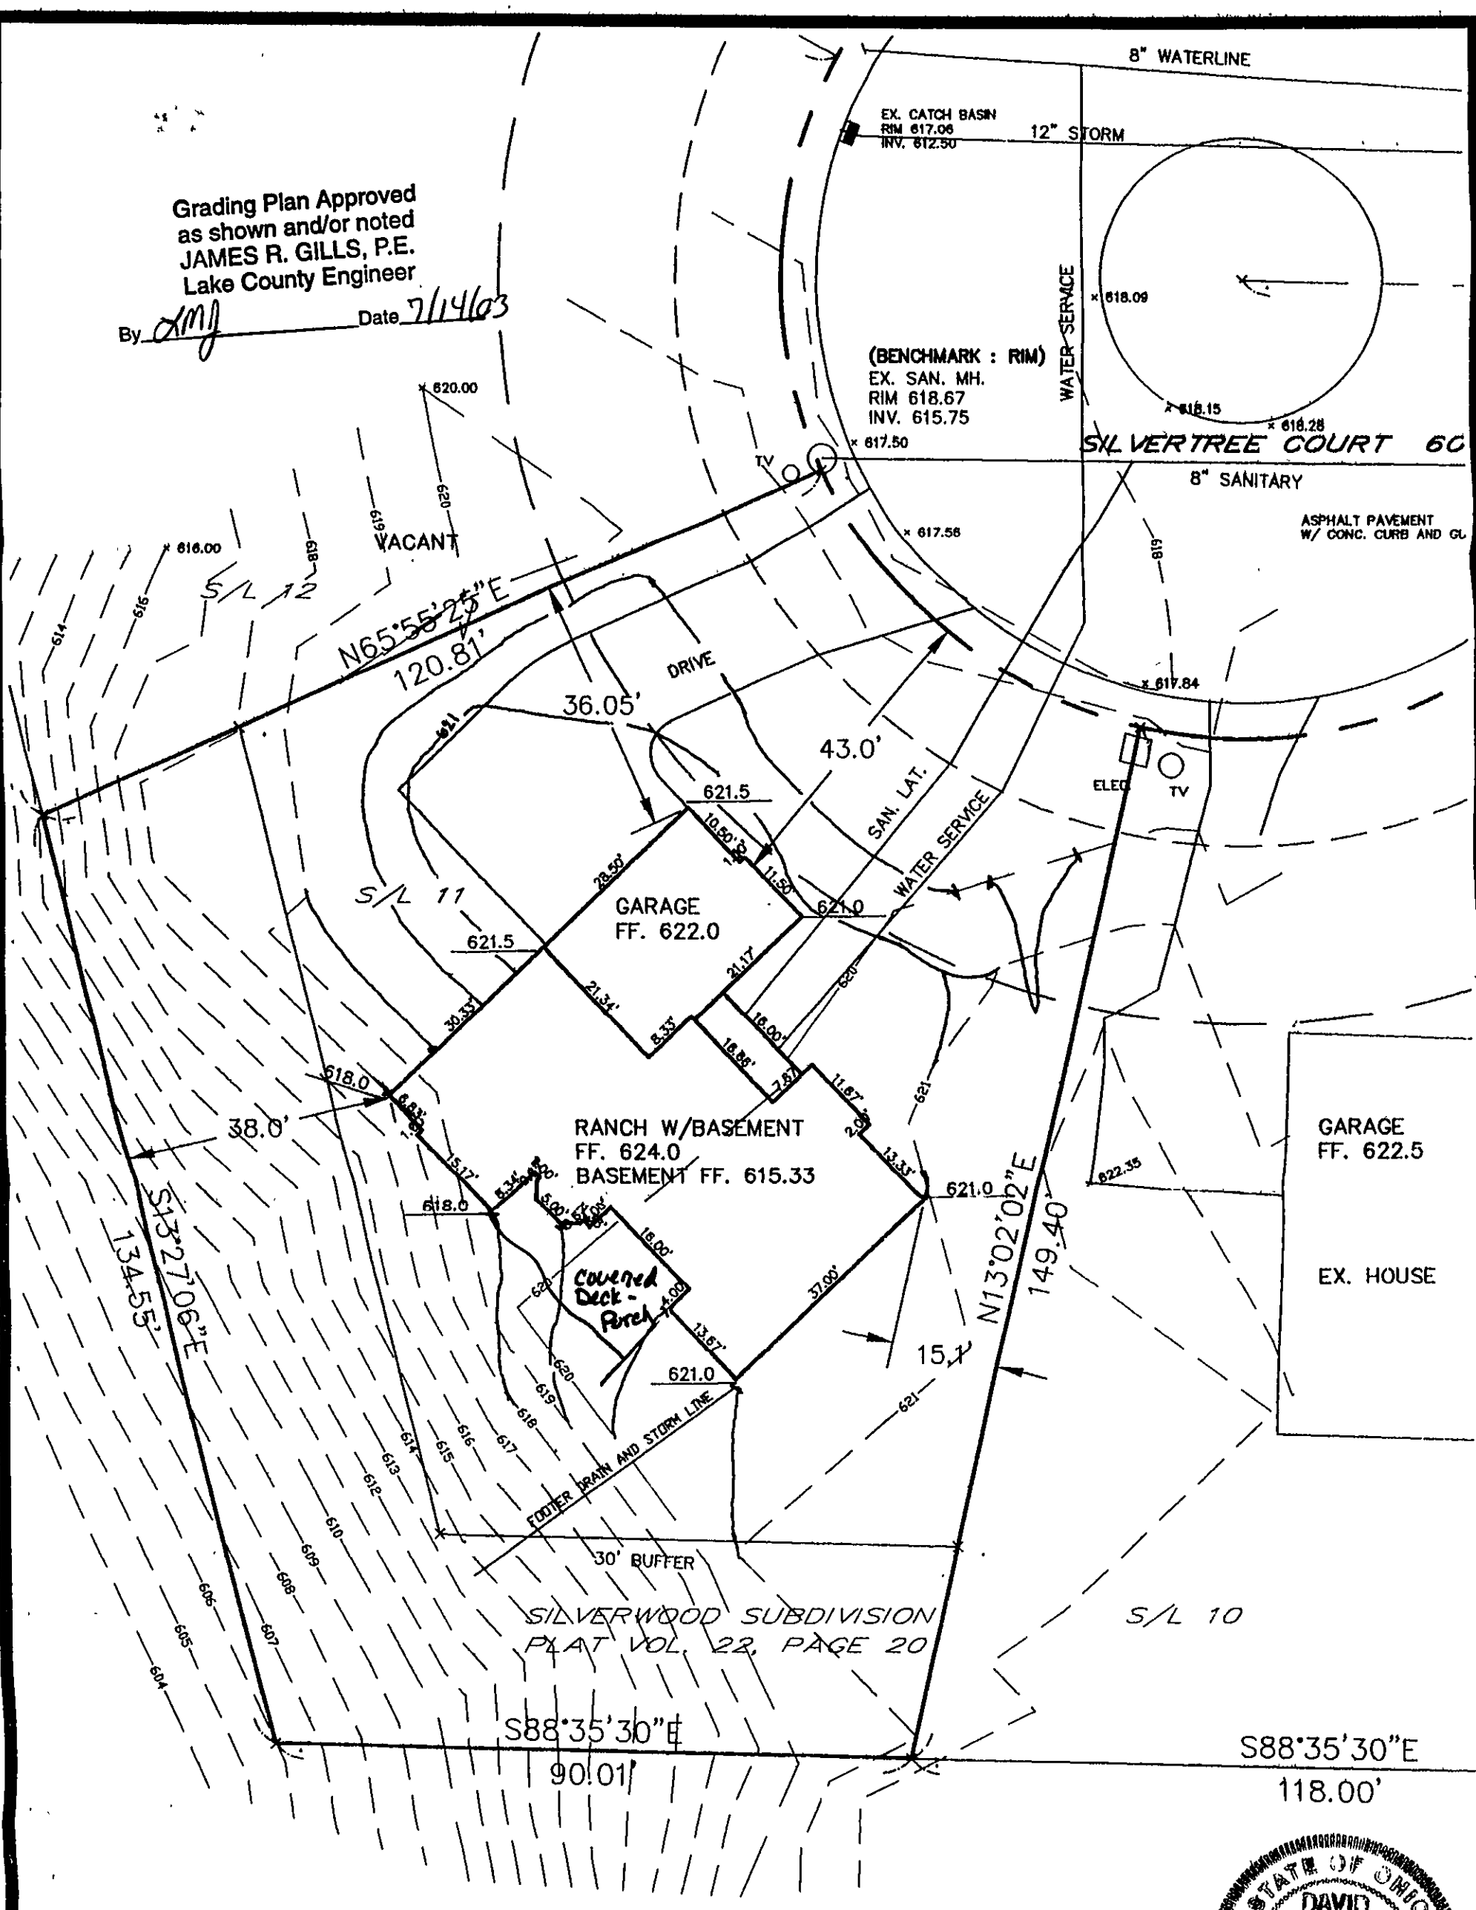

NOTES : 1. The Contractor Shall Verify the Following Before Starting:
Finish Floor Elevations and House Size.
Location and elevation of existing utility connections.

2. Contractor Shall Contact OUPS at least 2 Working Days prior to construction, 1-800-362-2764.

"I, the undersigned hereby certify that this topography, indicated by 1' contours and elevations shown hereon represents an actual field survey made by me in June, 2003, and that the elevations were taken at appropriate intervals and that as of that date they existed as indicated hereon."

David A. Rapp 6/29/2003
David A. Rapp (Reg. No.)
P.O. BOX 582, MADISON, OHIO 44057 (428-1238)

STATE OF OHIO
DAVID A. RAPP
7507
REGISTERED
PROFESSIONAL SURVEYOR
6/29/03

APPROVED
MADISON TOWNSHIP ZONING
DATE 7/11/03
BY 2463

CHUCK HUGHES
SILVERWOOD SUBDIVISION
Site Plan For Sublot 11