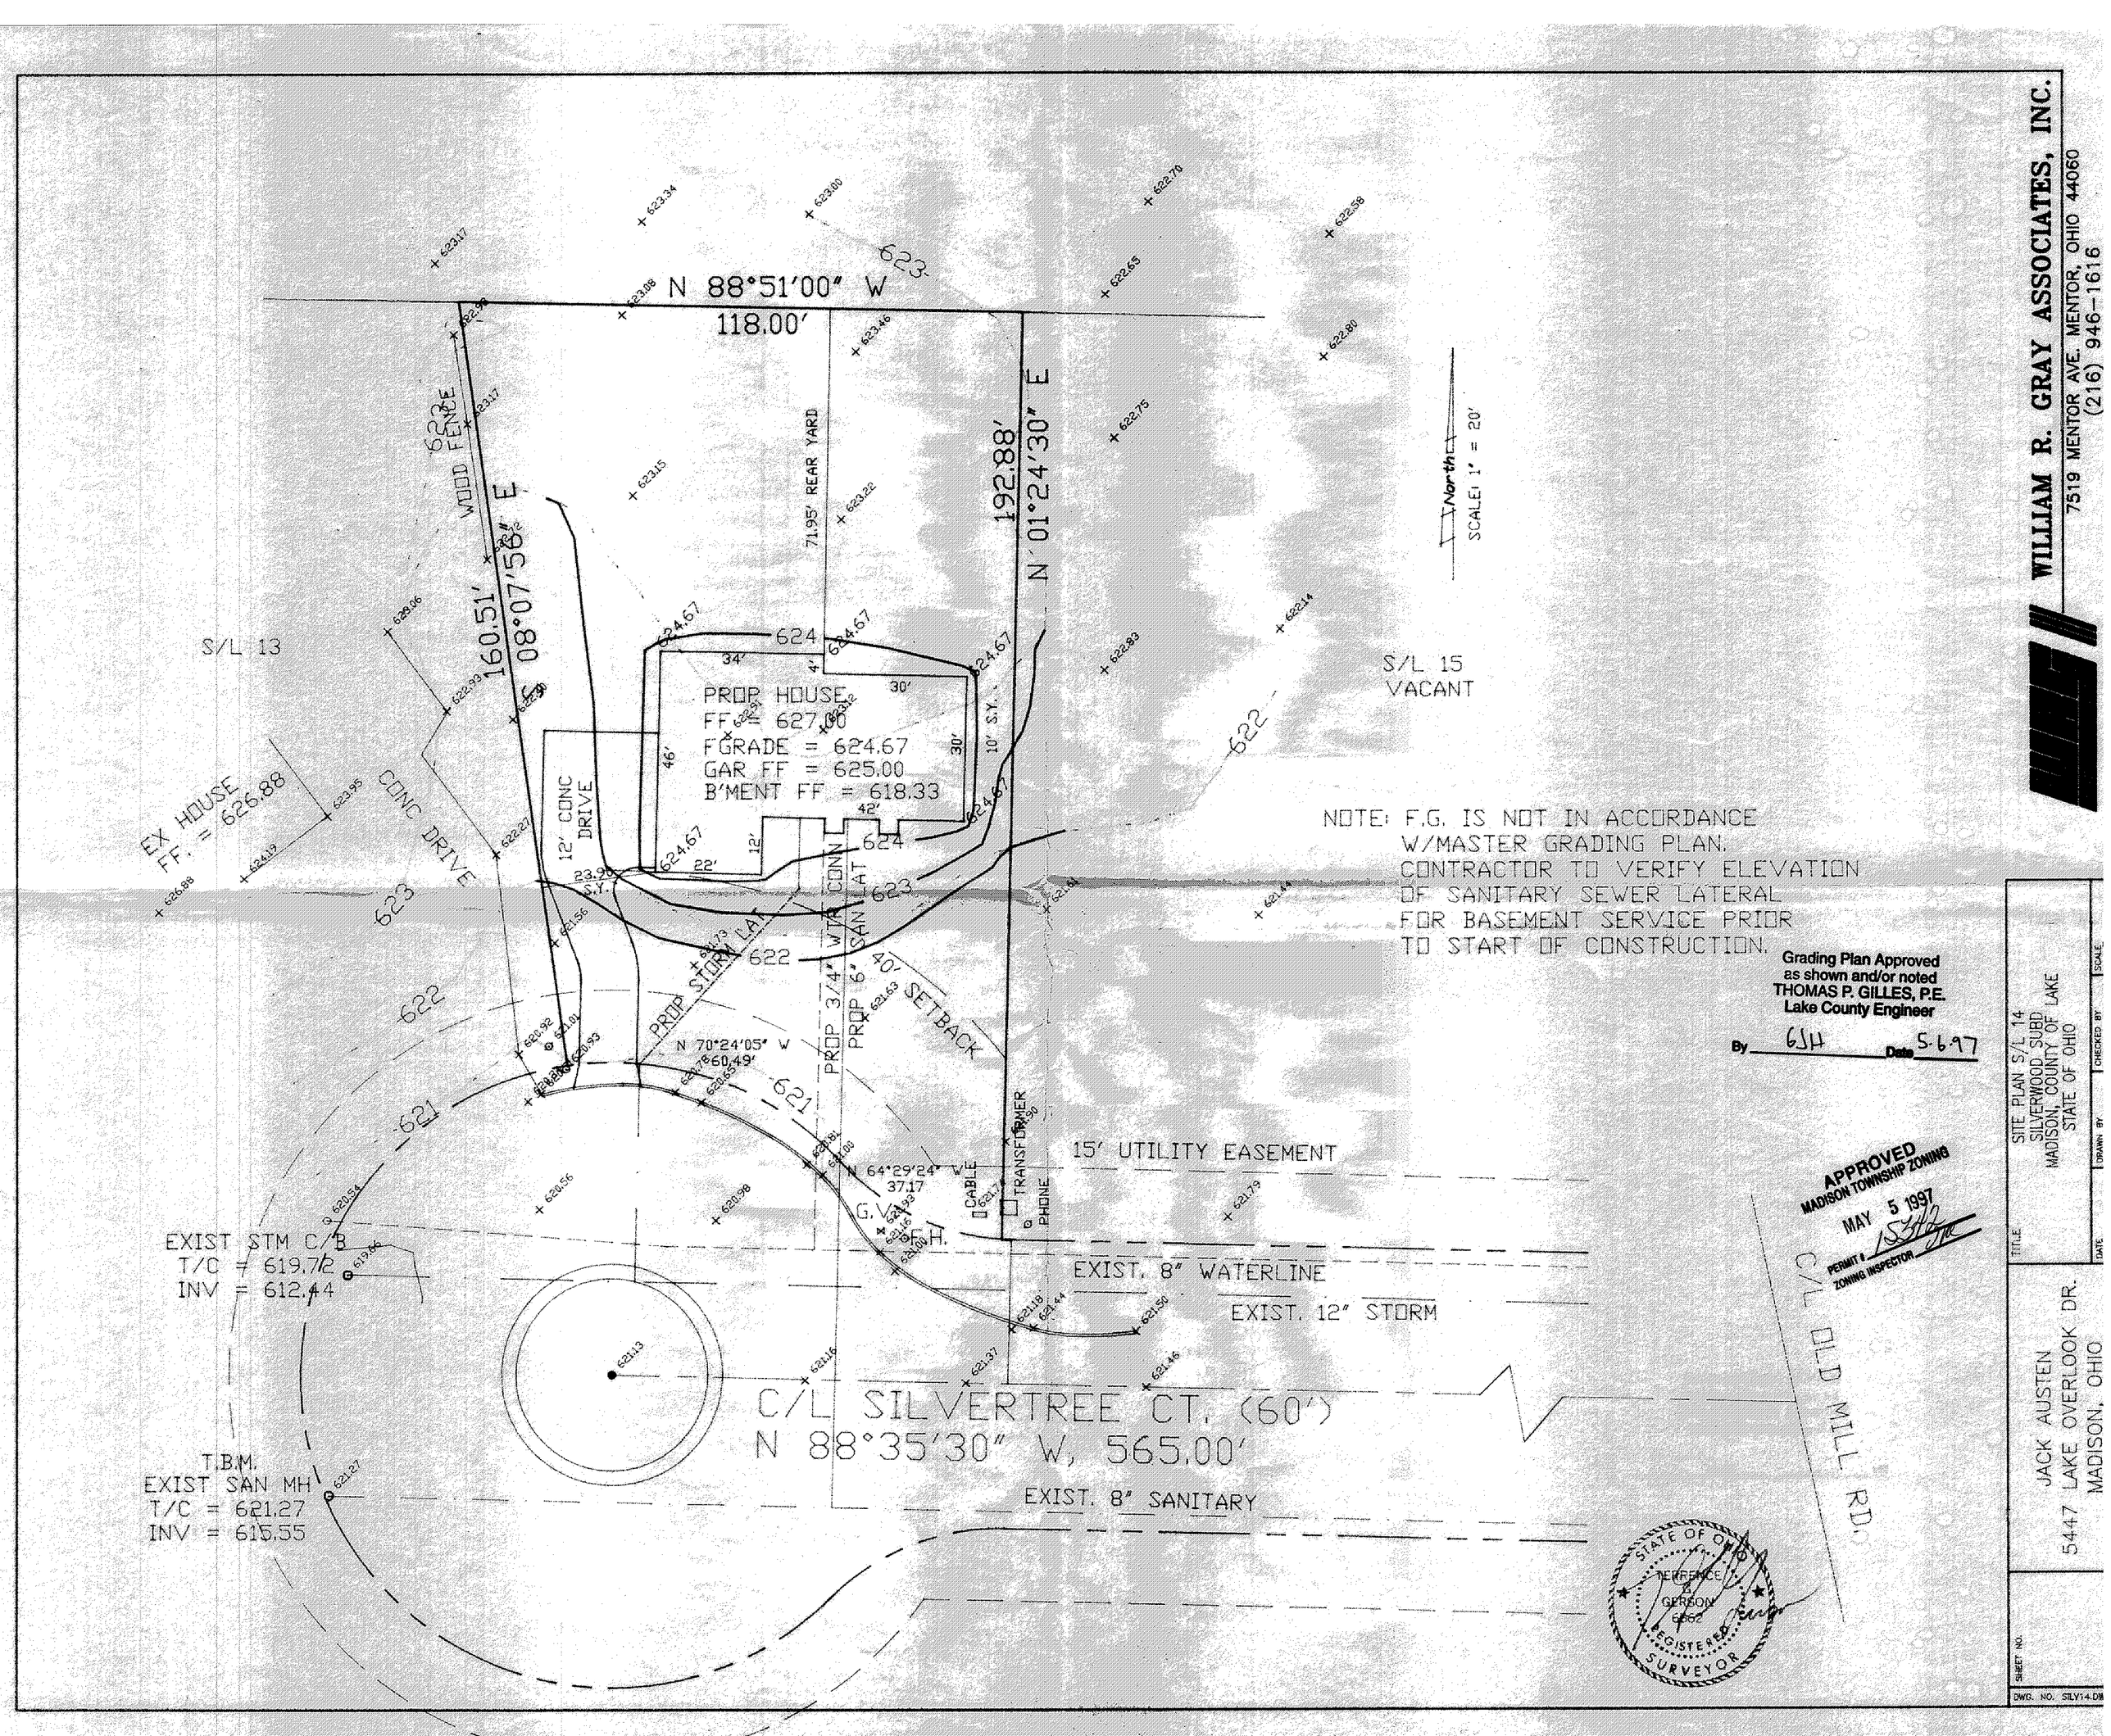

NOTE: F.G. IS NOT IN ACCORDANCE W/MASTER GRADING PLAN. CONTRACTOR TO VERIFY ELEVATION OF SANITARY SEWER LATERAL FOR BASEMENT SERVICE PRIOR TO START OF CONSTRUCTION.

Grading Plan Approved as shown and/or noted
THOMAS P. GILLES, P.E.
Lake County Engineer
By GJH Date 5-6-97

APPROVED
MADISON TOWNSHIP ZONING
MAY 5 1997
PERMIT # 15342
ZONING INSPECTOR

STATE OF OHIO
TERRENCE G. GERSON
6662
REGISTERED SURVEYOR

WILLIAM R. GRAY ASSOCIATES, INC.
7519 MENTOR AVE. MENTOR, OHIO 44060
(216) 946-1616

TITLE: SITE PLAN S/L 14
SILVERWOOD SUBD
MADISON, COUNTY OF LAKE
STATE OF OHIO

DATE | DRAWN BY | CHECKED BY | SCALE

JACK AUSTEN
5447 LAKE OVERLOOK DR.
MADISON, OHIO

SHEET NO.

DWG. NO. SILY14.DW