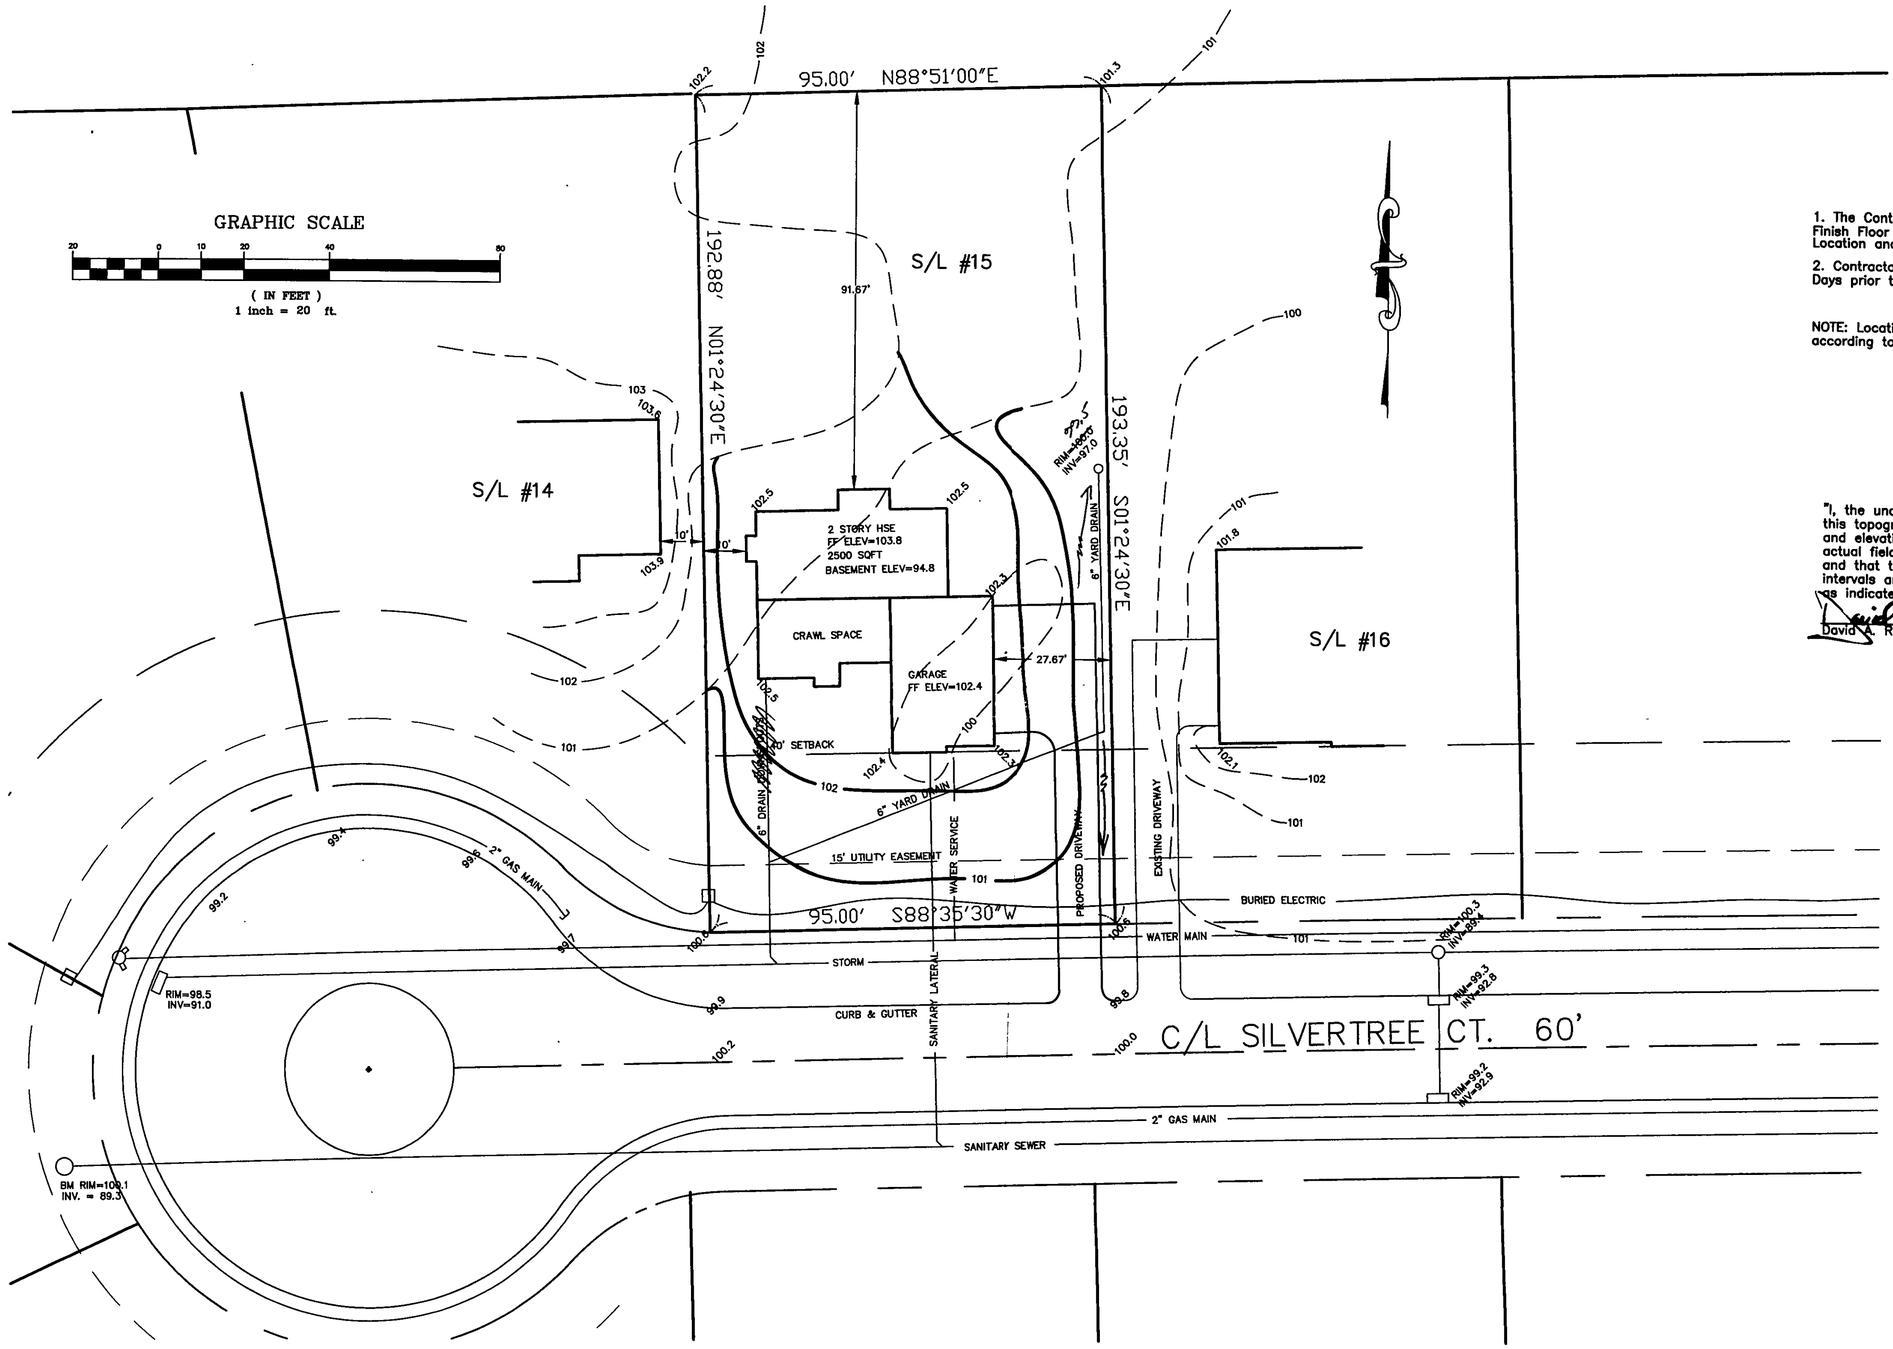

1. The Contractor Shall Verify the Following Before Starting: Finish Floor Elevations and House Size. Location and elevation of existing utility connections.

2. Contractor Shall Contact OUPS at least 2 Working Days prior to construction, 1-800-362-2764.

NOTE: Location of underground utilities are located according to the Lake County Engineers records on file.

"I, the undersigned hereby certify that this topography, indicated by 1' contours and elevations shown hereon represents an actual field survey made in April, 1999 and that the elevations were taken at appropriate intervals and that as of that date they existed as indicated hereon."

David A. Rapp — Reg. No. 2-23-2000

STATE OF OHIO — DAVID A. RAPP 7597 — REGISTERED PROFESSIONAL SURVEYOR

Grading Plan Approved as shown and/or noted
THOMAS P. GILLES, P.E.
Lake County Engineer

By TAM Date 2/24/2000

1. Swales as shown
2. Lower yard drain as noted
3. Reference Madison Twp. Zoning permit # 20020

A. ROOF DRAINS SHALL DISCHARGE TO SPLASH BLOCKS.

COR Consultants, Inc. 23 S. Forest St. Geneva, Ohio 44041 440-466-8085		DATE: FEBRUARY, 2000 DRAWN BY: RMO CHECKED BY: DAR APPROVED BY: DAR PS No. 7597	FRANK STARIC 1887 PAISLEY ROAD Madison, Ohio 44057	S/L 15 on SILVERTREE COURT SILVERWOOD SUBDIVISION	Hor. Scale / Vert. Scale CONTRACT No. 990180 SHEET No. 1 OF 1