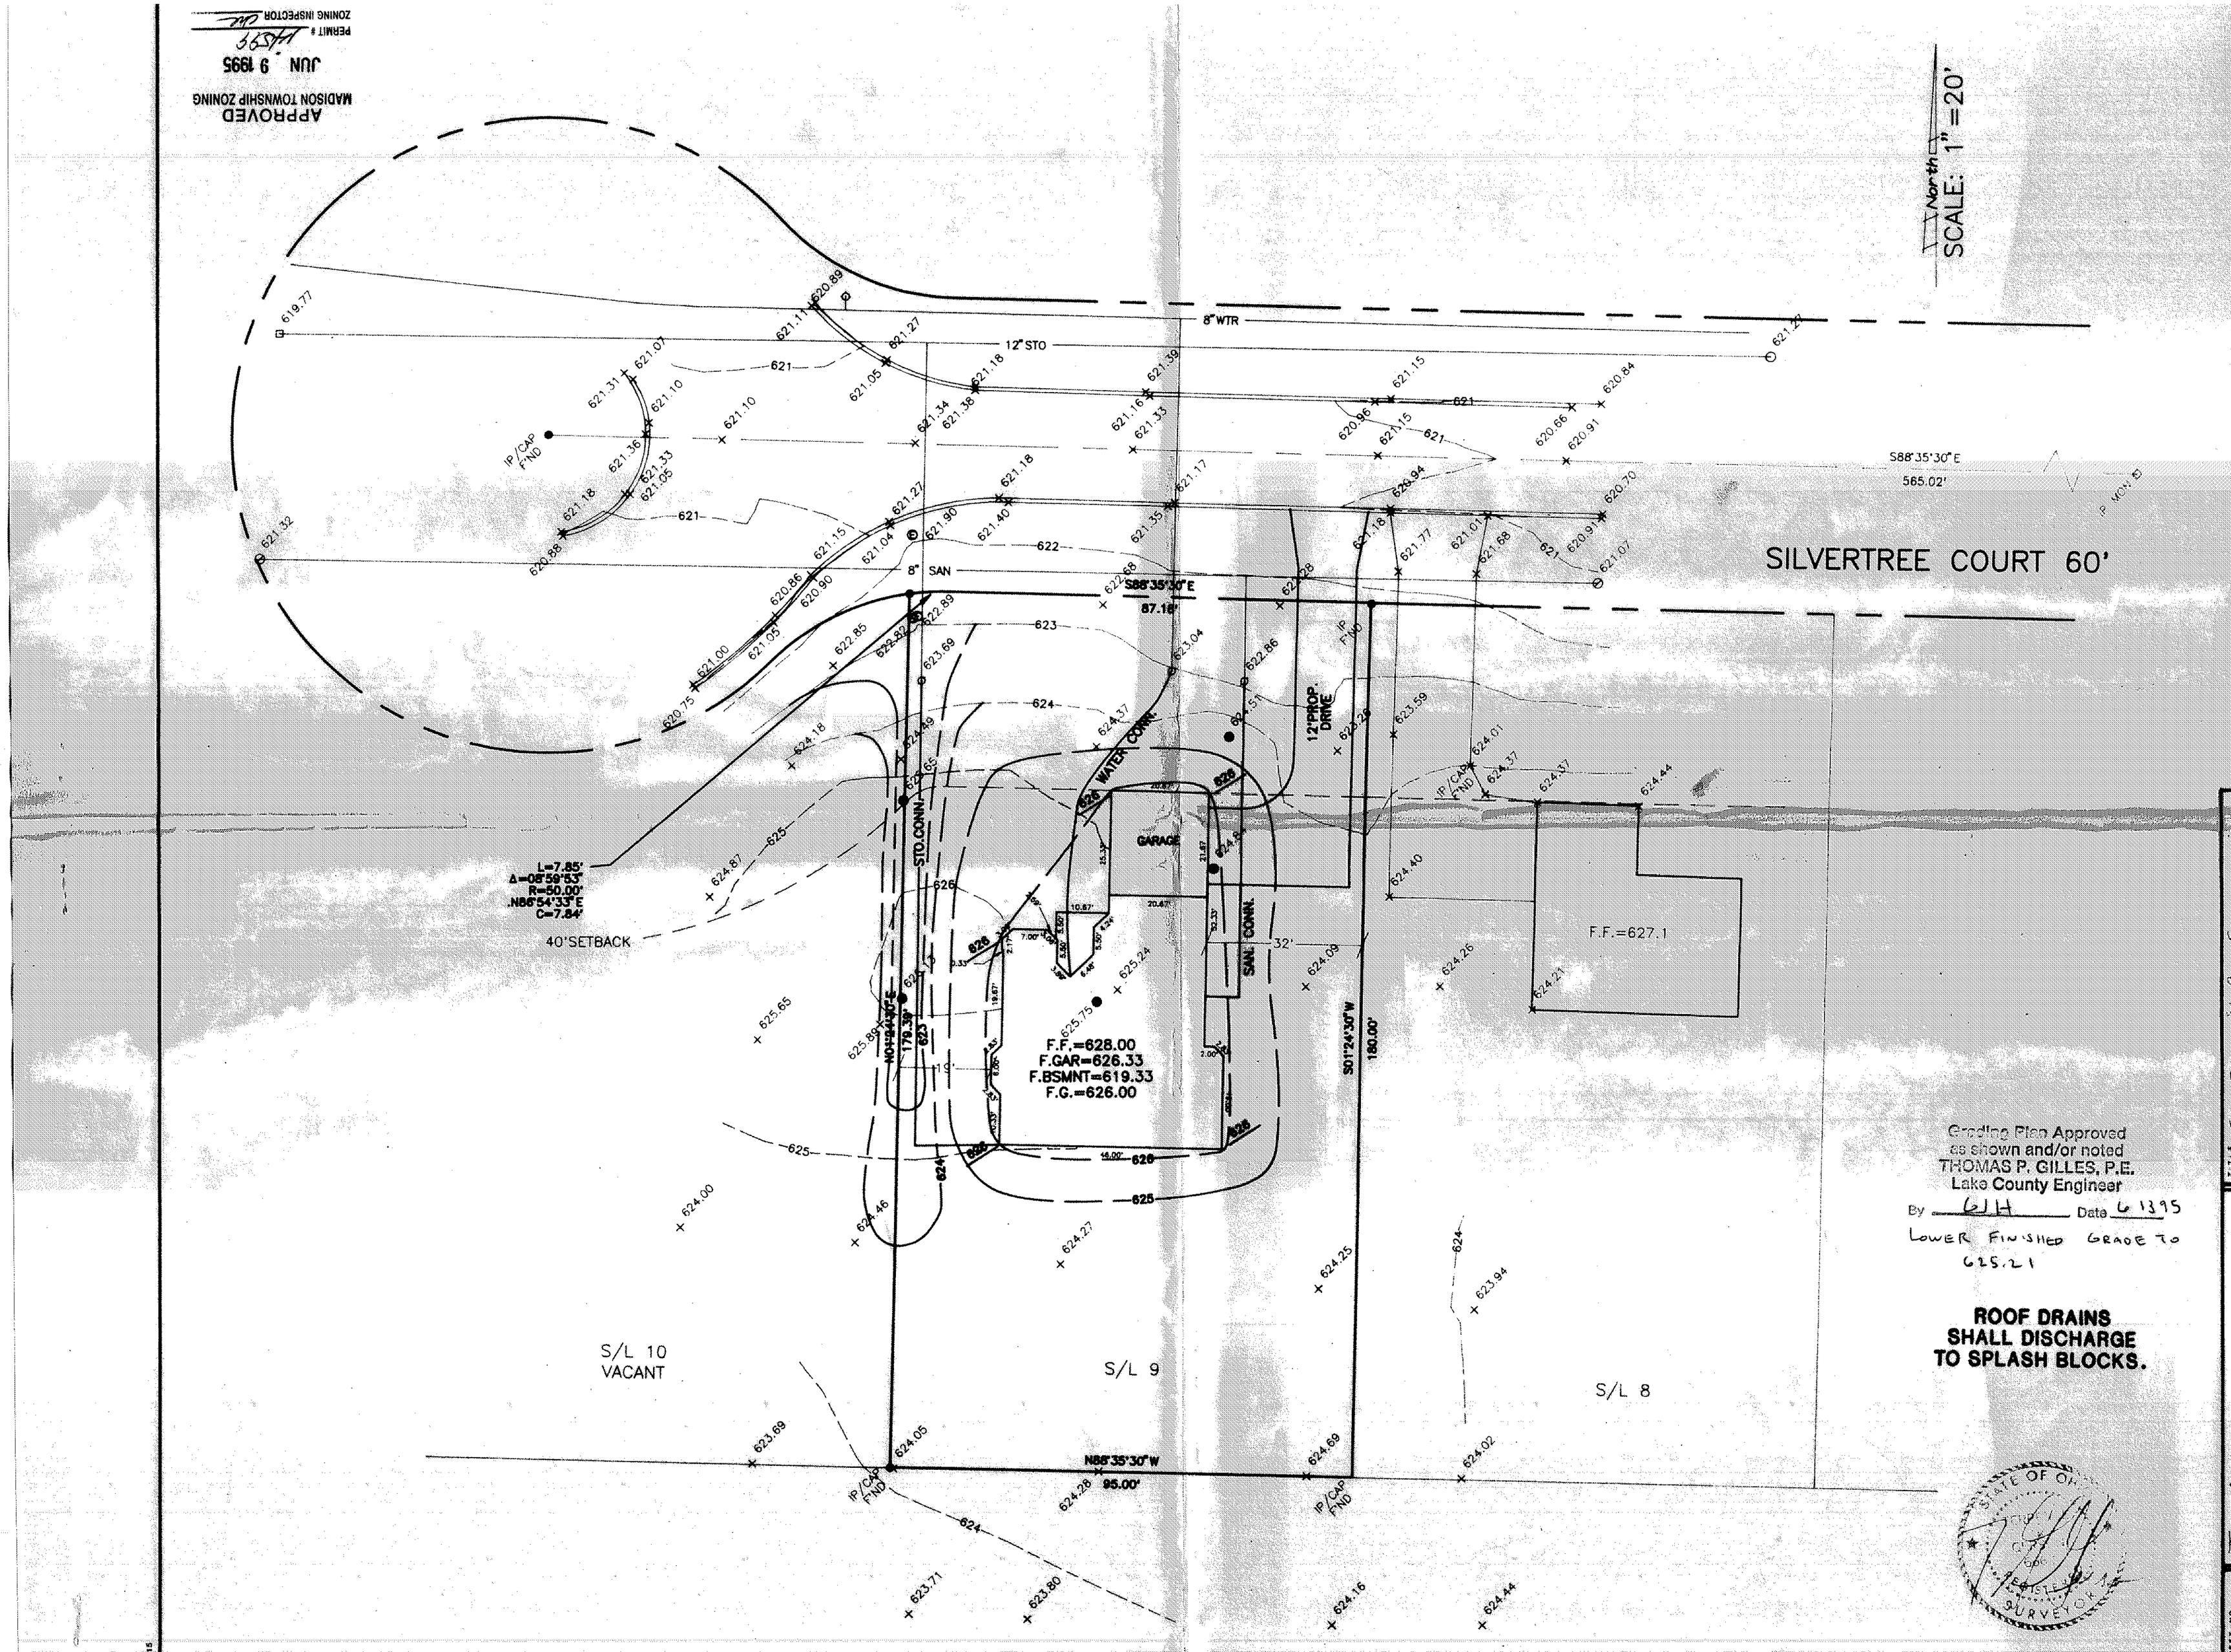

Grading Plan Approved
as shown and/or noted
THOMAS P. GILLES, P.E.
Lake County Engineer
By GJH Date 6 13 95
LOWER FINISHED GRADE TO
625.21

ROOF DRAINS SHALL DISCHARGE TO SPLASH BLOCKS.

WILLIAM R. GRAY ASSOCIATES, INC.
MENTOR, OHIO 44060 946-1616

TITLE Site Plan S/L 9 - Silverwood Subdivision
DATE 7 Jun 95
DRAWN BY JSD
REV
JACK AUSTEN
5447 LAKE OVERLOOK DR.
MADISON, OHIO