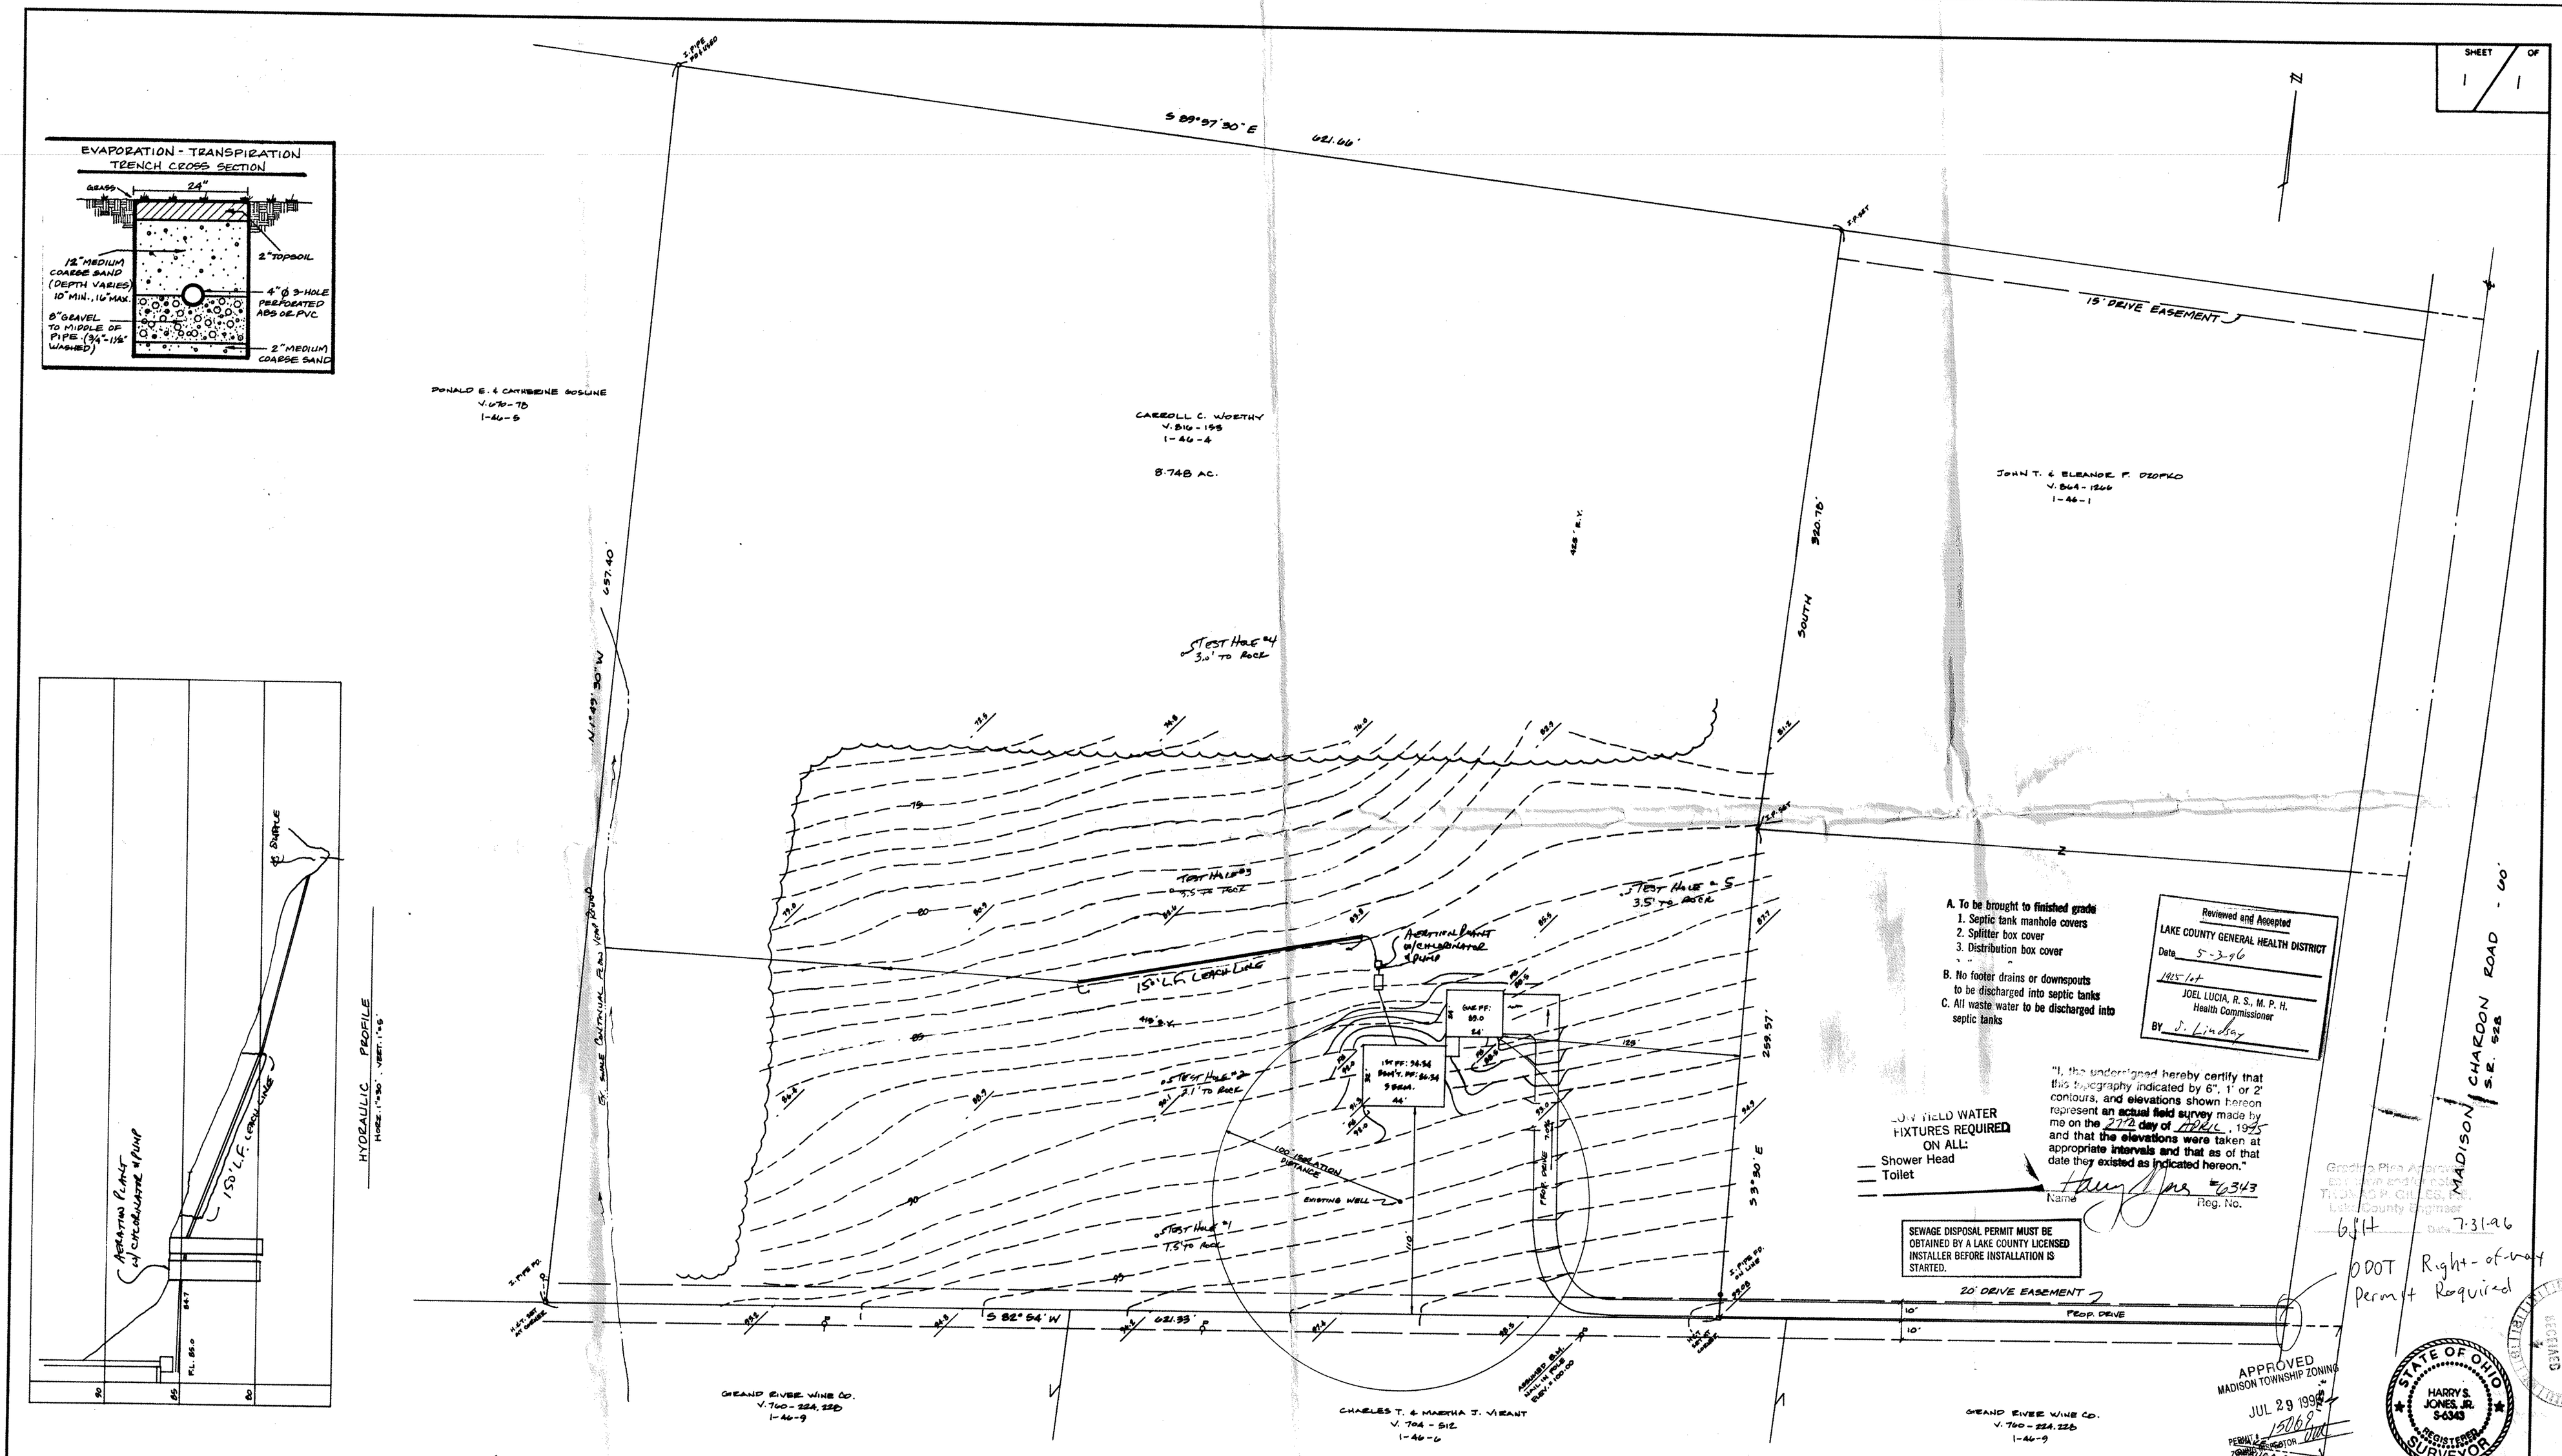

REV NO.	DESCRIPTION	DATE	BY	CHK'D
1	Revised septic system	4-28-96	HT	HT

SITE PLAN
FOR
DON JACOBSON

BABCOCK, JONES AND ASSOCIATES, INC
CIVIL ENGINEERS - SURVEYORS - LAND PLANNERS
PAINESVILLE OHIO 44077

DATE 5/3/95
DESIGN BY HT
DRAWN BY ϕ
APPROVED BY HT

BEING A PART OF ORIGINAL LOT 3, TRACT II MADISON TOWNSHIP
LAKE COUNTY, OHIO
PP # 1-46-4 V. 816-153

SCALE 1"=40'
JOB NO 95-085
SHEET 1 OF 1