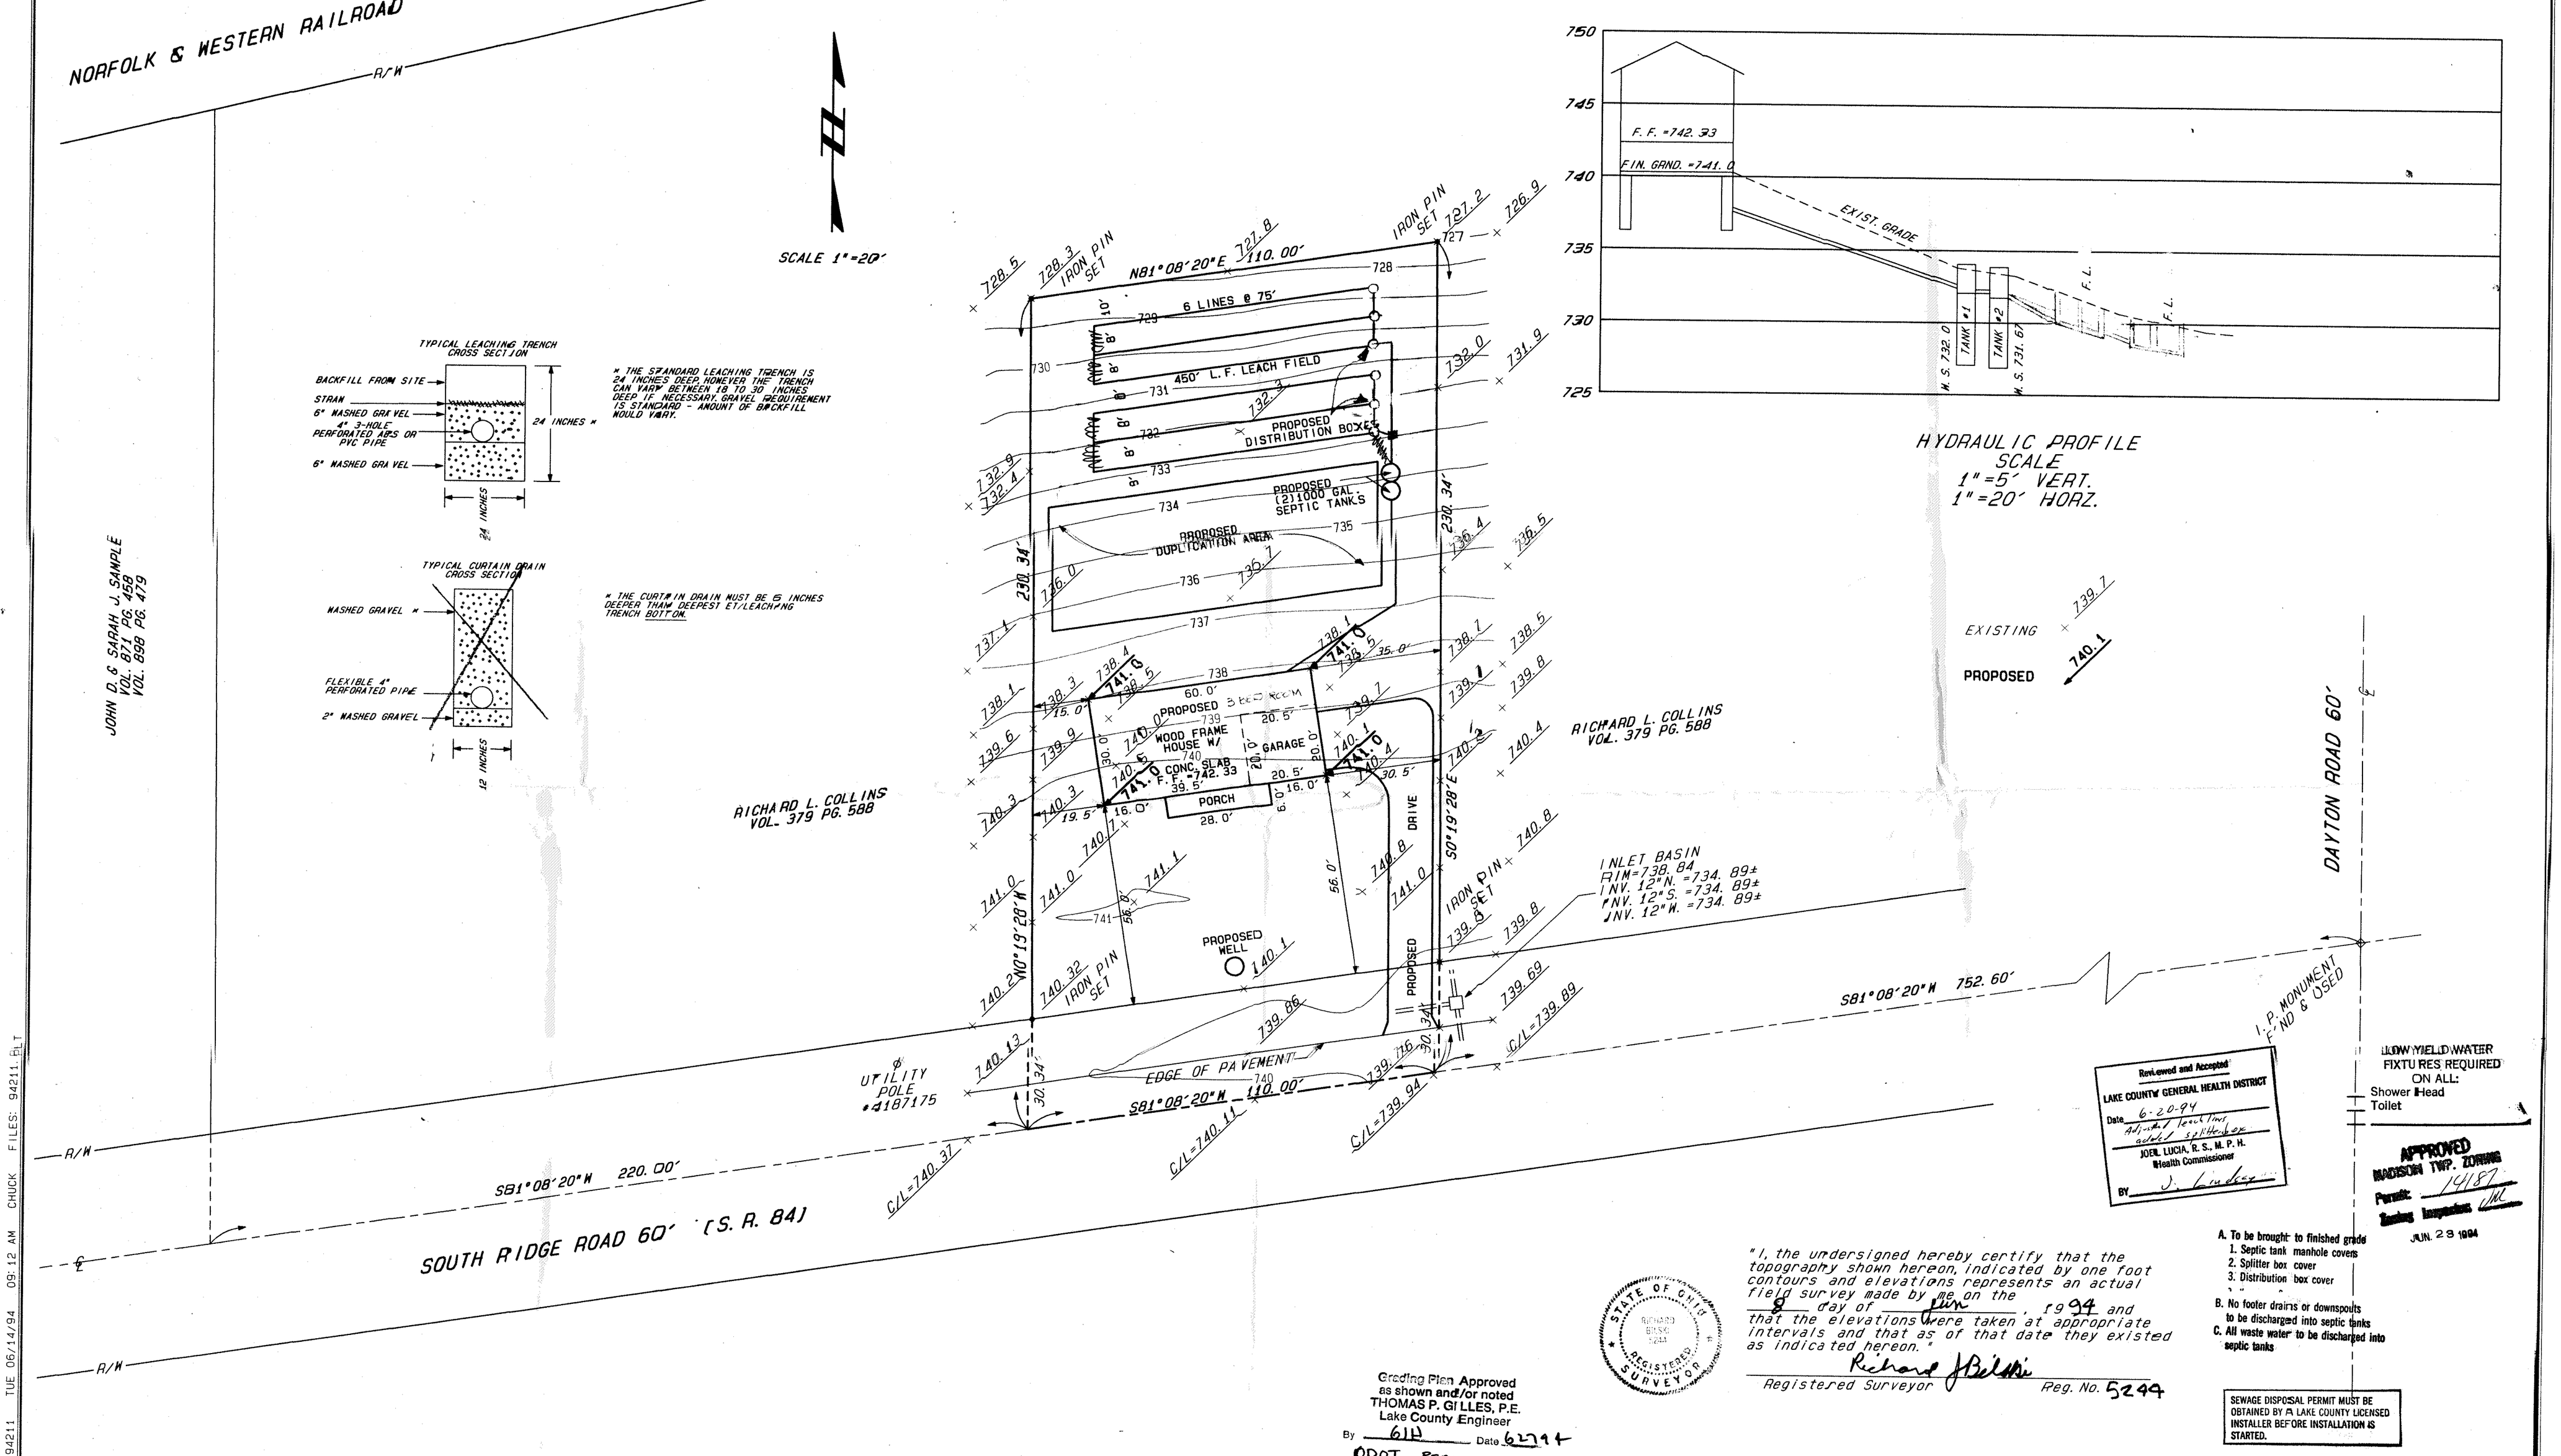

C T Consultants, Inc.
Engineers · Architects · Planners
Willoughby · Mentor · Columbus · North Canton · Youngstown

REV. NO.	DESCRIPTION	DATE	BY	CHECKED

DATE: JUNE, 1994
DRAWN BY: C. A. B.
CHECKED BY: T. P. H.
APPROVED BY: R. J. B.

SITE PLAN
FOR
JOHN D. SAMPLE
BEING A PART OF ORIGINAL LOT 13, TRACT 3
MADISON TOWNSHIP, LAKE COUNTY, OHIO

SCALES
HOR. 1" = 20'
VERT.
CONTRACT No. 94-211
SHEET NO. OF