


**EROSION AND SEDIMENT CONTROL SCHEDULE**

- 1.) **INGRESS-EGRESS**  
A stone access drive complete with under lying geo-textile fabric (20 feet wide and 50 feet long) for ingress and egress at the site shall be installed. The drive shall be the only entrance and exit to the site.
- 2.) **SILT FENCE**  
A silt fence shall be installed prior to any earthwork activities at the site in the locations shown on the site plan as well as along the front of any lot that slopes towards the street.
- 3.) **TEMPORARY SEEDING**  
Disturbed areas of the site that are to remain idle for more than twenty-one (21) days shall be properly seeded and straw mulched within seven (7) days of completion of initial grading. Temporary seeding and mulching on a thirty (30) foot strip of the entire front of the lot shall be maintained on the site once initial grading is complete.  
Stabilization of critical areas within fifty (50) feet of any stream or wetland shall be complete within two (2) days of the disturbance if the site is to remain inactive for longer than fourteen (14) days.

- 4.) **MULCHING**  
Straw-mulch shall be applied at a rate of 1 bale per every ten (10) feet of curb, at a width of thirty (30) feet of the entire length of the lot. Wood chips may also be used but must be spread to a minimum depth of four inches over the thirty foot width and must be accompanied by a properly installed silt fence.
- 5.) **MAINTENANCE**  
Erosion and sediment controls shall be inspected every seven (7) days or within twentyfour (24) hours of a 0.5" or greater rainfall event. Necessary repairs shall be made at this time.

**NOTES:**  
Unable to verify location of water line. Sewer and water connections are to be verified at time of construction.  
Lake County Sediment & Erosion regulations apply.  
Storm Water provisions apply.

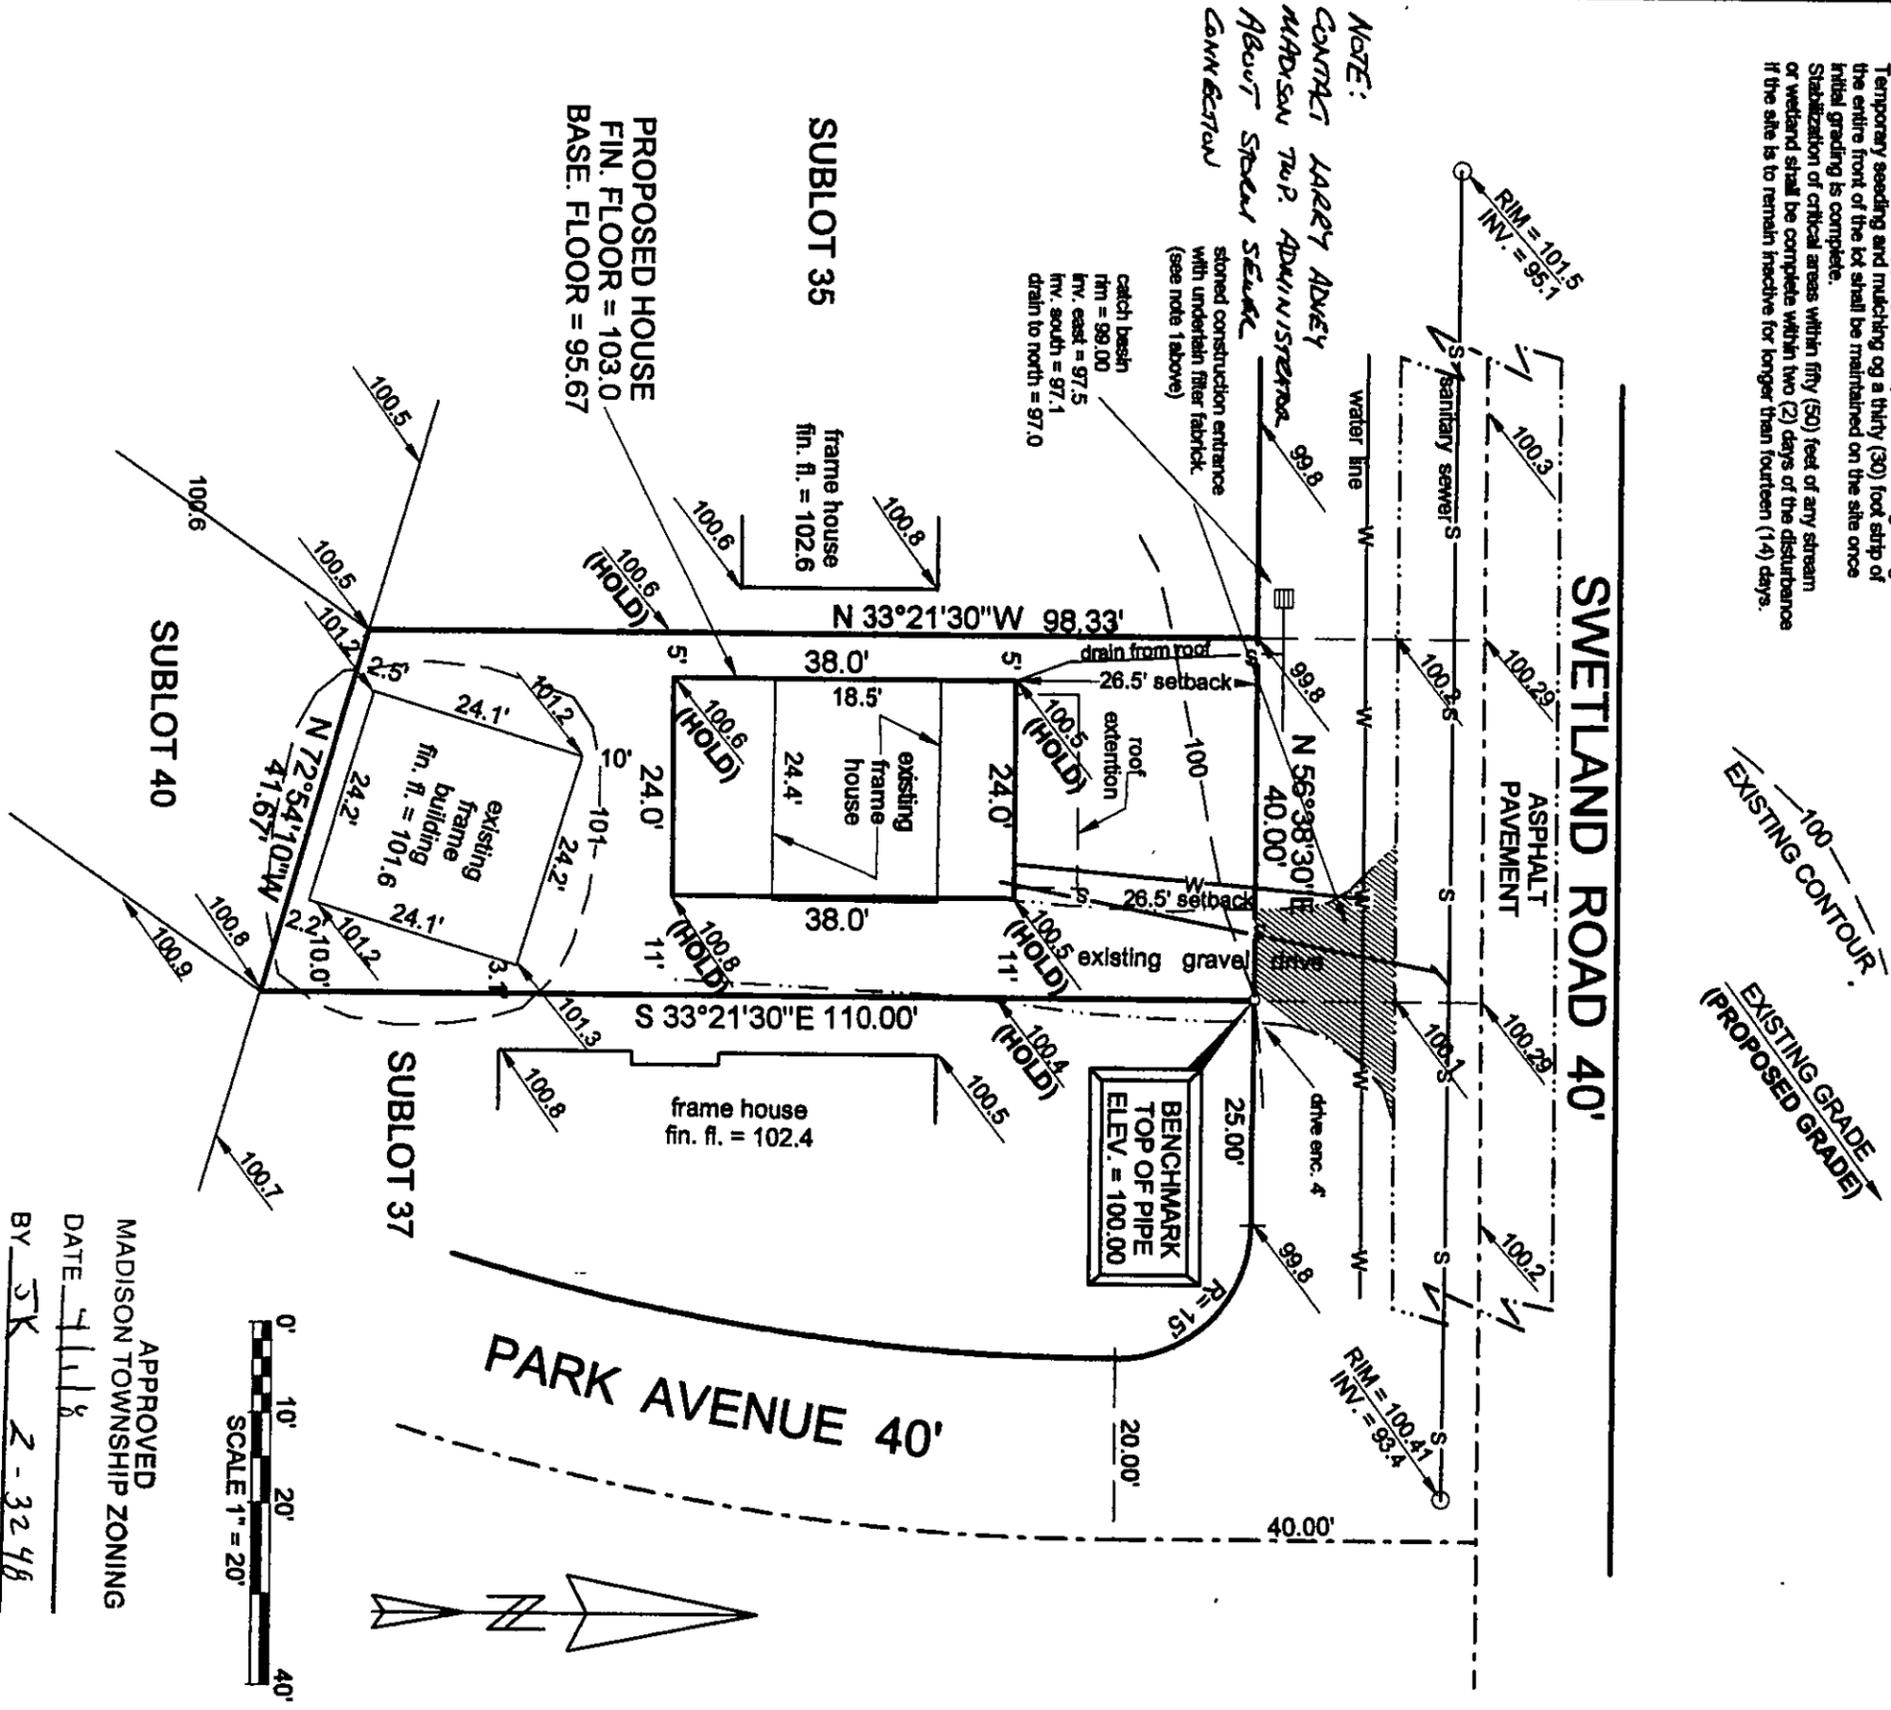

**SITE PLAN FOR JOE KRAUTER**

KNOWN AS BEING SUBLLOT 36 IN THE LAKE BREEZE PARK COMPANY'S MADISON LAKELAND SUBDIVISION TOWNSHIP OF MADISON

Stormwater Management Plan Approved by the BOARD OF DATE OF OHIO JAMES R. GILL S. PE

County Drainage Engineer, By LS Date 4/2/08

"I, THE UNDERSIGNED HEREBY CERTIFY THAT THE TOPOGRAPHY SHOWN HEREON, INDICATED BY SPOT ELEVATIONS, REPRESENTS AN ACTUAL FIELD TOPOGRAPHIC SURVEY PERFORMED BY ME ON THE 15th DAY OF FEBRUARY, 2008 AND THAT THE ELEVATIONS WERE TAKEN AT APPROPRIATE INTERVALS AND THAT AS OF THAT DATE THEY EXISTED AS INDICATED HEREON."

JAMES A. ZIEMBA, PROFESSIONAL SURVEYOR #7034  
BENCHMARK SURVEY COMPANY  
5999 SOUTH RIDGE ROAD  
MADISON, OHIO 44057  
1-440-428-8599  
FEBRUARY 15, 2008  
REVISED MARCH 31, 2008

