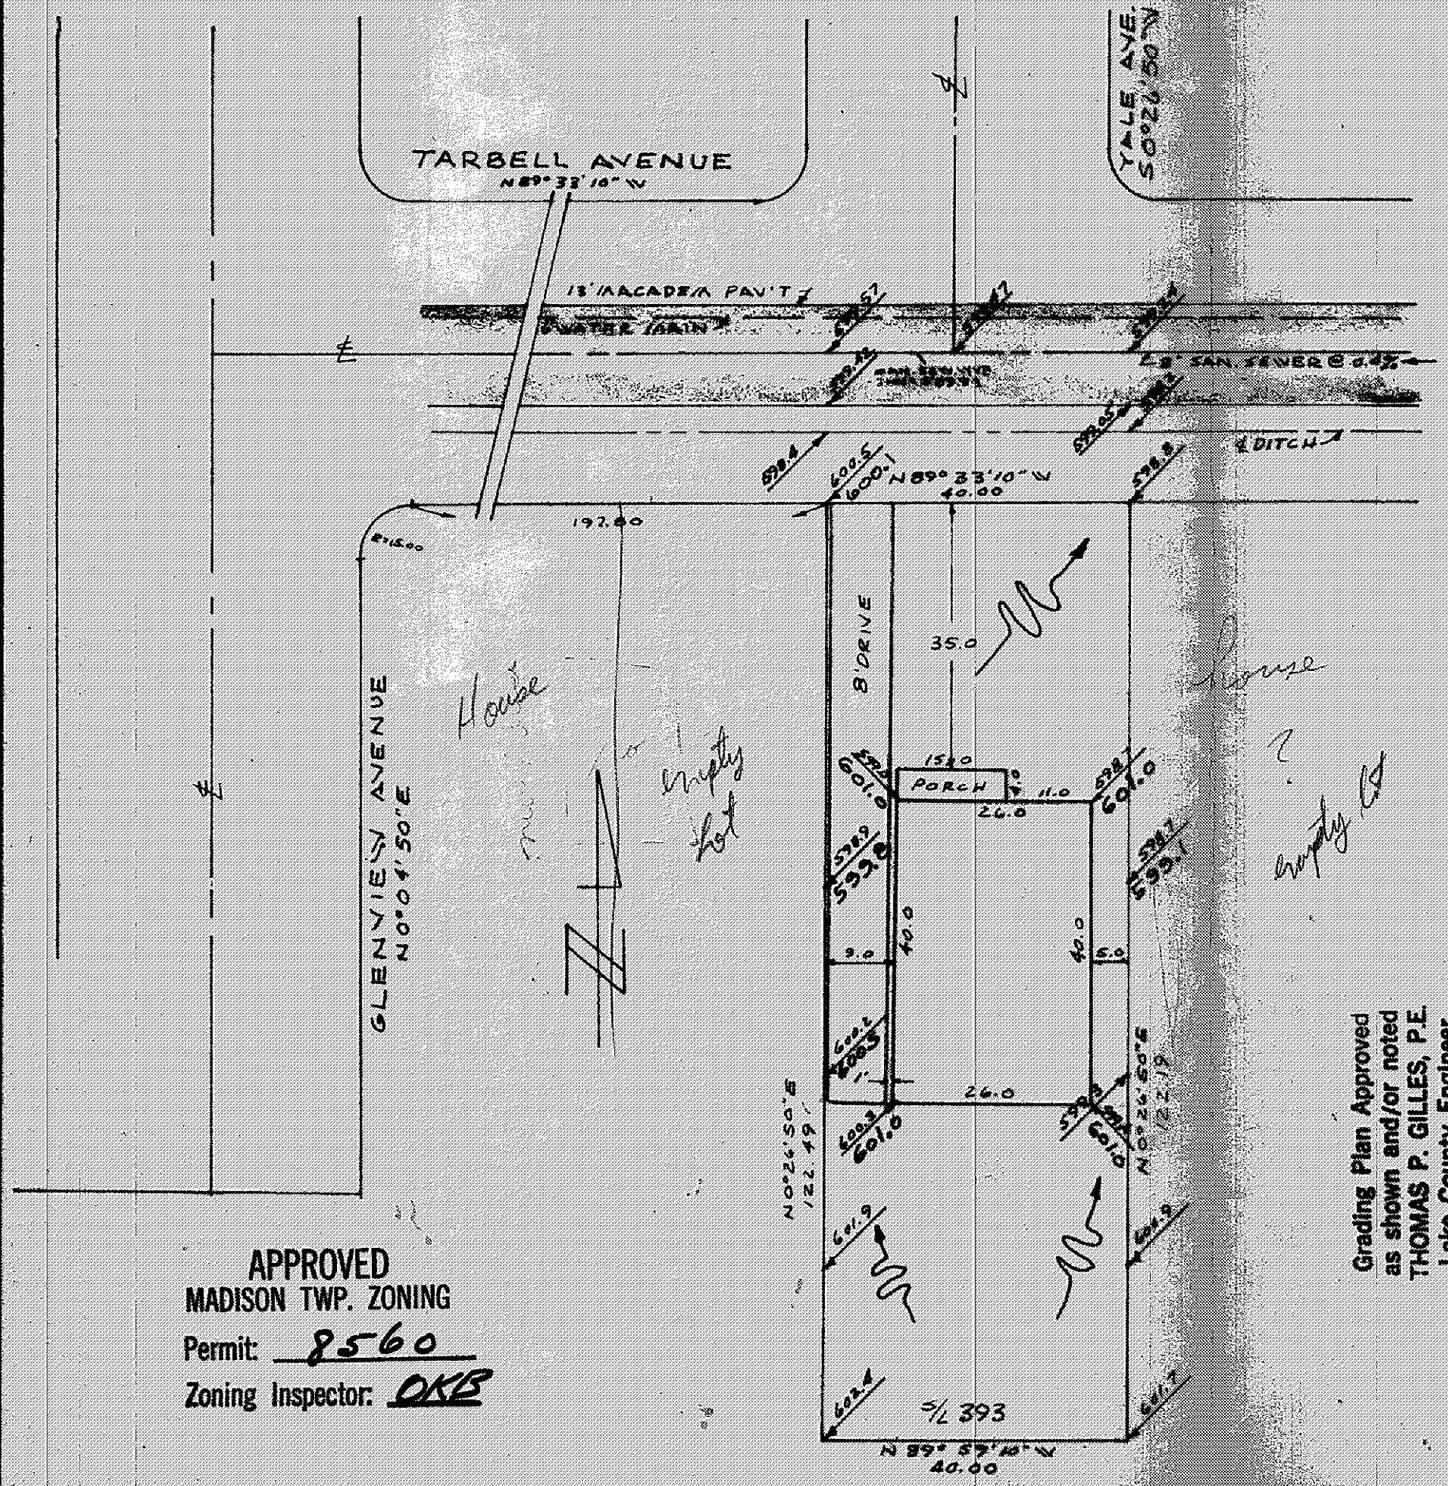

APPROVED
MADISON TWP. ZONING
Permit: 8560
Zoning Inspector: OKB

Grading Plan Approved as shown and/or noted
THOMAS P. GILLES, P.E.
Lake County Engineer
By [signature] Date 14 Aug 72

SITE PLAN

MADISON (TOWNSHIP) LAKE COUNTY, OHIO

for RYAN HOMES (CLIENT) (OWNER)

6548 Tarbell Madison 44057
ADDRESS STREET CITY ZIP

MADISON LAKELAND	
RECORD SUBDIVISION	
D	52
VOLUME	PAGE
393	TARBELL AVE
SUBLOT NO	STREET

LOT	TRACT
VOLUME	PAGE
PERM PARCEL #	STREET

LEGEND

SANITARY MANHOLE
STORM MANHOLE
INLET OR CATCH BASIN
HYDRANT
EXISTING CONTOURS
PROPOSED CONTOURS
EXIST ELEV 100.0 / 100.0 PROP ELEV

WATER VALVE (GAS)
WATER METER (GAS)
AS BUILT ELEVATION
DIRECTION OF SURFACE DRAINAGE

REMARKS

ALL BOUNDARY DATA SHOWN WAS OBTAINED FROM (DEEDS RECORDED SUBDIVISION PLAT OR OTHER PUBLIC RECORDS)

DESIGN CERTIFICATION

THIS PLAT WAS PREPARED BY ME, AND IS CORRECT TO THE BEST OF MY KNOWLEDGE AND BELIEF

Richard R. Hegfield P.S. #5506
NAME SURVEYOR REGISTRATION NO.

CHECK LIST

DIMENSIONS
BEARINGS
TIE TO NEAREST STREET
SUBLOT NO PARCEL NO
SURROUNDING OWNERS
BLDG DIMENSIONS FIN GR
BLDG TIES FLR GRADES
APRON TYPE WIDTH THICKNESS
SIDEWALK TYPE WIDTH THICKNESS
CULVERT TYPE DIA LENGTH

WATER MAIN SIZE LOCATION
SAN SEWER SIZE % GR LOC
SAN MH CAST ELEV INV ELEV
SAN CONN SIZE LOC DEPTH
STORM SEWER SIZE % GR LOC
STORM MH CAST ELEV INV ELEV
PAVT TYPE GRADE CURBS
GAS LINE LOC SIZE PRESSURE
SEPTIC TANK SIZE LOC
WELL LOCATION

REVISIONS		
NO	DATE	BY
1		
2		
3		
4		
5		

PLAN PREPARED BY:

DEBEVEC-SALO & ASSOC, INC.
CIVIL ENGINEERS SURVEYORS NAME
130 E JACKSON ST PAINESVILLE, O.
ADDRESS

DRAWN BY SHARTZ	SCALE 1" = 20'	PHONE NO
CHK'D R.H.	DATE 6-20-72	DRAWING NO 3528
CREW CHIEF	APP'D	

11X17 PRINTED ON NO. 1000H CLEARPRINT