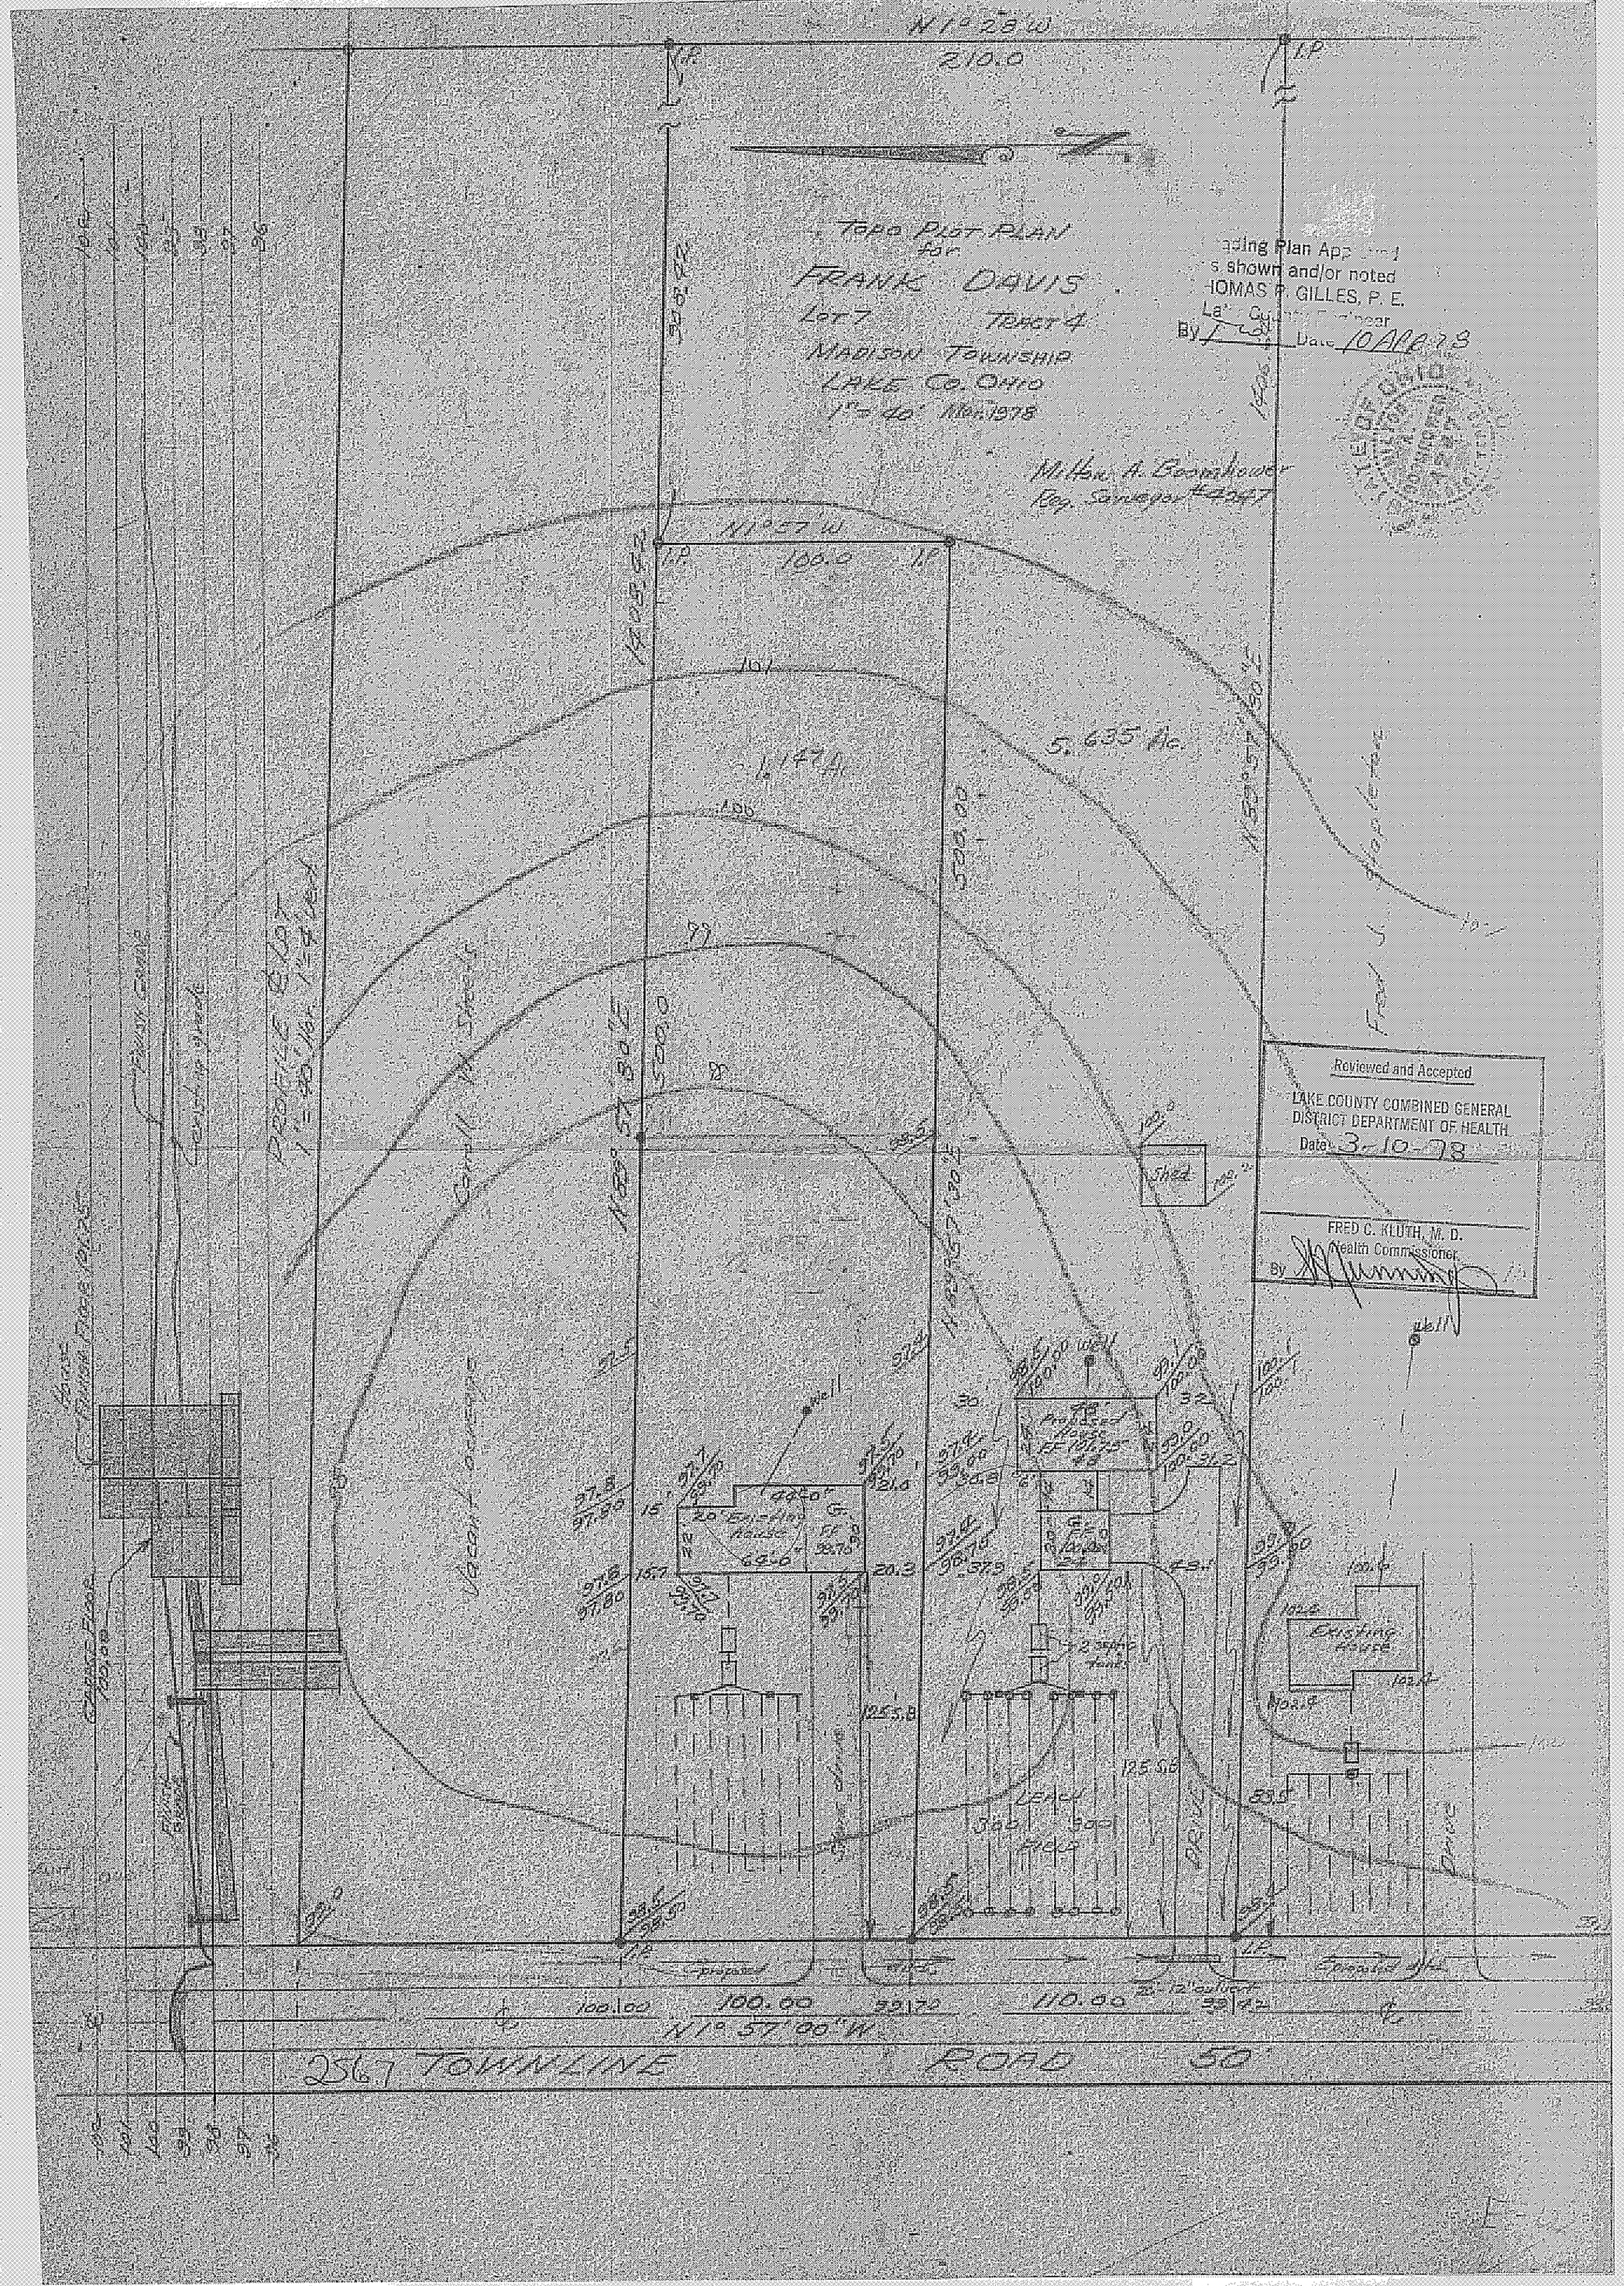
N1°28'W
210.0
I.P.
Topo Plot Plan
for
FRANK DAVIS
Lot 7 Tract 4
MADISON TOWNSHIP
LAKE Co. OHIO
1"=40' Mar. 1978
Mike A. Bamhauer
Reg. Surveyor #4217
Plan App
s shown and/or noted
HOMAS P. GILLES, P. E.
By
Date 10 Apr 78
N1°57'W
100.0
5.635 Ac.
1.147 Ac.
Reviewed and Accepted
LAKE COUNTY COMBINED GENERAL
DISTRICT DEPARTMENT OF HEALTH
Date 3-10-78
FRED C. KLUTH, M. D.
Health Commissioner
By
Shed
Existing House
N1°57'00"W
2567 TOWNLINE ROAD 50'