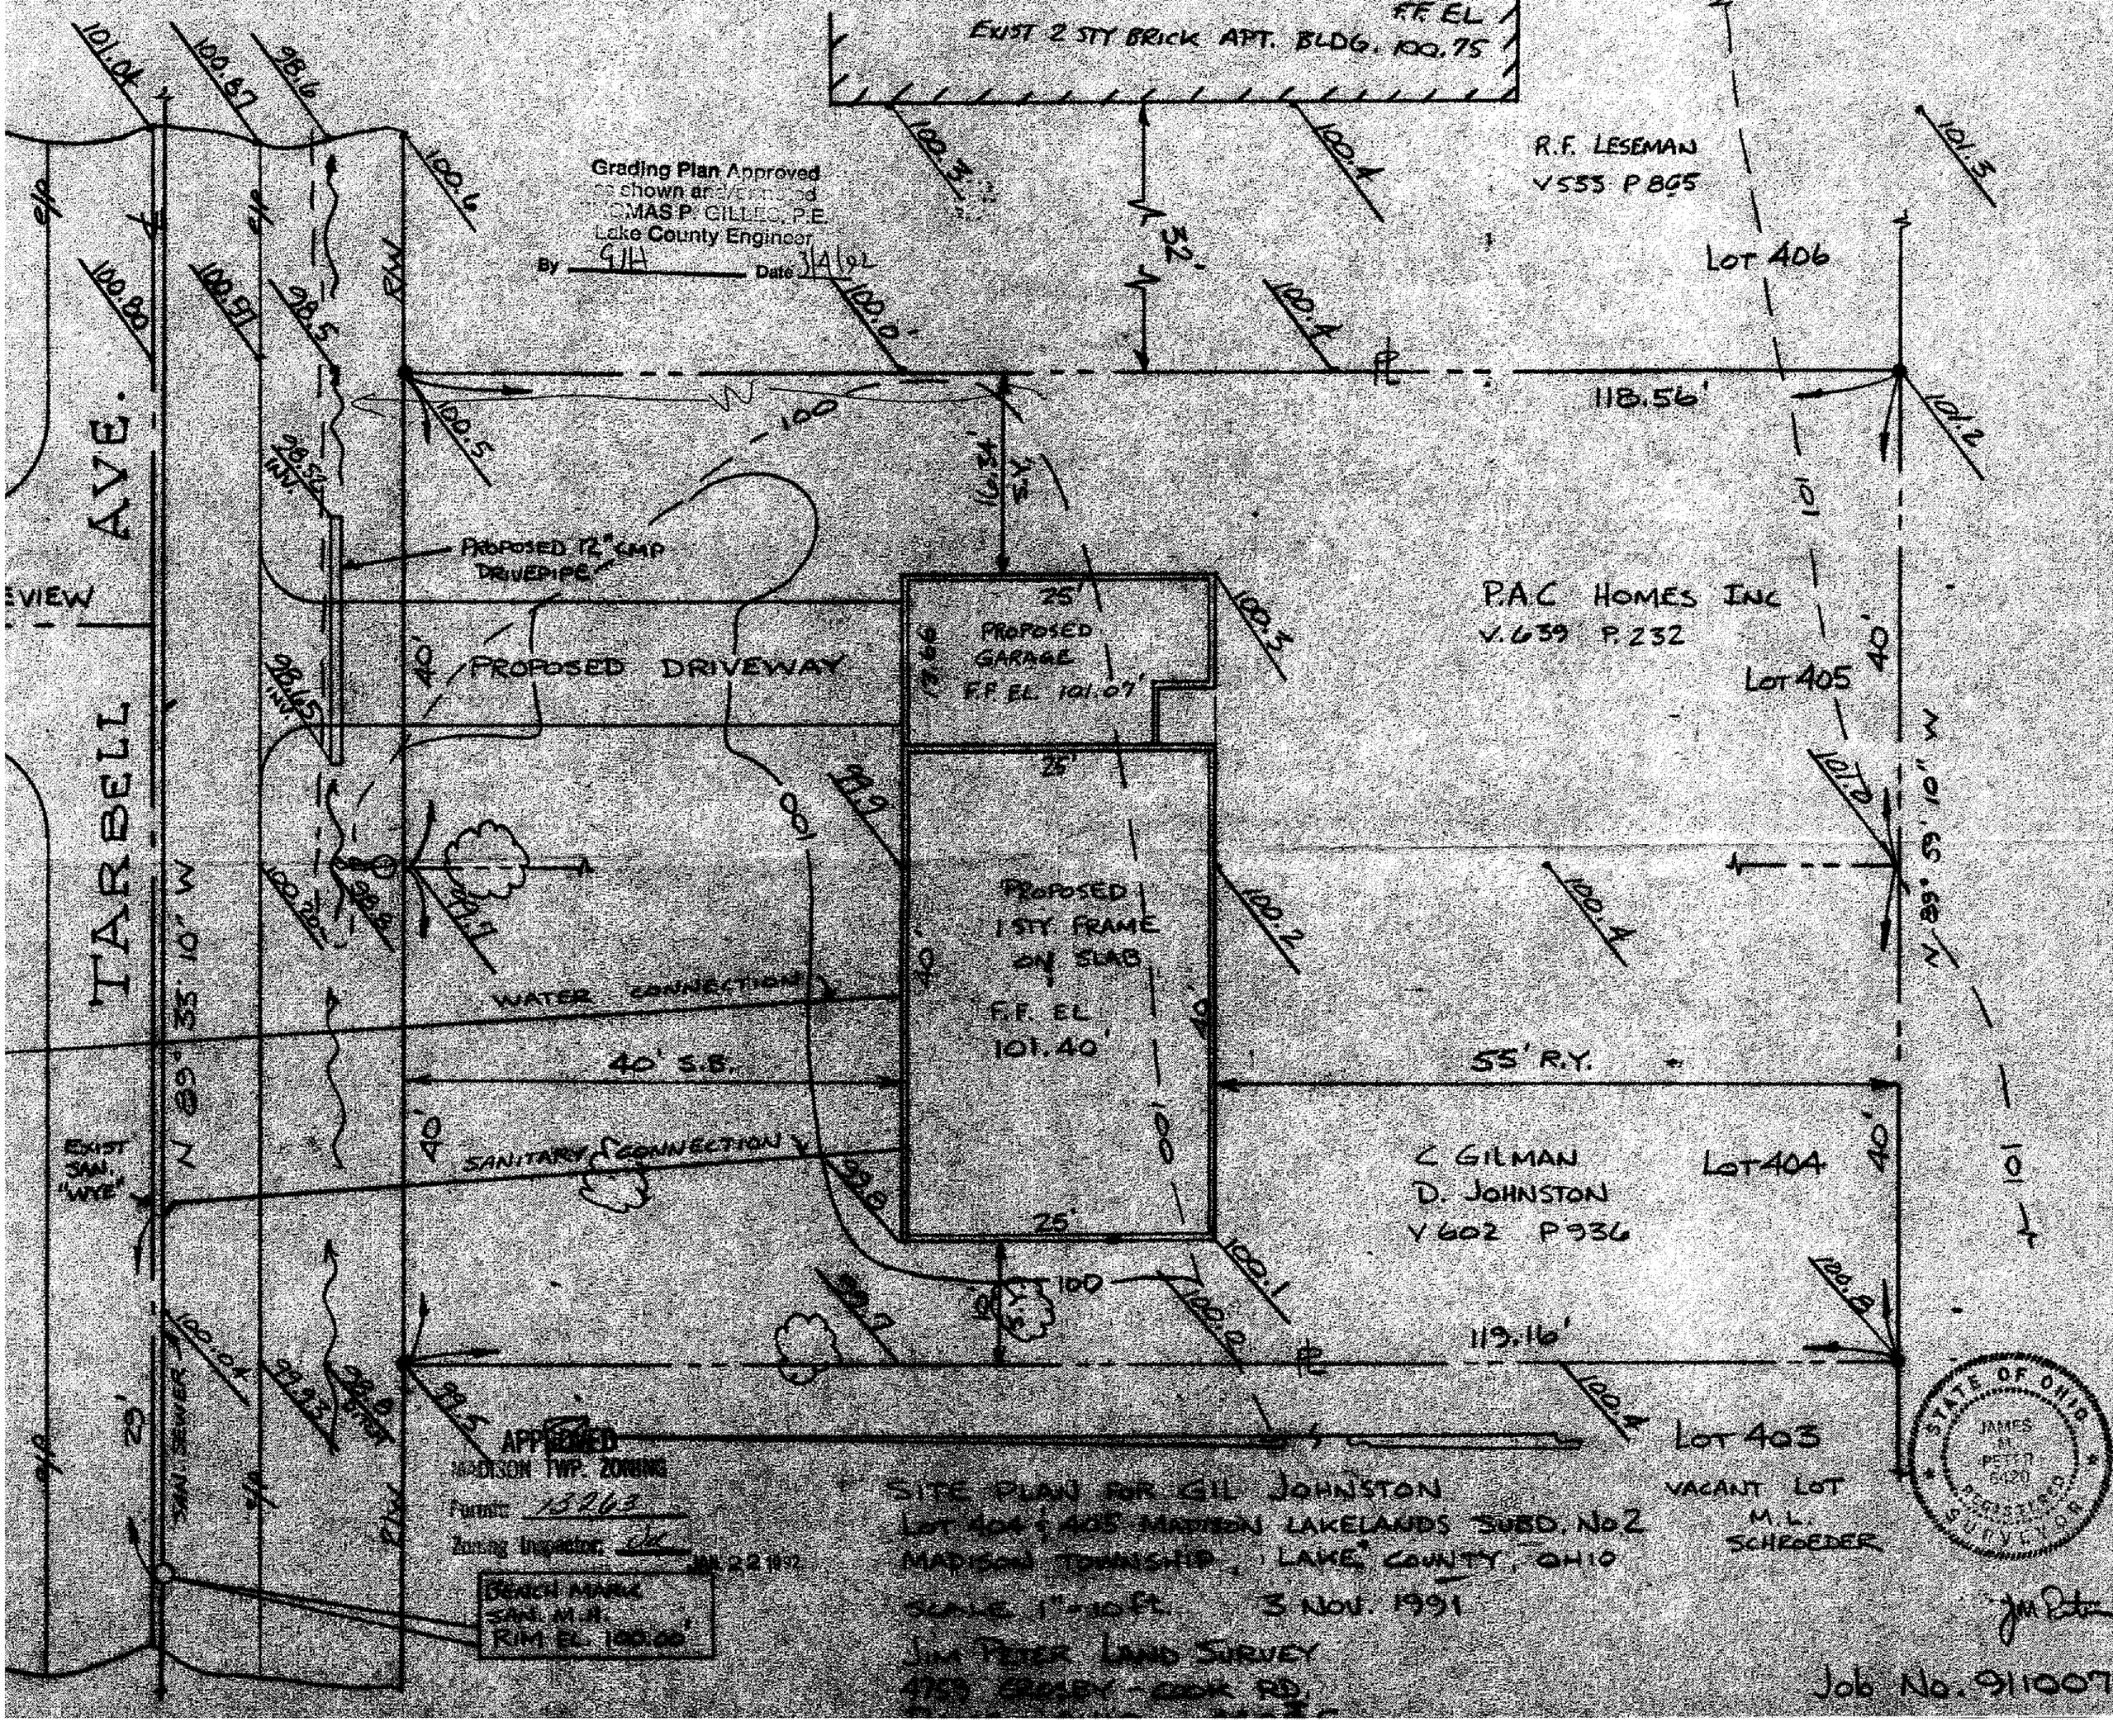

Grading Plan Approved
as shown and/or noted
THOMAS P. GILLES, P.E.
Lake County Engineer
By GJH Date 3/4/92
EXIST 2 STY BRICK APT. BLDG. 100.75
F.F. EL
R.F. LESEMAN
V 553 P 865
LOT 406
118.56'
TARBELL AVE.
PROPOSED 12" CMP DRIVEPIPE
PROPOSED DRIVEWAY
PROPOSED GARAGE
F.F. EL 101.07'
P.A.C HOMES INC
V. 639 P. 232
LOT 405
PROPOSED 1 STY. FRAME ON SLAB
F.F. EL 101.40'
WATER CONNECTION
40' S.B.
55' R.Y.
SANITARY CONNECTION
EXIST SAN. "WYE"
C. GILMAN
D. JOHNSTON
V 602 P 936
LOT 404
119.16'
LOT 403
VACANT LOT
M.L. SCHROEDER
APPROVED
MADISON TWP. ZONING
Permit: 13263
Zoning Inspector:
JAN 22 1992
BENCH MARK
SAN. M.H.
RIM EL. 100.00'
SITE PLAN FOR GIL JOHNSTON
LOT 404 & 405 MADISON LAKELANDS SUBD. No 2
MADISON TOWNSHIP, LAKE COUNTY, OHIO
SCALE 1" = 10 ft. 3 NOV. 1991
JIM PETER LAND SURVEY
4759 CROSBY - COOK RD.
STATE OF OHIO
JAMES M. PETER
6420
REGISTERED SURVEYOR
Job No. 911007