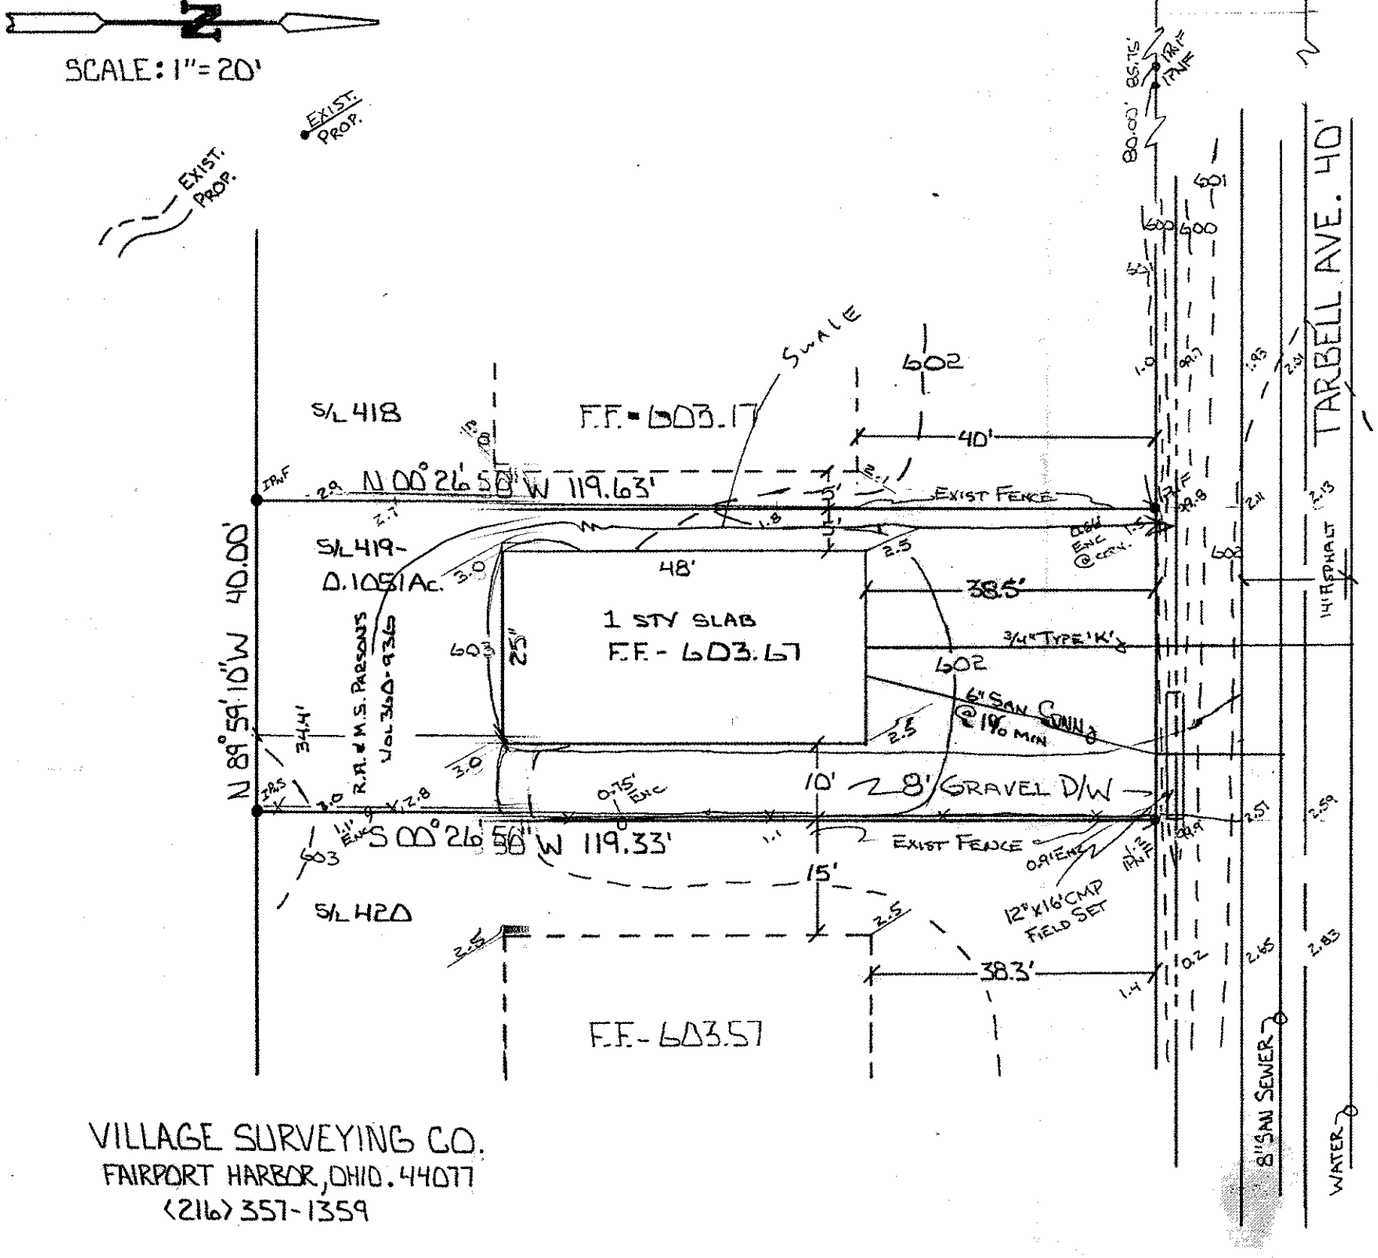

VILLAGE SURVEYING CO.
FAIRPORT HARBOR, OHIO. 44077
(216) 357-1359

Approved
and/or noted
GILLES, P.E.
Engineer

6/14 9294

SWALE AS SHOWN

SITE PLAN
FOR
BILL BARBIS

BEING S/L 419 OF LAKE BREEZE PARK CO.'S MADISON-LAKELAND SUB'D. NO. 2 IN MADISON TOWNSHIP, LAKE COUNTY, OHIO.

APPROVED
MADISON TWP. ZONING
Permit 1488
Zoning Inspector
AUG. 25 1994

E'LY R/W EASTON AV. IS EXT. OF S/L 419 W'LY LINE PER PLAT

ADDRESS	SETBACK
6618	21.6'
6630	36.7'
S/L 418	40.0'
6654	38.3'
6666	42.3'
AVE.	35.8'

STATE OF OHIO
THOMAS MARC COFFMAN
6857
REGISTERED SURVEYOR

MARCH 7, 1994
REV 3-20-94 SB+RY
7-20-94 LOCATE FENCES

I, the undersigned hereby certify that this topography, indicated by 1' contours, and elevations shown hereon represent an actual field survey made by me on JAN. 27, 1994 and that the elevations were taken at appropriate intervals and that as of that date they existed as indicated hereon.

J. M. Coffman P.S.
No 6857