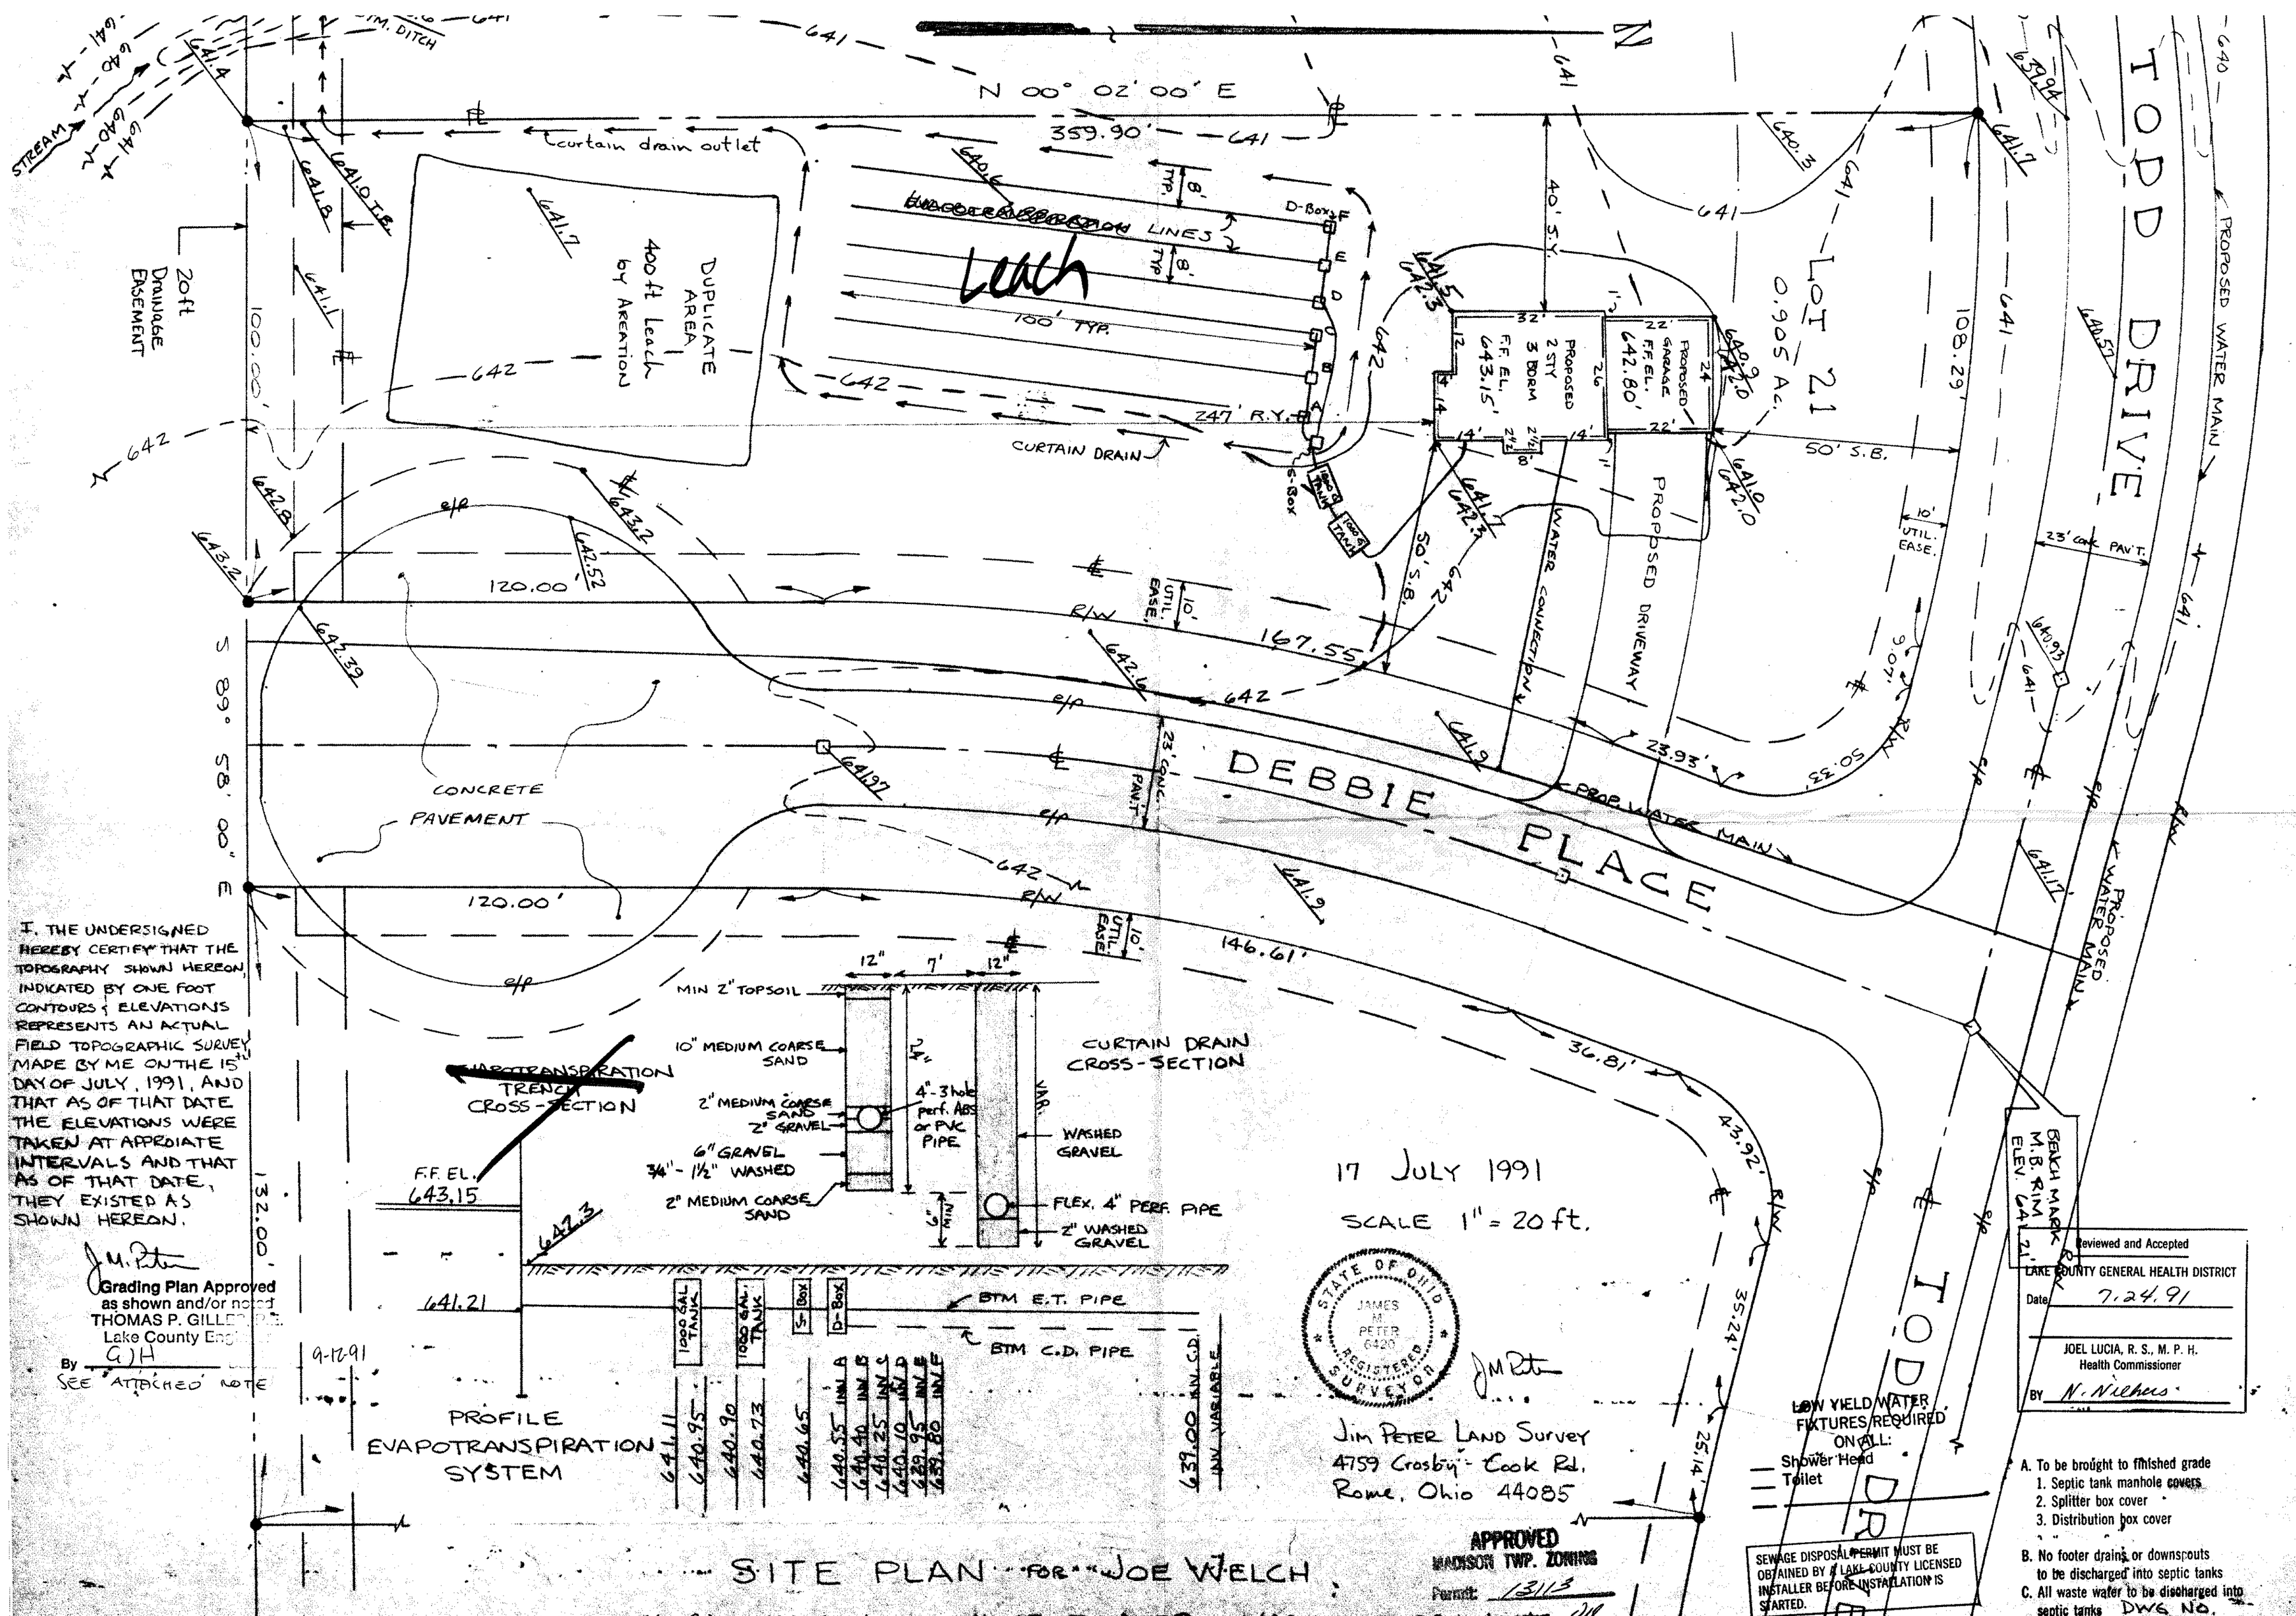

I, THE UNDERSIGNED HEREBY CERTIFY THAT THE TOPOGRAPHY SHOWN HEREON, INDICATED BY ONE FOOT CONTOURS & ELEVATIONS REPRESENTS AN ACTUAL FIELD TOPOGRAPHIC SURVEY MADE BY ME ON THE 15th DAY OF JULY, 1991, AND THAT AS OF THAT DATE THE ELEVATIONS WERE TAKEN AT APPROIATE INTERVALS AND THAT AS OF THAT DATE, THEY EXISTED AS SHOWN HEREON.

J.M. Peter

Grading Plan Approved as shown and/or noted
THOMAS P. GILLER, P.E.
Lake County Engineer
By GJH
SEE "ATTACHED" NOTE

9-12-91

Reviewed and Accepted
LAKE COUNTY GENERAL HEALTH DISTRICT
Date 7.24.91
JOEL LUCIA, R. S., M. P. H.
Health Commissioner
BY N. Nilhers

LOW YIELD WATER FIXTURES REQUIRED ON ALL:
Shower Head
Toilet

SEWAGE DISPOSAL PERMIT MUST BE OBTAINED BY A LAKE COUNTY LICENSED INSTALLER BEFORE INSTALLATION IS STARTED.

A. To be brought to finished grade
1. Septic tank manhole covers
2. Splitter box cover
3. Distribution box cover

B. No footer drains or downspouts to be discharged into septic tanks

C. All waste water to be discharged into septic tanks

DWG NO. 910706

APPROVED
MADISON TWP. ZONING
Permit: 13113
Zoning Inspector: JW

SITE PLAN FOR JOE WELCH
S/L 21 MADISON TOWNLINE ESTATES, MADISON TWP.