EVAPOTRANSPIRATION TRENCH CROSS-SECTION

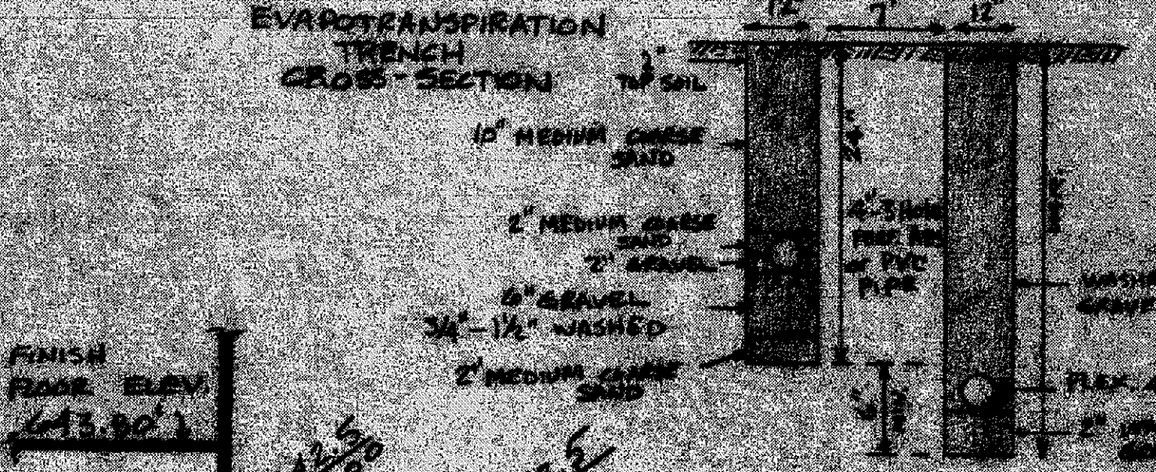

CURTAIN DRAIN CROSS-SECTION

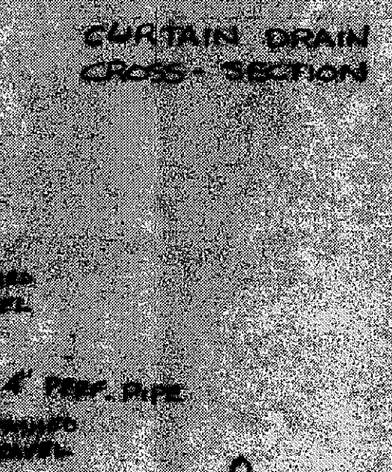

SEWAGE DISPOSAL PERMIT MUST BE OBTAINED BY A LAKE COUNTY LICENSED INSTALLER BEFORE INSTALLATION IS STARTED.

LOW YIELD WATER FIXTURES REQUIRED ON ALL:
- ___ Shower Head
- ___ Toilet
- ___ _____

A. To be brought to finished grade
1. Septic tank manhole covers
2. Splitter box cover
3. Distribution box cover

B. No footer drains or downspouts to be discharged into septic tanks
C. All waste water to be discharged into septic tanks

Reviewed and Accepted
LAKE COUNTY GENERAL HEALTH DISTRICT
Date 8.20.92
JOEL LUCIA, R.S., M.P.H.
Health Commissioner
BY N. Nienus

SITE PLAN
for
JOE WELCH
S/L 13 MADISON-TOWNLINE ESTATES
MADISON TOWNSHIP, LAKE COUNTY, OHIO
1 AUGUST 1992
SCALE 1" = 20 ft.

JIM PETER LAND SURVEY
4759 CROSBY-COOK RD.
ROME, OHIO 44085

REV. 18 AUG. 1992

APPROVED MADISON TWP. ZONING
Permit # 1536
Date Inspected
AUG 24 1992

BENCH MARK
MON. BOX RIM ELEVATION
641.39 ft.

EVAPO. TRANS. SYSTEM PROFILE

LOT 14 MADISON BUILDERS
VACANT LOT

20ft DRAINAGE EASEMENT

N 0°02' E
350.11'

N 89°58' W
100.00'

DUPLICATE AREA
400 ft by Aeration

LOT 13
0.826 Ac.
MADISON/BUILDERS LAND

265' R.Y.

EVAPOTRANSPIRATION LINES
3' to 5'
100' TYP
CURTAIN DRAIN
(2) 1000 gal. TANKS
DROP BOX

PROPOSED 1 STY. 3 BDRM. FRAME AND SLAB F.F. EL. 643.00'
PROPOSED GARAGE F.F. EL. 641.35
WATER SHUTOFF
30' S.B.
PROPOSED DRIVEWAY

367.01'
N 0°02' E

LOT 12 MADISON BUILDERS
VACANT LOT

10ft UTILITY EASEMENT

TODD DRIVE

CURB DRAIN

NOTE:
CURTAIN DRAIN TO FLOW THRU 4" PVC PIPE ALONG CURB DRAIN TO DRAINAGE DITCH BETWEEN S/L 10 & S/L 11 INVERT AT DRAINAGE DITCH 636.50 INVERT BETWEEN S/L 13 &

I UNDERSIGNED HEREBY CERTIFY THAT THE TOPOGRAPHY SHOWN HEREON, ED BY ONE FOOT CONTOURS & ELEVATIONS, REPRESENTS AN ACTUAL TOPOGRAPHIC SURVEY MADE BY ME ON THE 2ND DAY OF AUGUST 1992 AT AS OF THAT DATE THE ELEVATIONS EXISTED AS SHOWN HEREON.

Grading Plan Approved as shown or noted
THOMAS SCHUELER, P.E.
Lake County Engineer
By GH Date 8/26/92