SITE PLAN SUBLOT 1560
MADISON GOLF-LAKELANDS SUBDIVISION No. 2
PLAT BOOK G26
MADISON TOWNSHIP

Grading Plan Approved
as shown and/or noted
THOMAS P. GILLES, P.E.
Lake County Engineer
By GJH Date 7/6/2020'

7-3-1990

DEVELOPER: BILL BARBAS 5575 ORCHID DR. MENTOR, OHIO 44060
216-257-4305
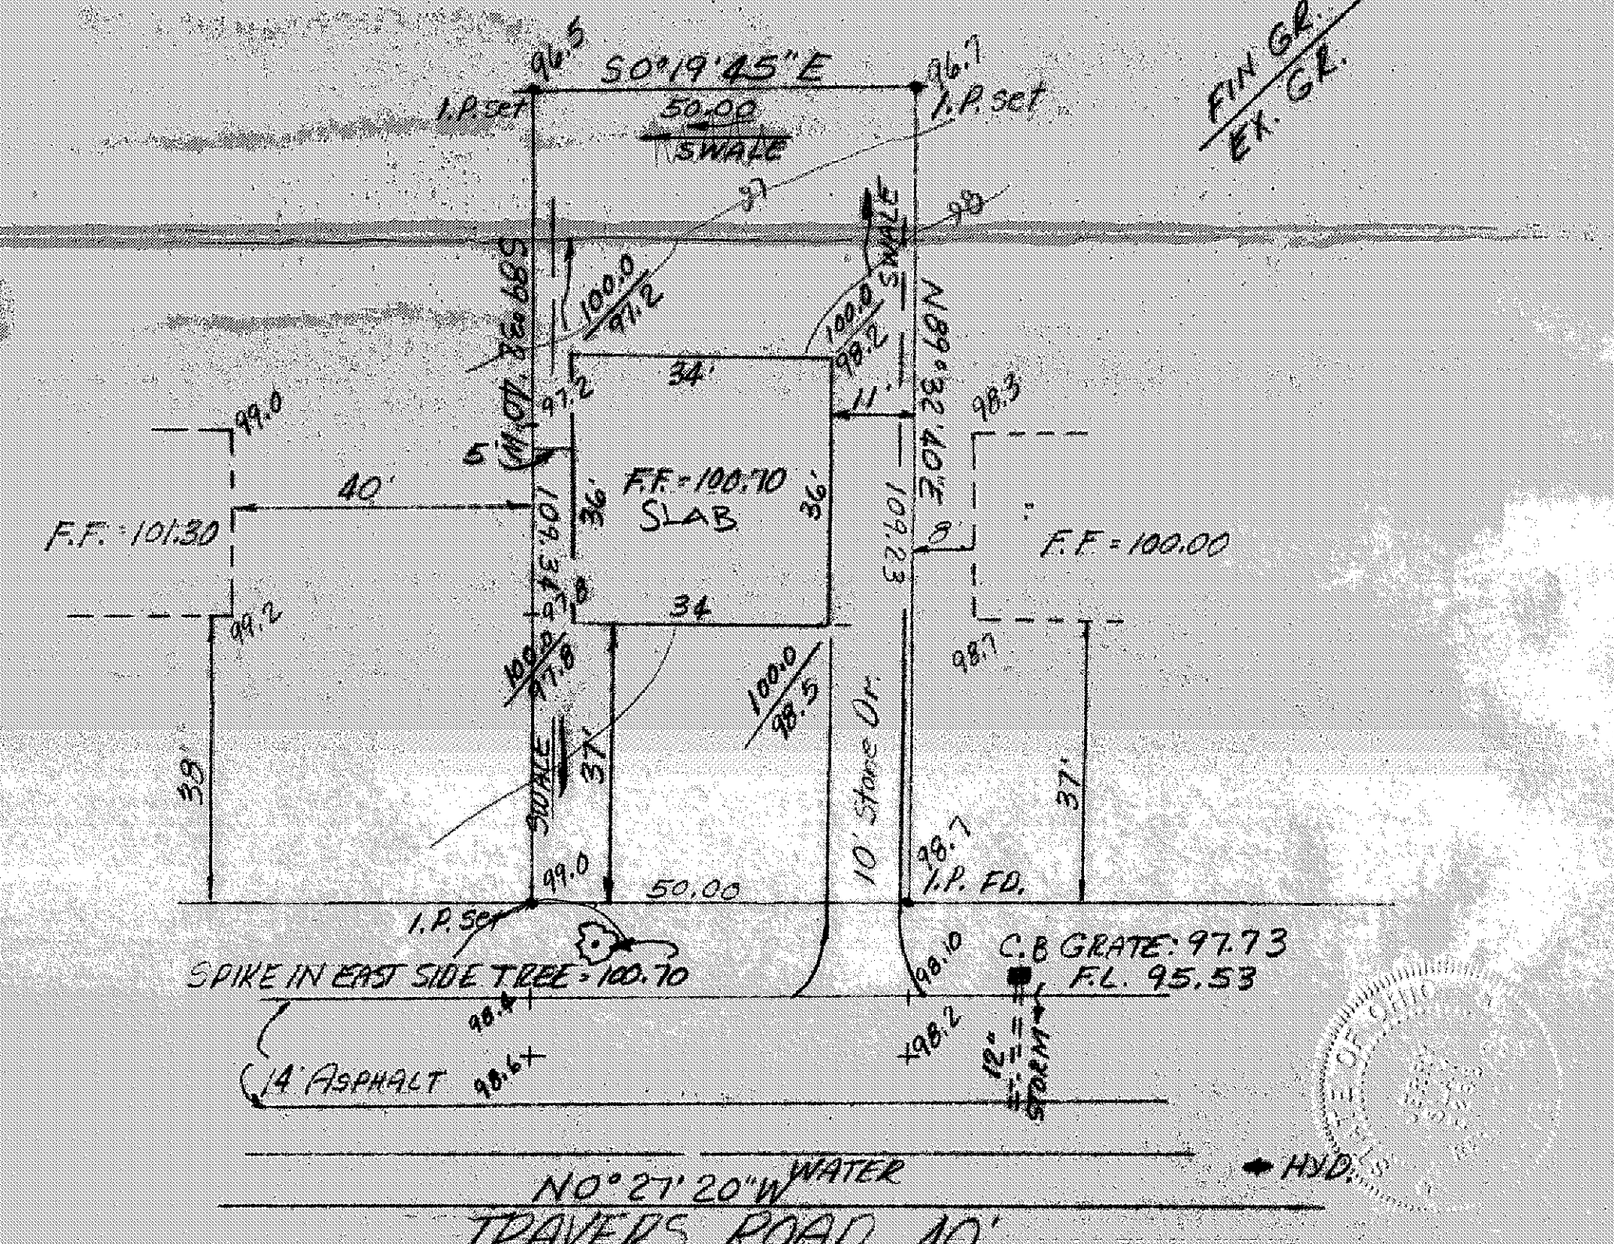
JERRY SLAY, OHIO SURVEYOR No. 5298
3102 JEFFERSON RD.
ASHTABULA, OHIO 44004
216-993-7205