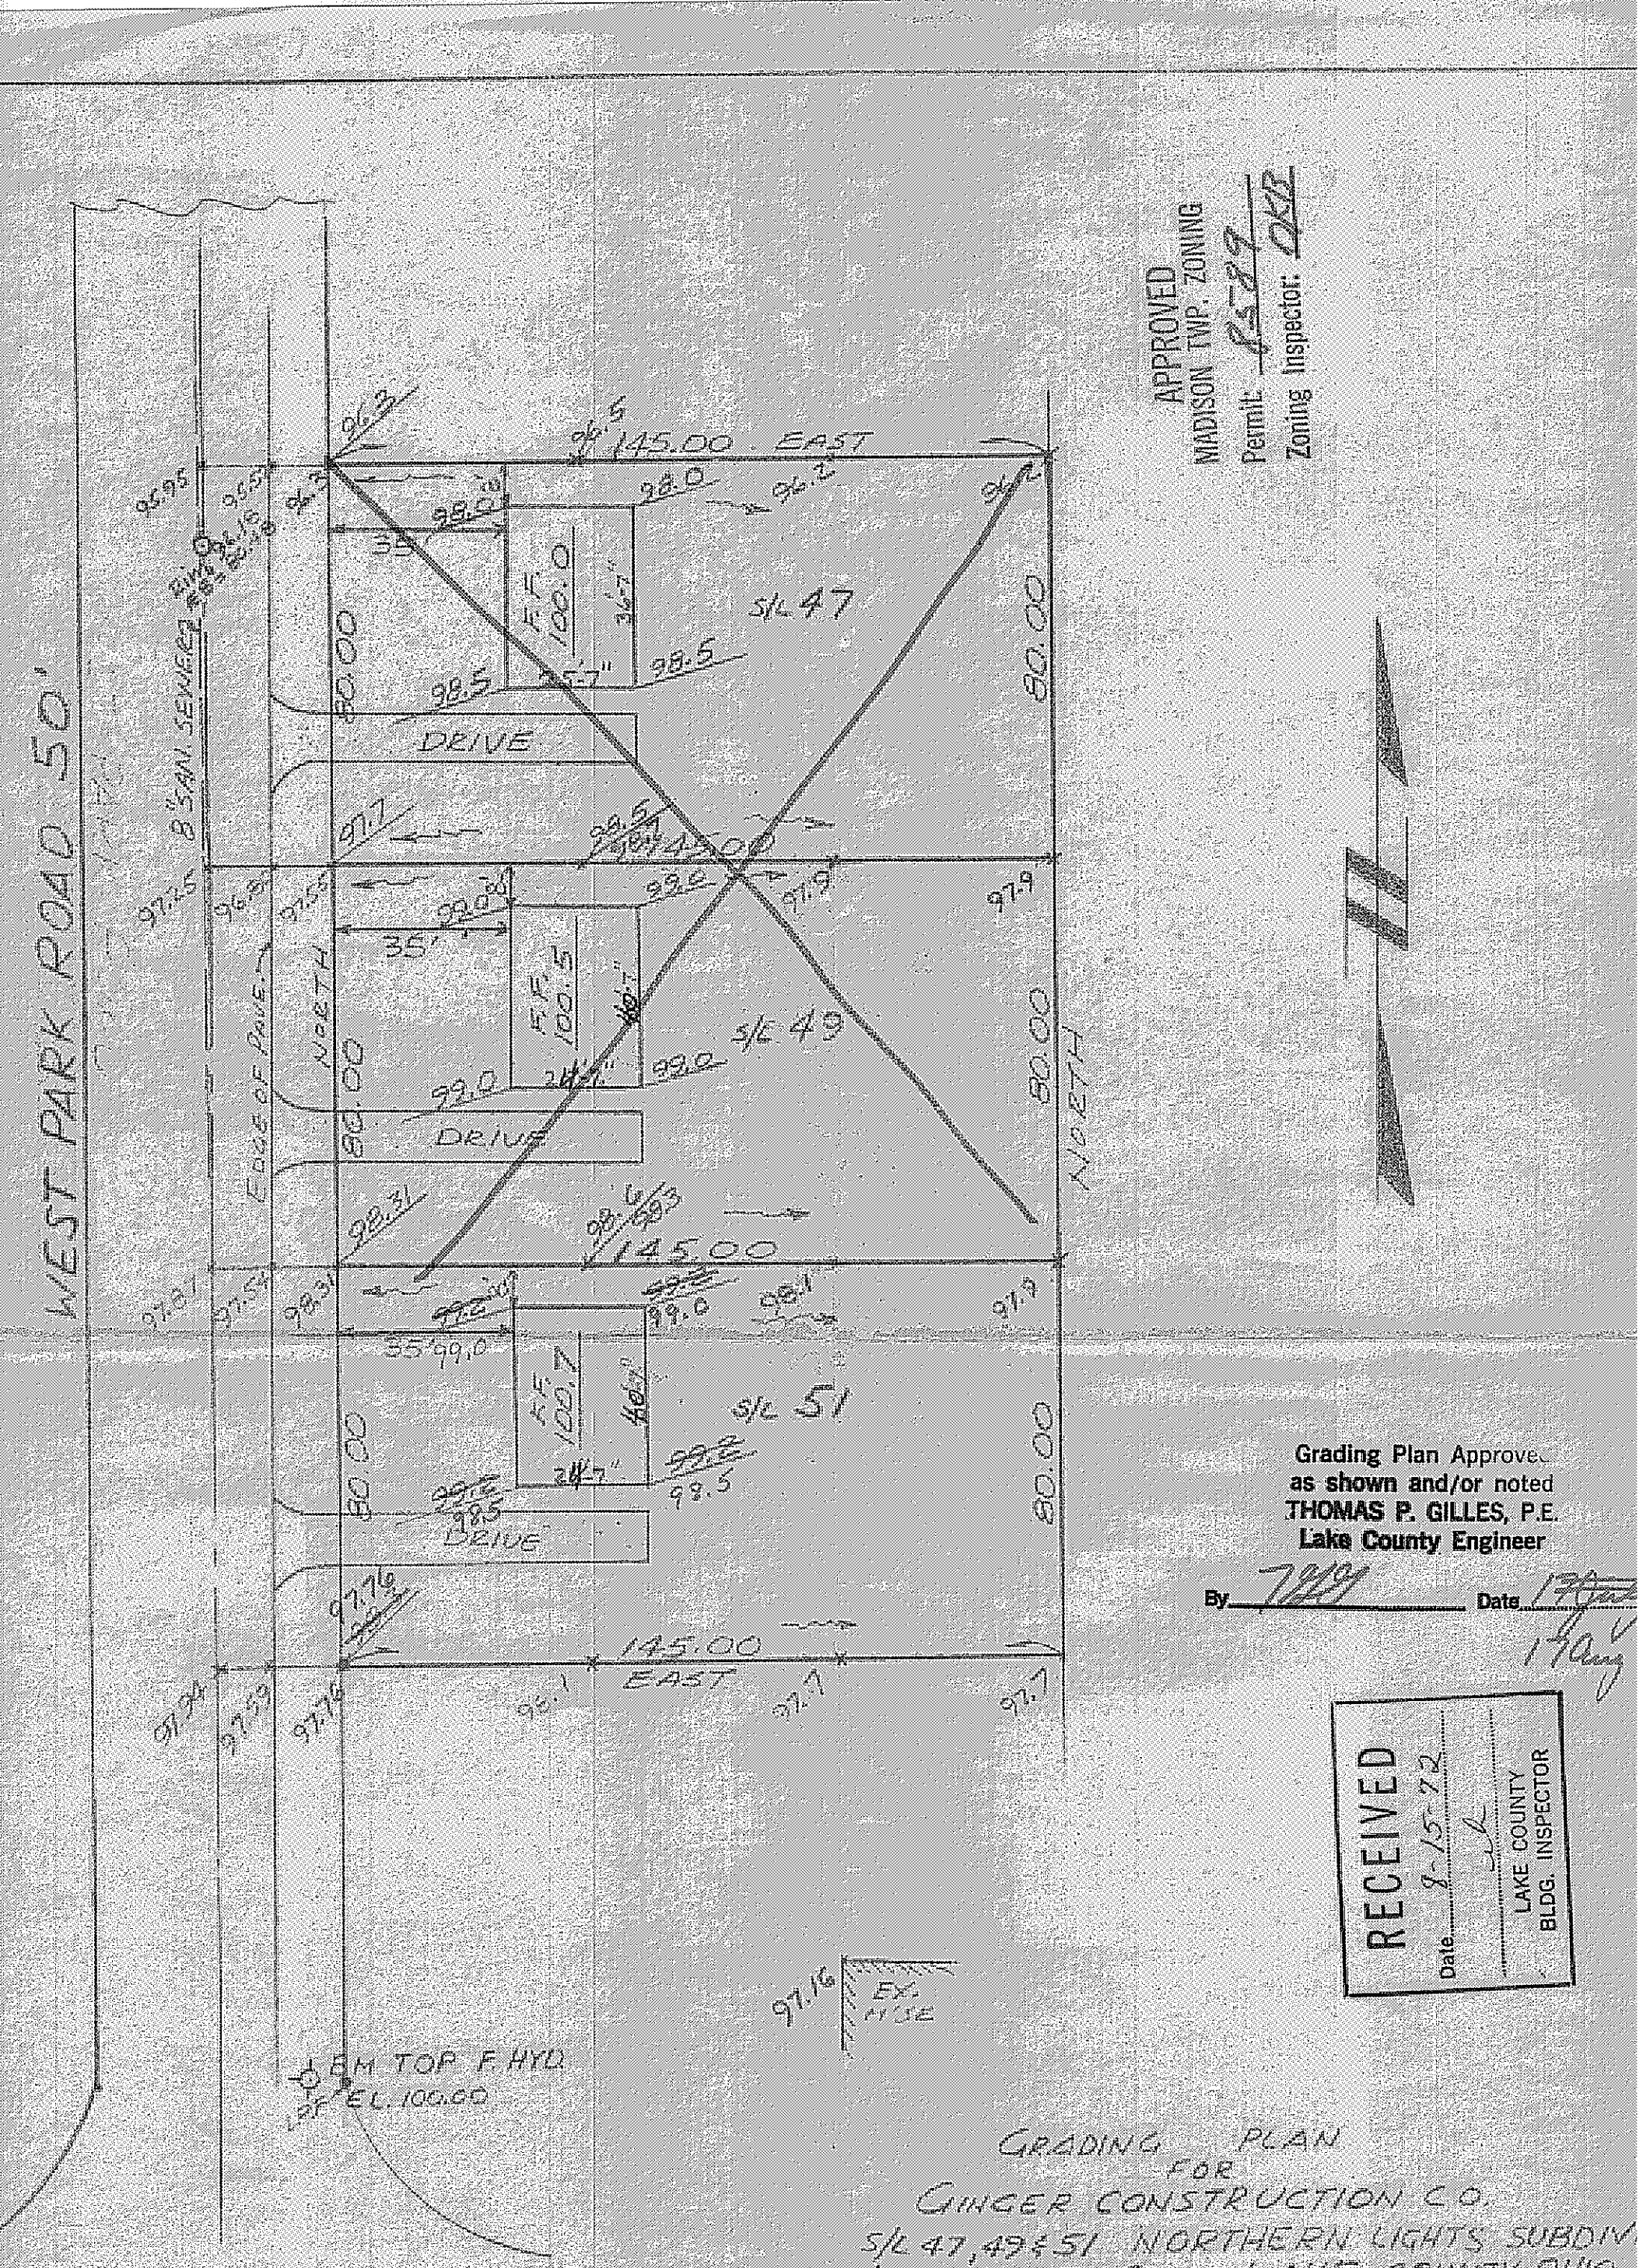
WEST PARK ROAD
HOMESTEAD ROAD
145.00 EAST
145.00
145.00 EAST
80.00
NORTH
S/C 47
S/C 49
S/C 51
DRIVE
F.F. 100.0
EX. HYDE
BM TOP F. HYD. EL. 100.00
APPROVED
MADISON TWP. ZONING
Permit:
Zoning Inspector:
Grading Plan Approved
as shown and/or noted
THOMAS P. GILLES, P.E.
Lake County Engineer
By
Date
RECEIVED
Date
LAKE COUNTY
BLDG. INSPECTOR
GRADING PLAN
FOR
GINGER CONSTRUCTION CO.
S/L 47, 49 & 51 NORTHERN LIGHTS SUBDIV
MADISON TWP. - LAKE COUNTY OHIO
SCALE: 1" = 30'
AS BUILT CERTIFICATION
I HEREBY CERTIFY THAT THE CIRCLED GRAD
ARE EXISTING FINISH
GRADES CHECKED IN THE FIELD ON
SURVEY IS CORRECT TO THE BEST OF MY KNOWLEDG
AND BELIEF.
FULLERTON-KERR
BY
REG. SURVEYOR, No.
NOTE: UNDERLINED ELS ARE FINISH GRADE
8-238-75