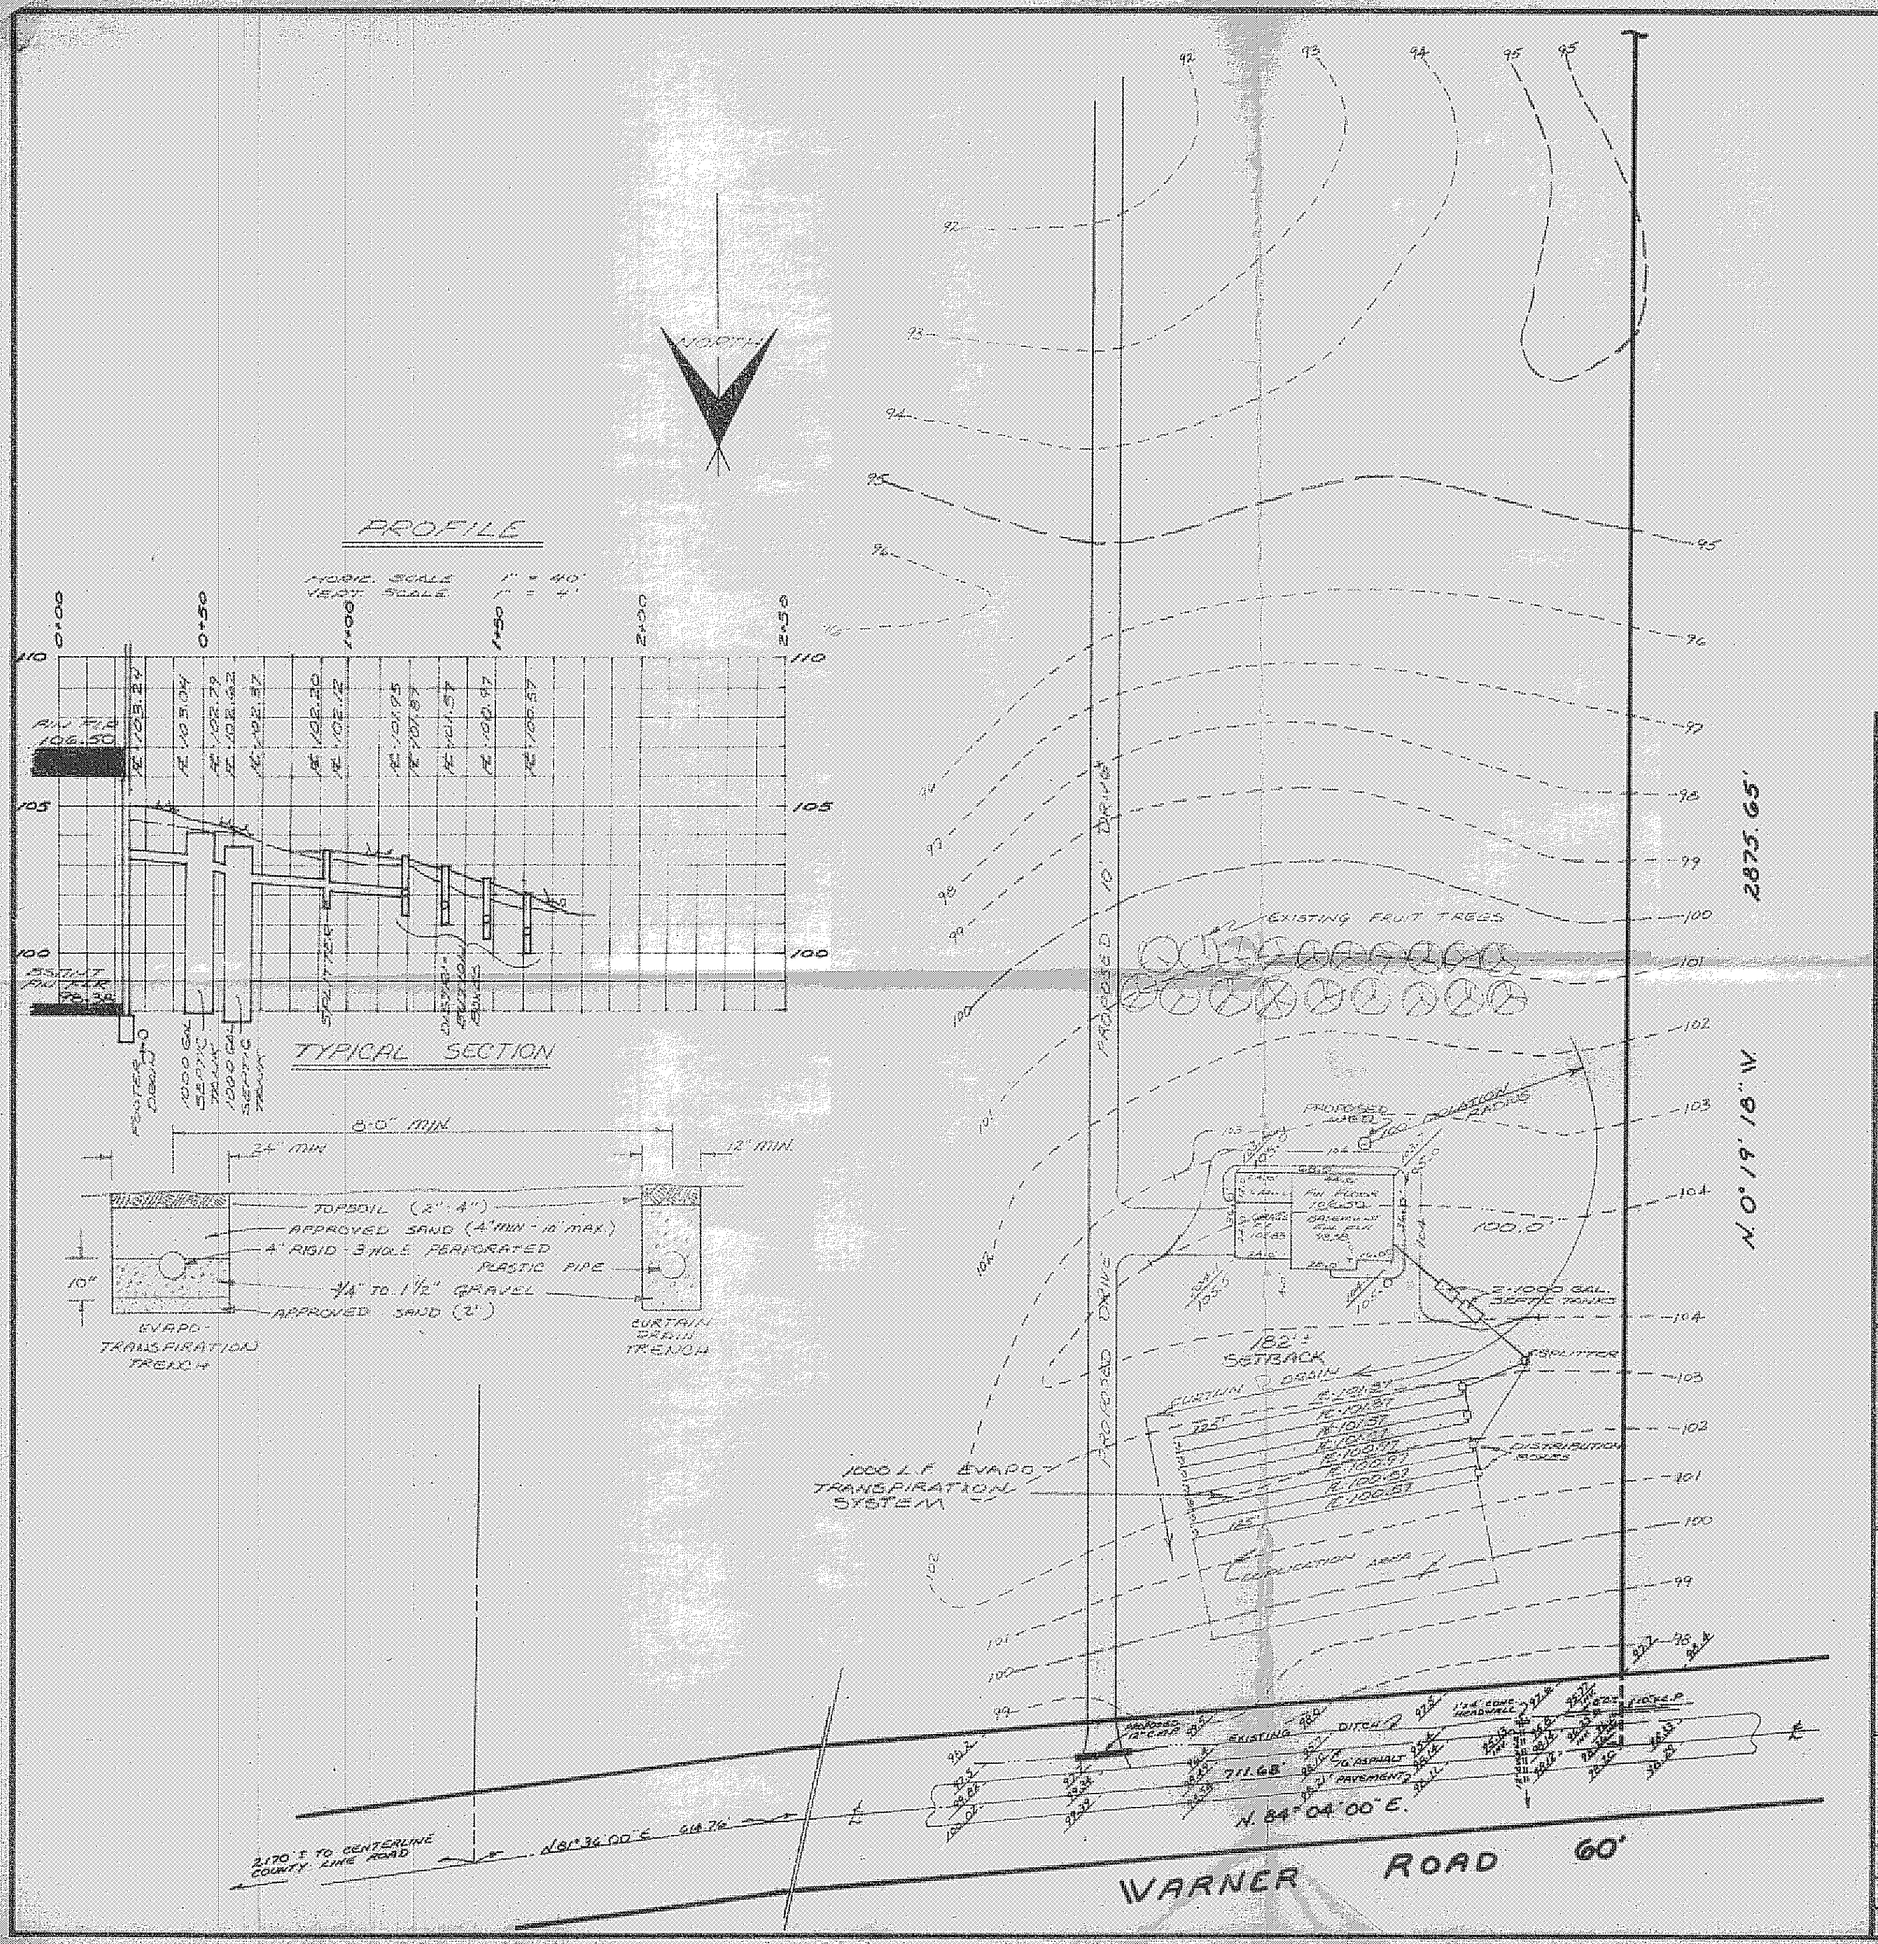

Rev. 2-4-81 → 1500 L.F. E.T.S.

APPROVED
MADISON TWP. ZONING
Permit: 10779
Zoning Inspector: R. Gardner

Grading Plan Approved as shown and/or noted
THOMAS P. GILLES, P.E.
Lake County Engineer
By [signature] Date 2-6-81

SITE PLAN

MADISON TWP. LAKE COUNTY, OHIO

for: PASQUALE GALIOTO
CLIENT OWNER

1797 GREEN RD. S. EUCLID
ADDRESS STREET CITY ZIP

SUBDIVISION	SUBLOT NO.	LOT	TRACT
		2	14

VOLUME	PAGE	STREET
840	372	WARNER ROAD

1A-65-1
PERMANENT PARCEL NO.

CERTIFICATION

THIS PLAT WAS PREPARED BY ME, AND IS CORRECT TO THE BEST OF MY KNOWLEDGE.

NAME REGISTRATION NO.

LEGEND

SANITARY MANHOLE
STORM MANHOLE
INLET OR CATCH BASIN
HYDRANT
EXISTING CONTOURS
PROPOSED CONTOURS
EXIST. ELEV. 100.00 / 100.00 PROP. ELEV.
WATER VALVE (GAS)
WATER METER (GAS)
AS BUILT ELEVATION
INDICATES DIRECTION OF SURFACE DRAINAGE

"AS BUILT" CERTIFICATION

I, HEREBY CERTIFY THAT THE CIRCLED GRADES ARE EXISTING FINISHED GRADES CHECKED IN THE FIELD ON _____, 19____ AND ARE CORRECT TO THE BEST OF MY KNOWLEDGE

NAME REGISTRATION NO

PLAN PREPARED BY
WM. R. GRAY, ASSOCIATES, INC.
ROY KERR

REVISIONS	DRAWN BY: R.K. & C.H.	SCALE: 1" = 50'	PHONE NO. 946-1616
28 Jan 81	CHECKED BY:	DATE: 10-28-80	DRAWING NO.