SITE PLAN for FRANK ZEHE

LOT 10 TRACT 4 MADISON TWP.
LAKE CO. OHIO
1"=40' July 1980

Milton A. Boomhower
Reg. Surveyor #4247

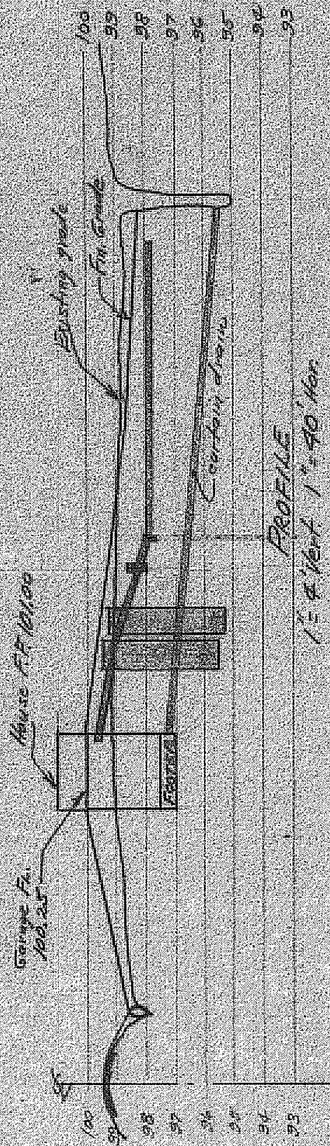

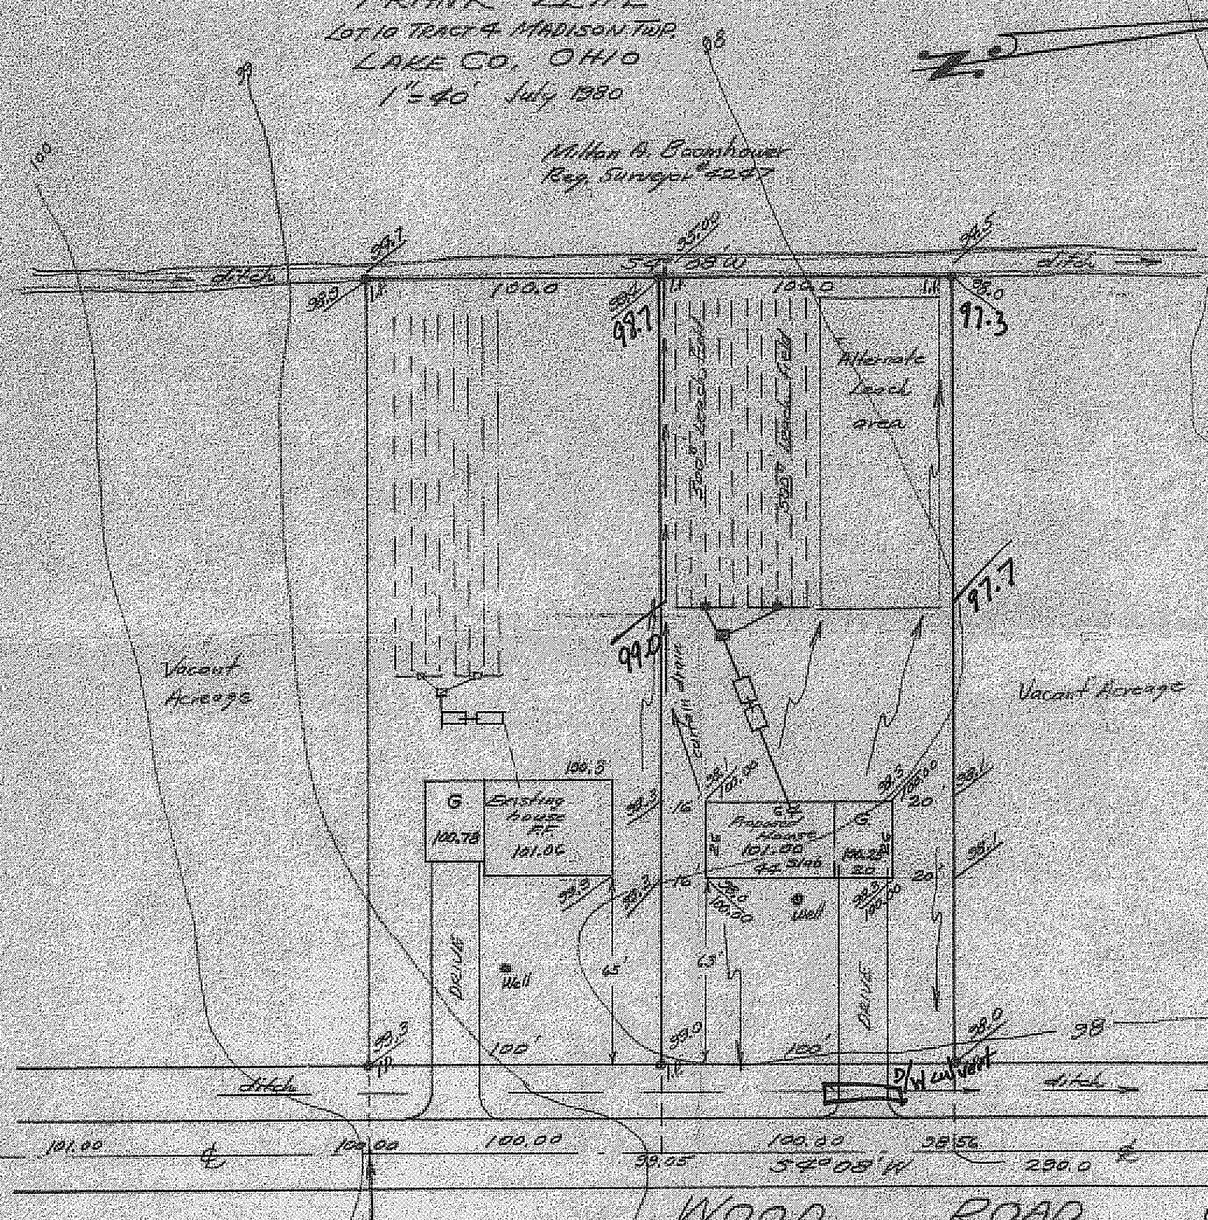

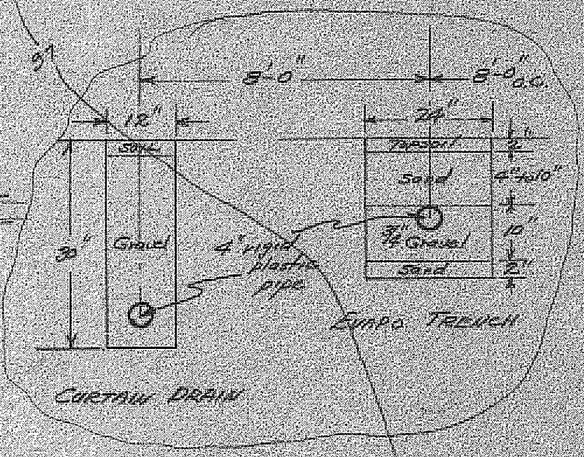

Grading Plan Approved as shown and/or noted
THOMAS P. GILLES, P.E.
Lake County Engineer
By _____ Date 7-22-80

APPROVED
MADISON TWP. ZONING
Permit No. 10682
Zoning Insp.