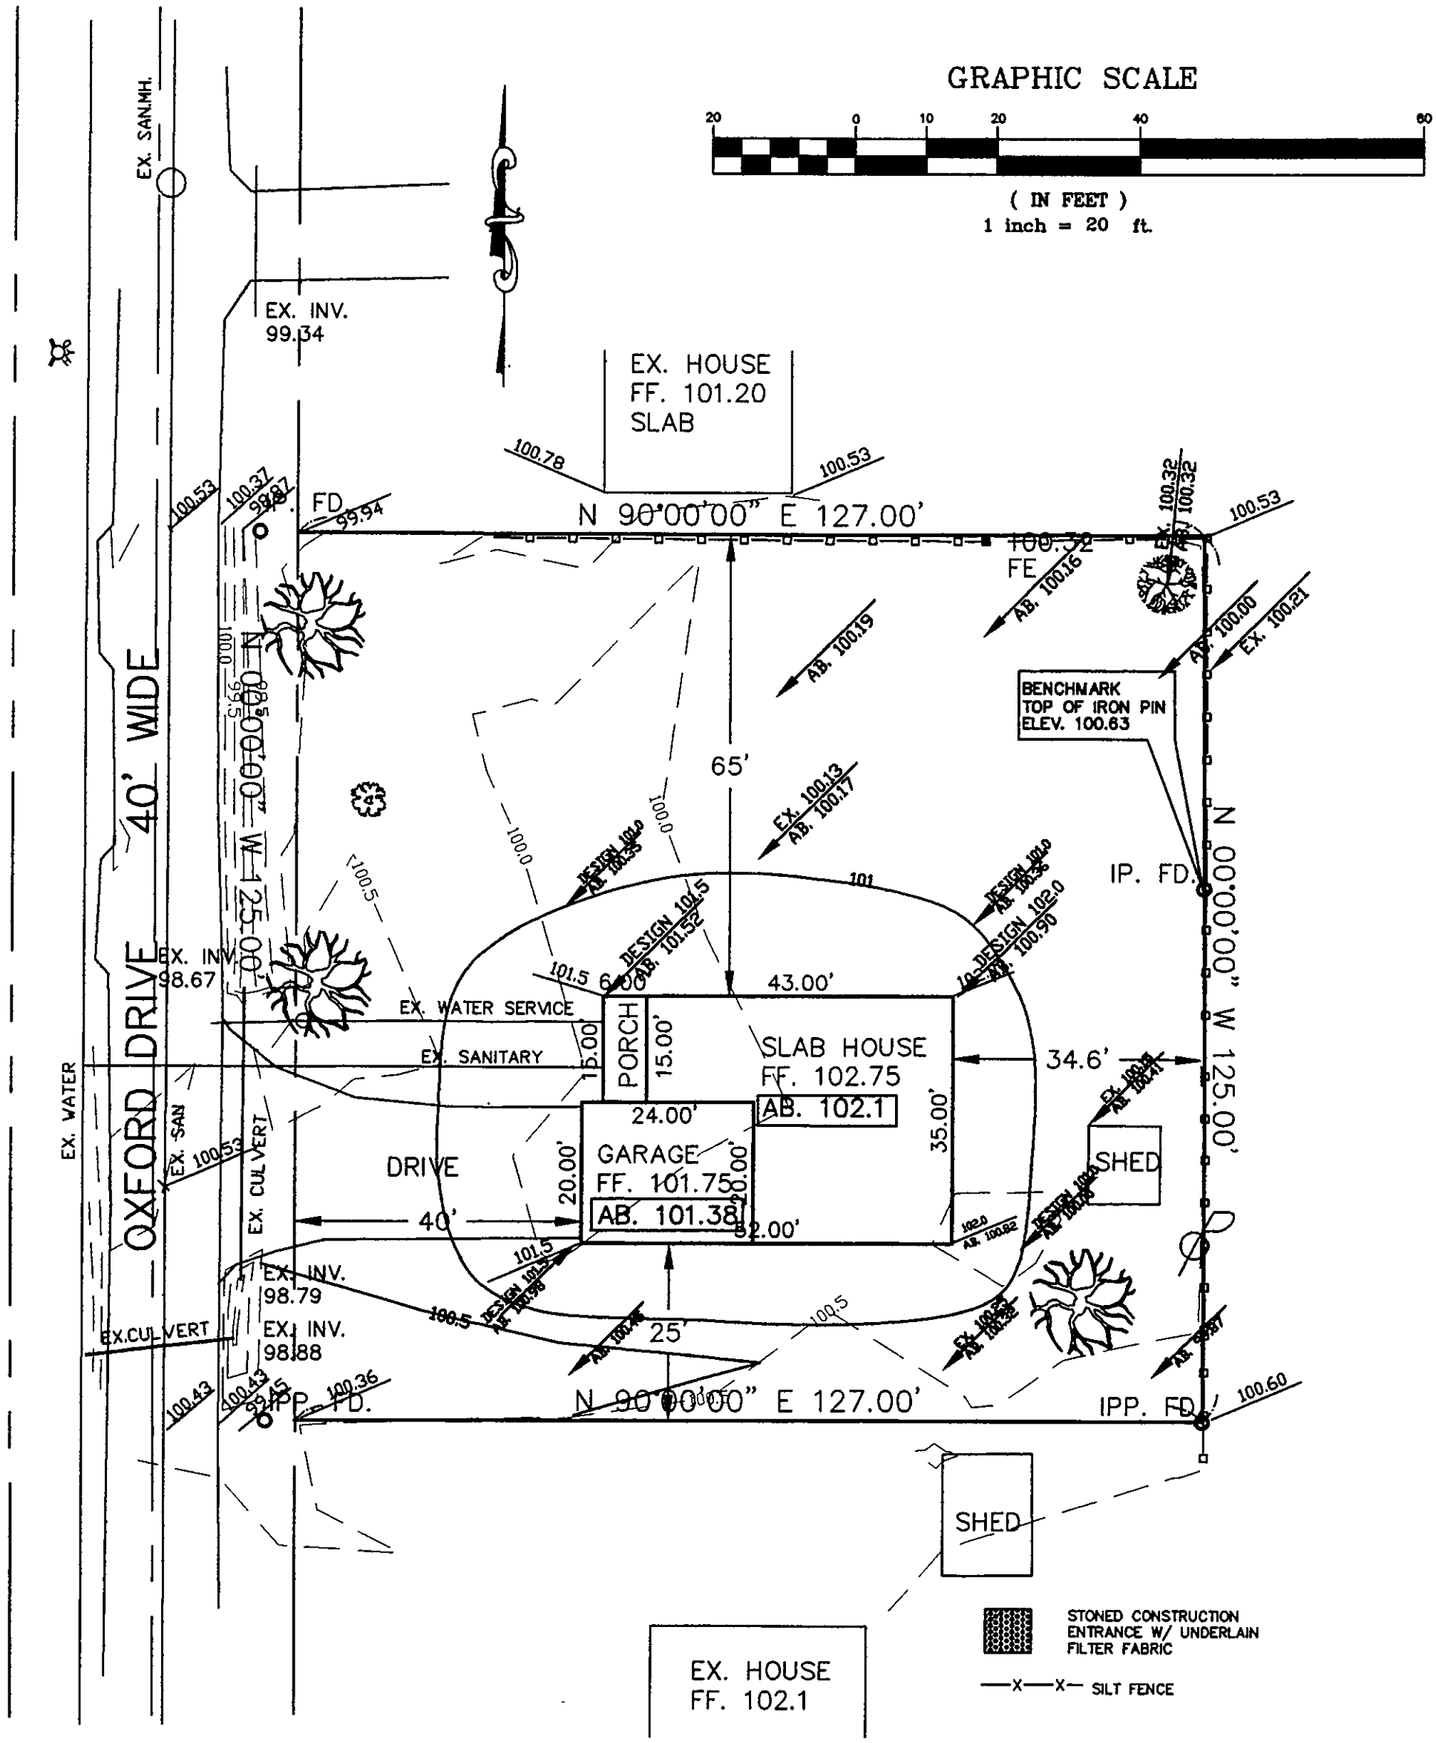

NOTES : 1. The Contractor Shall Verify the Following Before Starting: Finish Floor Elevations and House Size. Location and elevation of existing utility connections.

2. Contractor Shall Contact OUPS at least 2 Working Days prior to construction, 1-800-362-2764.

"I, the undersigned hereby certify that this topography, indicated by 1' contours and elevations shown hereon represents an actual field survey made by me in ~~APRIL, 2004~~ July/07 and that the elevations were taken at appropriate intervals and that as of that date they existed as indicated hereon."

David A. Rapp Reg. No. 24030

STATE OF OHIO DAVID A. RAPP E-62041 REGISTERED PROFESSIONAL ENGINEER

AS-BUILT 7/07

COR Consultants, Inc.
23 S. Forest Street Geneva, Ohio 44041
440-466-8085

DATE: APRIL, 2004
DRAWN BY: DAR
CHECKED BY: RMO
APPROVED BY: DAR
P.S. No. 7597

Carol Hamburg
Madison Beach Subdivision
Site Plan For
PP# 01B-102B-00-050-0
1279 Oxford Drive