LEGEND: EXISTING CONTOUR / PROPOSED CONTOUR

• IRON PIN OR PIPE FOUND OR SET

EXISTING ELEVATION

PROPOSED ELEVATION

S ——— PROPOSED FLOW

T.B.M. ELEVATION 590.11

TOP OF HYDRANT AT SUBLOT 45

FINISH FLOOR 591.13 BSMT. FLOOR SLAB

TOP FOOTER NA GARAGE FLOOR 590.46

SAN. CONN. 585+- STM. CONN. NA

AS BUILT FINISH FLOOR

AS BUILT GARAGE FLOOR

AS BUILT BASEMENT FLOOR

PLOT PLAN FOR SUBLOT 47 AND PART OF 46

PERMANENT PARCEL No. 018 102A 00 058 0 / 018 102A 00 059 0

STREET ADDRESS 7100 WHITESANDS BLVD.

IN THE MADISON BEACH SUBDIVISION VOL: F PG. 47

IN THE CITY OF MADISON TWP. LAKE COUNTY, OHIO

PREPARED FOR GEORGE SCHNEIDER AND RUSSELL KINKIAD

DATE 6-16-2004 SCALE 1" = 20'

AS BUILT DATE

AS BUILT ELEVATIONS (....)

SIDEWALKS AND APRONS (6" THICK AT DRIVEWAYS)

PROPOSED SWALES

SCHADE SURVEYING COMPANY 951-6454

4043 ERIE ST. WILLOUGHBY, OHIO DISK: KINKIAD.ZAK FB 116

JOB No. 04-1593

NOTE DOWNSPOUTS TO SPLASH BLOCKS, DIRECTED AWAY FROM HOUSE.

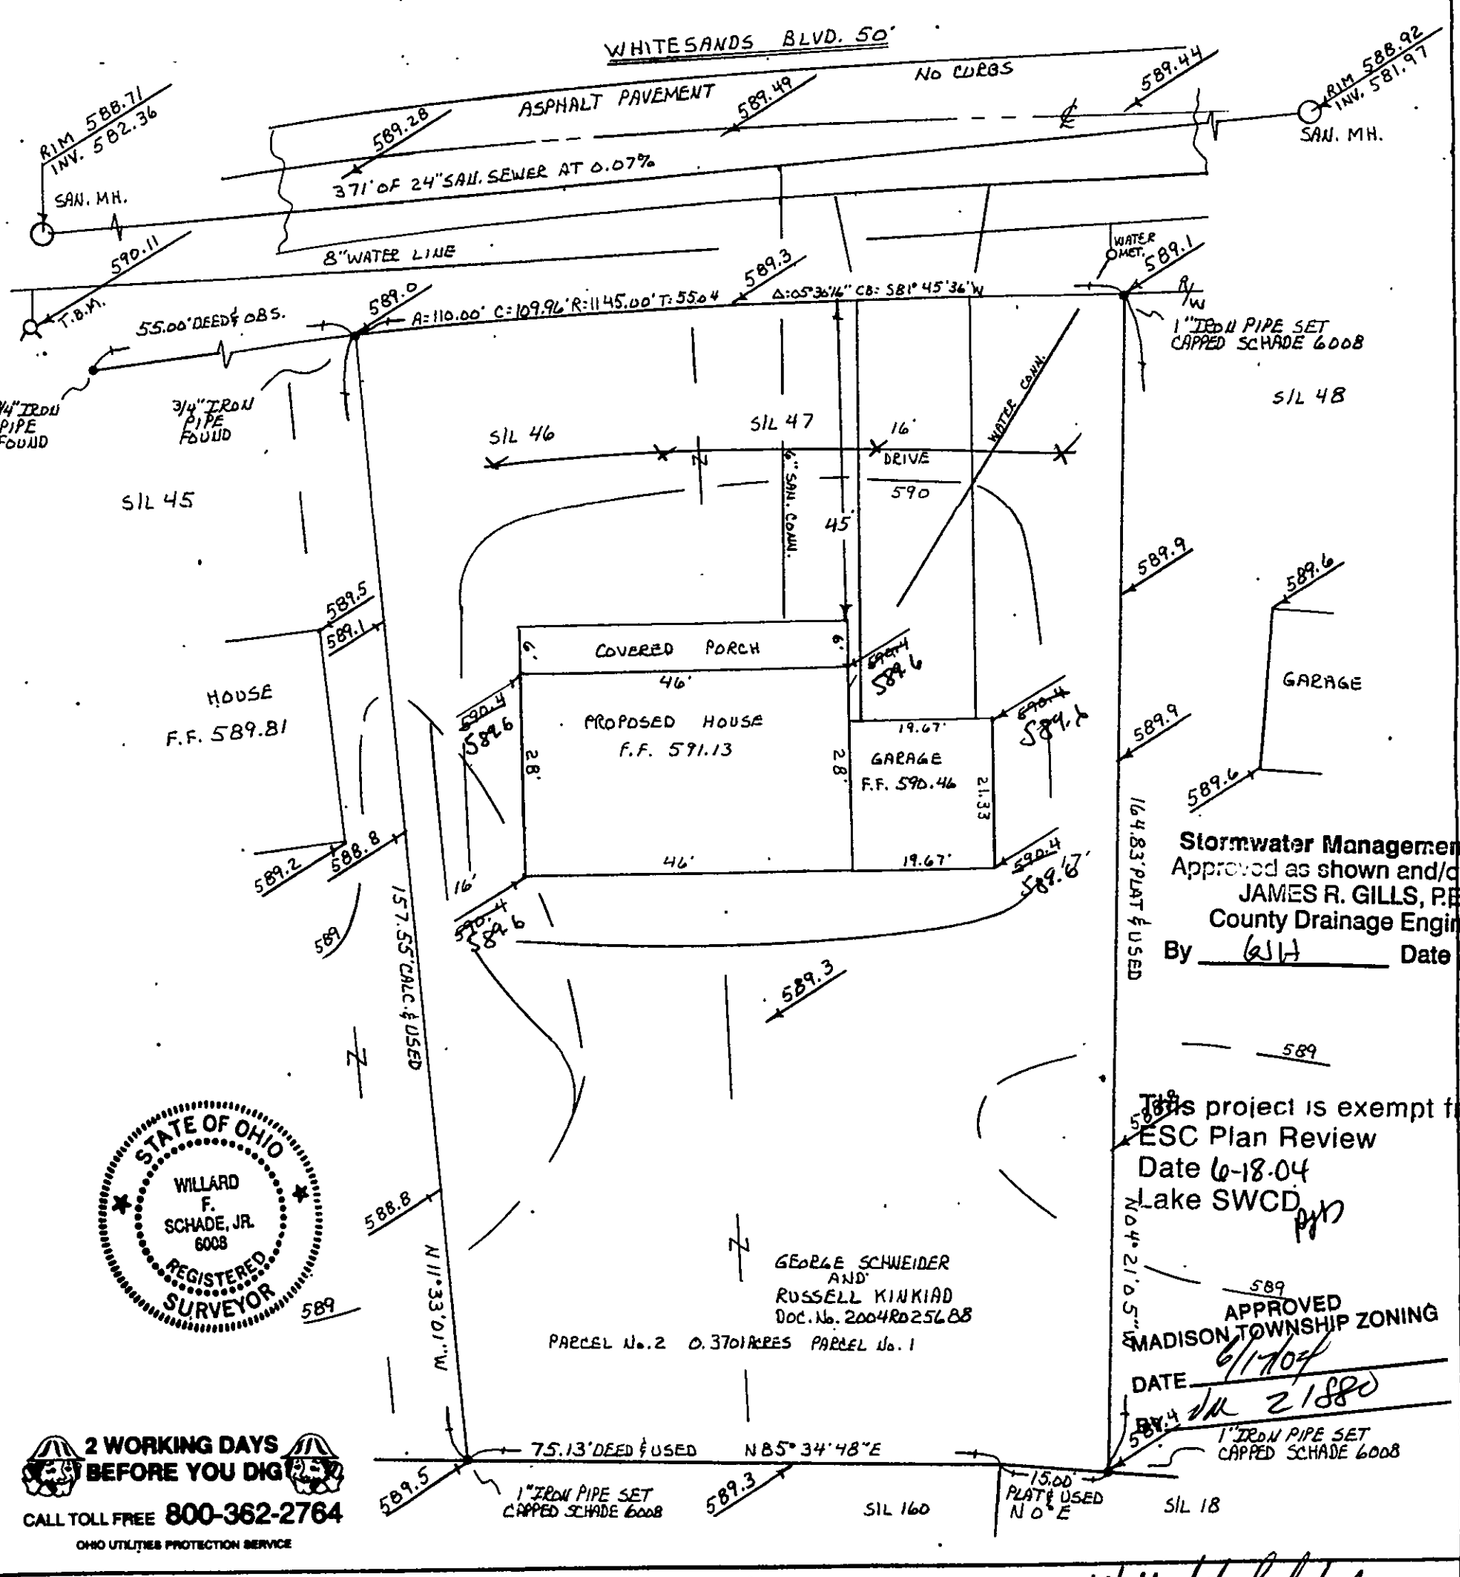

Stormwater Management Pl
Approved as shown and/or no
JAMES R. GILLS, P.E.
County Drainage Engineer
By GJH Date 6/2

This project is exempt from
ESC Plan Review
Date 6-18-04
Lake SWCD

APPROVED
MADISON TOWNSHIP ZONING
DATE 6/17/04
BY: 21880

STATE OF OHIO
WILLARD F. SCHADE, JR. 6008
REGISTERED SURVEYOR

2 WORKING DAYS BEFORE YOU DIG
CALL TOLL FREE 800-362-2764
OHIO UTILITIES PROTECTION SERVICE

CERTIFICATION: DIMENSIONS ARE EXPRESSED IN FEET AND DECIMAL PARTS THERE OF MONUMENTS ARE AT POINTS SHOWN AND ARE CERTIFIED CORRECT

WILLARD F. SCHADE REG. SURVEYOR 6008