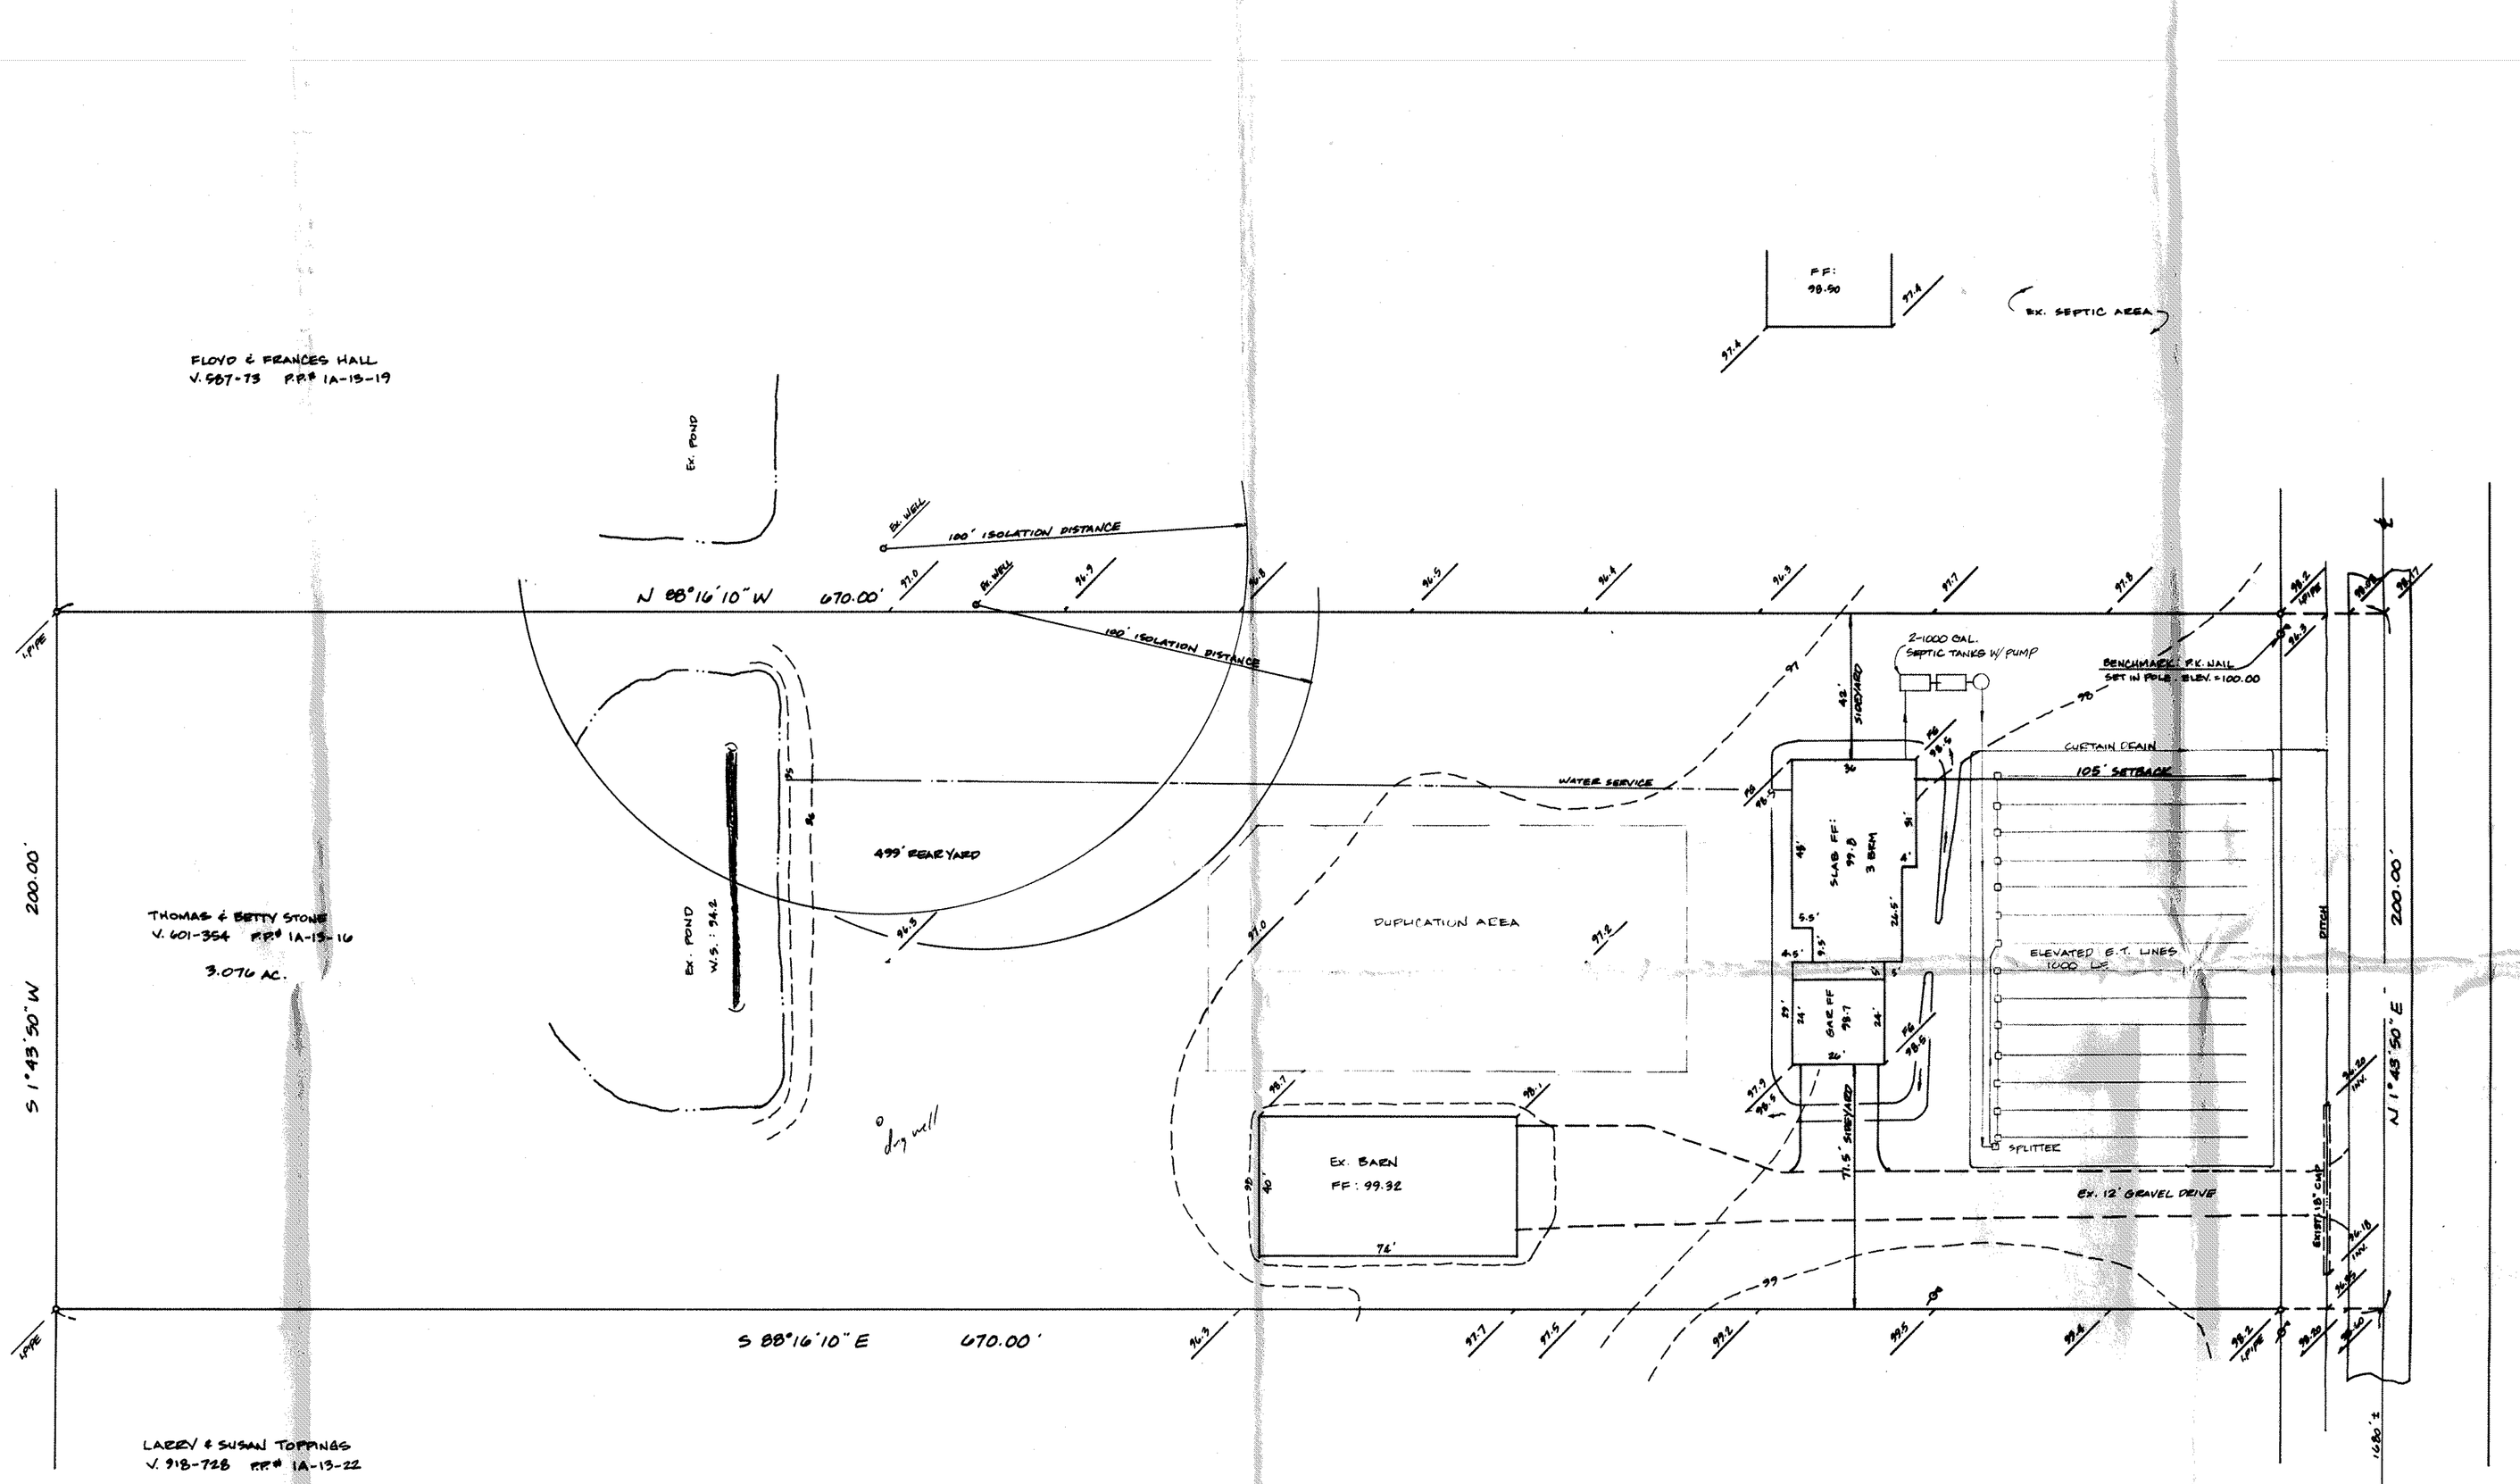

ELEVATED E.T. SYSTEM

1. SAND REQUIRED MUST BE MEDIUM COARSE TO COARSE IN TEXTURE. LAKE COUNTY HEALTH DEPT. MUST BE SHOWN PROOF OF SOURCE AND QUANTITY OF SAND.
2. EXISTING GROUND MUST BE "DISCED" PRIOR TO ADDING SAND FOR FILL. THE SIDE SLOPES MUST BE NO GREATER THAN 4:1.
3. A HOMEOWNER ACKNOWLEDGEMENT FORM MUST BE COMPLETED, SIGNED, AND RETURNED TO THE HEALTH DEPT.
4. LINES MUST BE EXCAVATED AT LEAST 6" INTO VIRGIN SOIL. TOTAL DEPTH OF LINES MAY NOT EXCEED 30".

Reviewed and Accepted
LAKE COUNTY GENERAL HEALTH DISTRICT
Date 6-22-95
Revised ET 6" From Sfc
JOEL LUCIA, R. S., M. P. H.
Health Commissioner
BY J. Lindsey

A. To be brought to finished grade
1. Septic tank manhole covers
2. Splitter box cover
3. Distribution box cover
" "
B. No footer drains or downspouts to be discharged into septic tanks
C. All waste water to be discharged into septic tanks

SEWAGE DISPOSAL PERMIT MUST BE OBTAINED BY A LAKE COUNTY LICENSED INSTALLER BEFORE INSTALLATION IS STARTED.

LOW YIELD WATER FIXTURES REQUIRED ON ALL:
__ Shower Head
__ Toilet
__

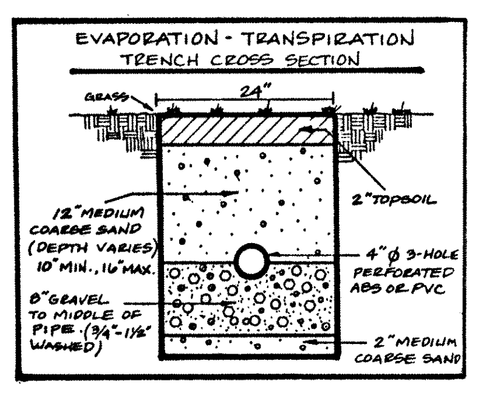

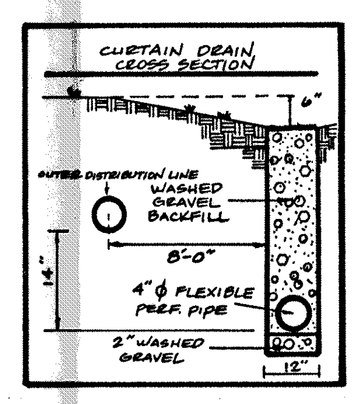

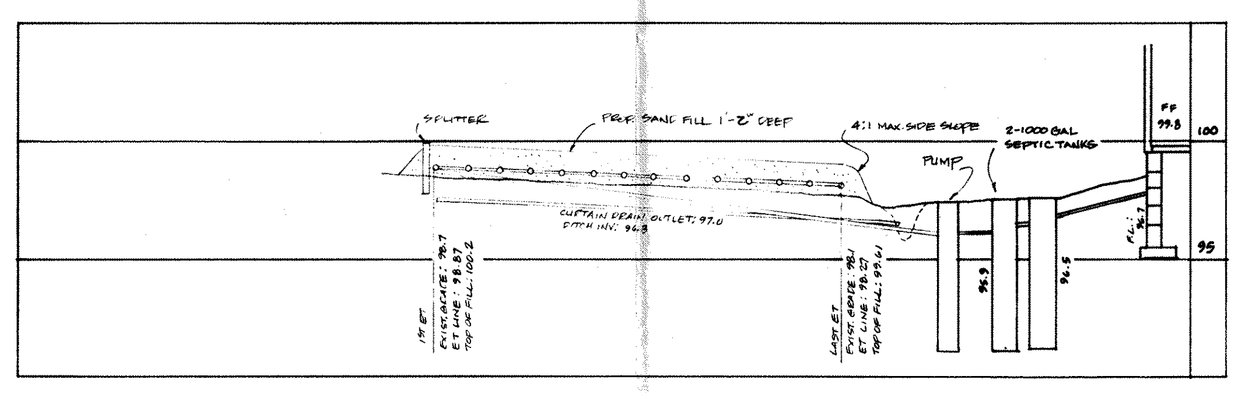

HYDRAULIC PROFILE
HORZ. 1" = 30', VERT. 1" = 5'

Septic Plan Approved as shown and/or noted
THOMAS P. GILLES, P.E.
Lake County Engineer
GJH Date 6-22-95

"I, the undersigned hereby certify that this topography indicated by 6", 1' or 2' contours, and elevations shown hereon represent an actual field survey made by me on the 2nd day of June, 1995 and that the elevations were taken at appropriate intervals and that as of that date they existed as indicated hereon."

Harry S. Jones #6343
Name Reg. No.

STATE OF OHIO
HARRY S. JONES, JR.
S-6343
REGISTERED PROFESSIONAL SURVEYOR

REV NO.	DESCRIPTION	DATE	BY	CH'K'D
1	REVISE SEPTIC PER L.C.H.D.	6/15/95	ϕ	HT

SITE PLAN
FOR
JIM SZOKO

BABCOCK, JONES AND ASSOCIATES, INC
CIVIL ENGINEERS - SURVEYORS - LAND PLANNERS
PAINESVILLE OHIO 44077

DATE	JUNE 1995
DESIGN BY	HT
DRAWN BY	ϕ
APPROVED BY	HT

KNOWN AS BEING PART OF LOT NO. 7, TRACT 4 MADISON TWP
VOL. 601-354 PP. # 1A-13-16
MADISON TOWNSHIP - LAKE COUNTY - OHIO

SCALE	1" = 30'
JOB NO	95-138
SHEET	1
OF	1