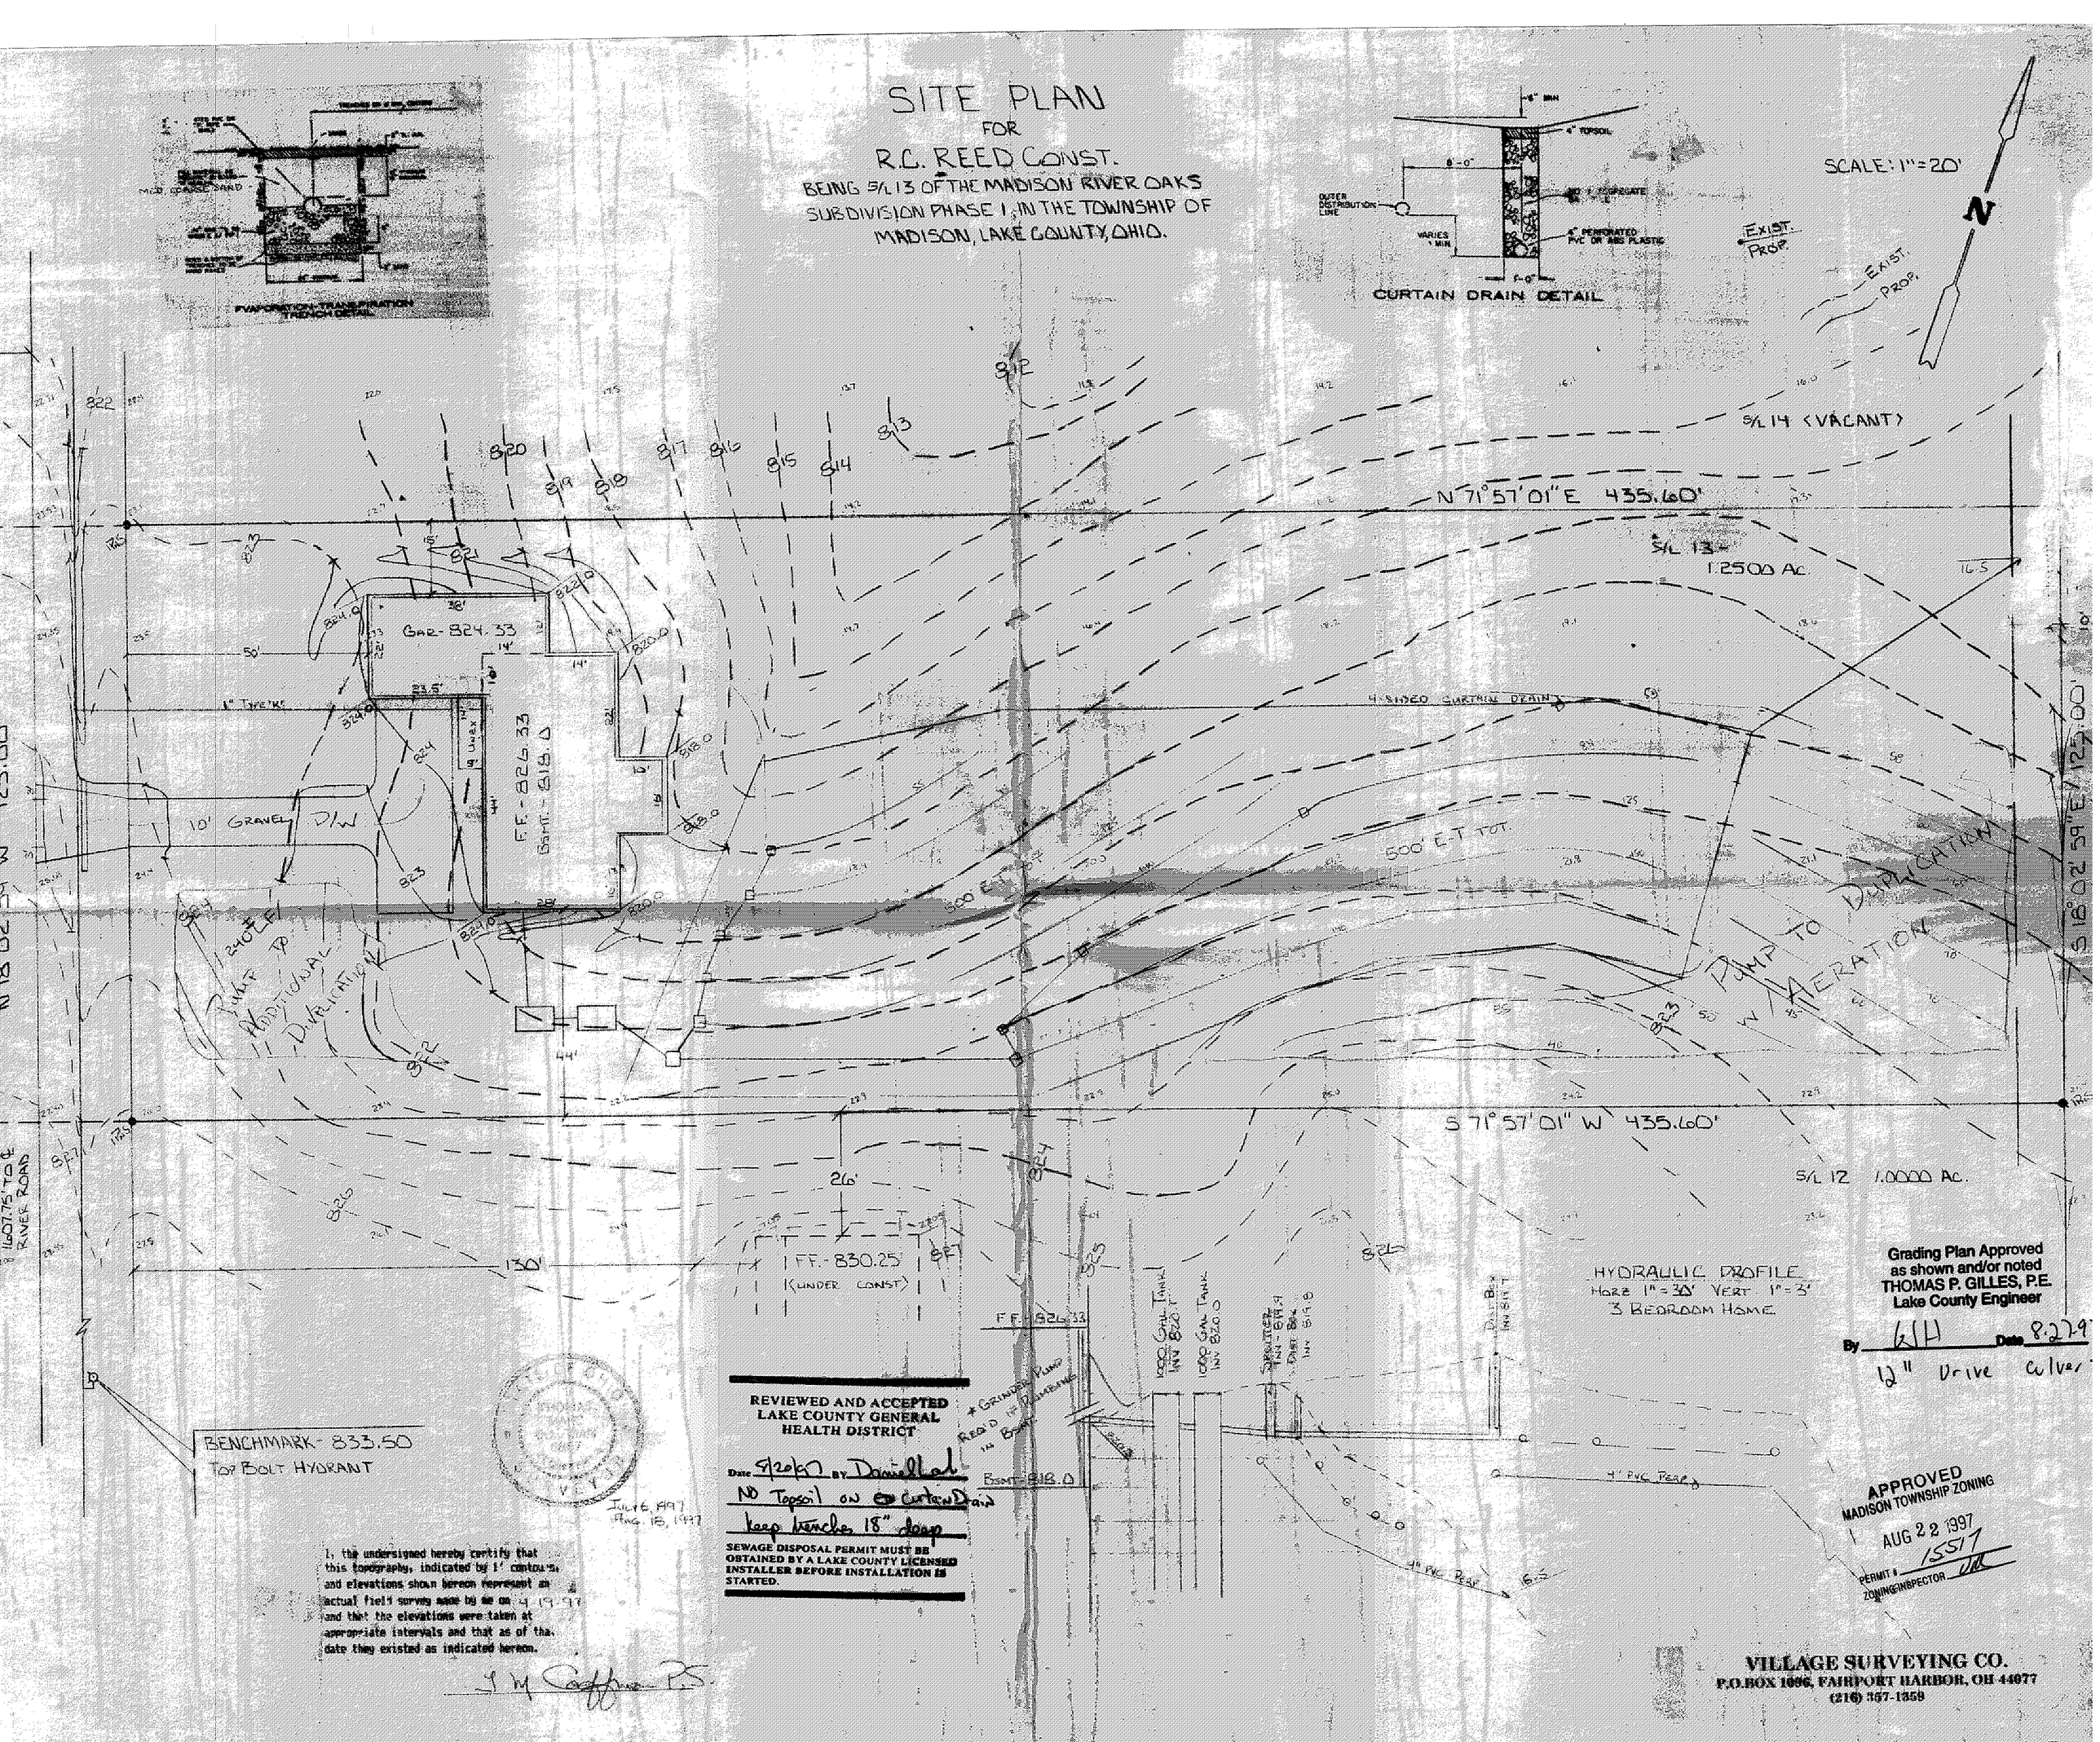
SITE PLAN
FOR
R.C. REED CONST.
BEING S/L 13 OF THE MADISON RIVER OAKS
SUBDIVISION PHASE 1, IN THE TOWNSHIP OF
MADISON, LAKE COUNTY, OHIO.
SCALE: 1"=20'
N
CURTAIN DRAIN DETAIL
EVAPORATION-TRANSPIRATION TRENCH DETAIL
EXIST. PROP.
S/L 14 (VACANT)
N 71°57'01" E 435.60'
S/L 13 - 1.2500 Ac.
GAR-824.33
F.F.-826.33
BSMT-818.0
10' GRAVEL D/W
4-SIDED CURTAIN DRAIN
500' E-T TOT.
PUMP TO DUPLICATION W/ AERATION
PUMP TO ADDITIONAL DUPLICATION
S 71°57'01" W 435.60'
S/L 12 1.0000 Ac.
F.F.-830.25 (UNDER CONST)
HYDRAULIC PROFILE
HORZ 1"=30' VERT 1"=3'
3 BEDROOM HOME
BENCHMARK-833.50
TOP BOLT HYDRANT
1607.75' TO ℄ RIVER ROAD
S 18°02'59" E 125.00'
REVIEWED AND ACCEPTED
LAKE COUNTY GENERAL
HEALTH DISTRICT
Date 8/20/97 BY Daniel Lal
NO Topsoil on Curtain Drain
keep trenches 18" deep
SEWAGE DISPOSAL PERMIT MUST BE OBTAINED BY A LAKE COUNTY LICENSED INSTALLER BEFORE INSTALLATION IS STARTED.
Grading Plan Approved
as shown and/or noted
THOMAS P. GILLES, P.E.
Lake County Engineer
By WH Date 8.27.97
12" Drive Culvert
APPROVED
MADISON TOWNSHIP ZONING
AUG 22 1997
PERMIT # 15517
ZONING INSPECTOR
I, the undersigned hereby certify that this topography, indicated by 1' contours, and elevations shown hereon represent an actual field survey made by me on 4-19-97 and that the elevations were taken at appropriate intervals and that as of that date they existed as indicated hereon.
J M Coffman P.S.
VILLAGE SURVEYING CO.
P.O.BOX 1096, FAIRPORT HARBOR, OH 44077
(216) 357-1359