SITE PLAN
FOR
R.C. REED CONST.
BEING SPLIT NO. 2 OF THE PAPARIZO SPLIT
IN LOT NO. 3, TRACT NO. 8, IN THE TOWNSHIP OF
MADISON, COUNTY OF LAKE, STATE OF OHIO

SCALE: 1" = 20'

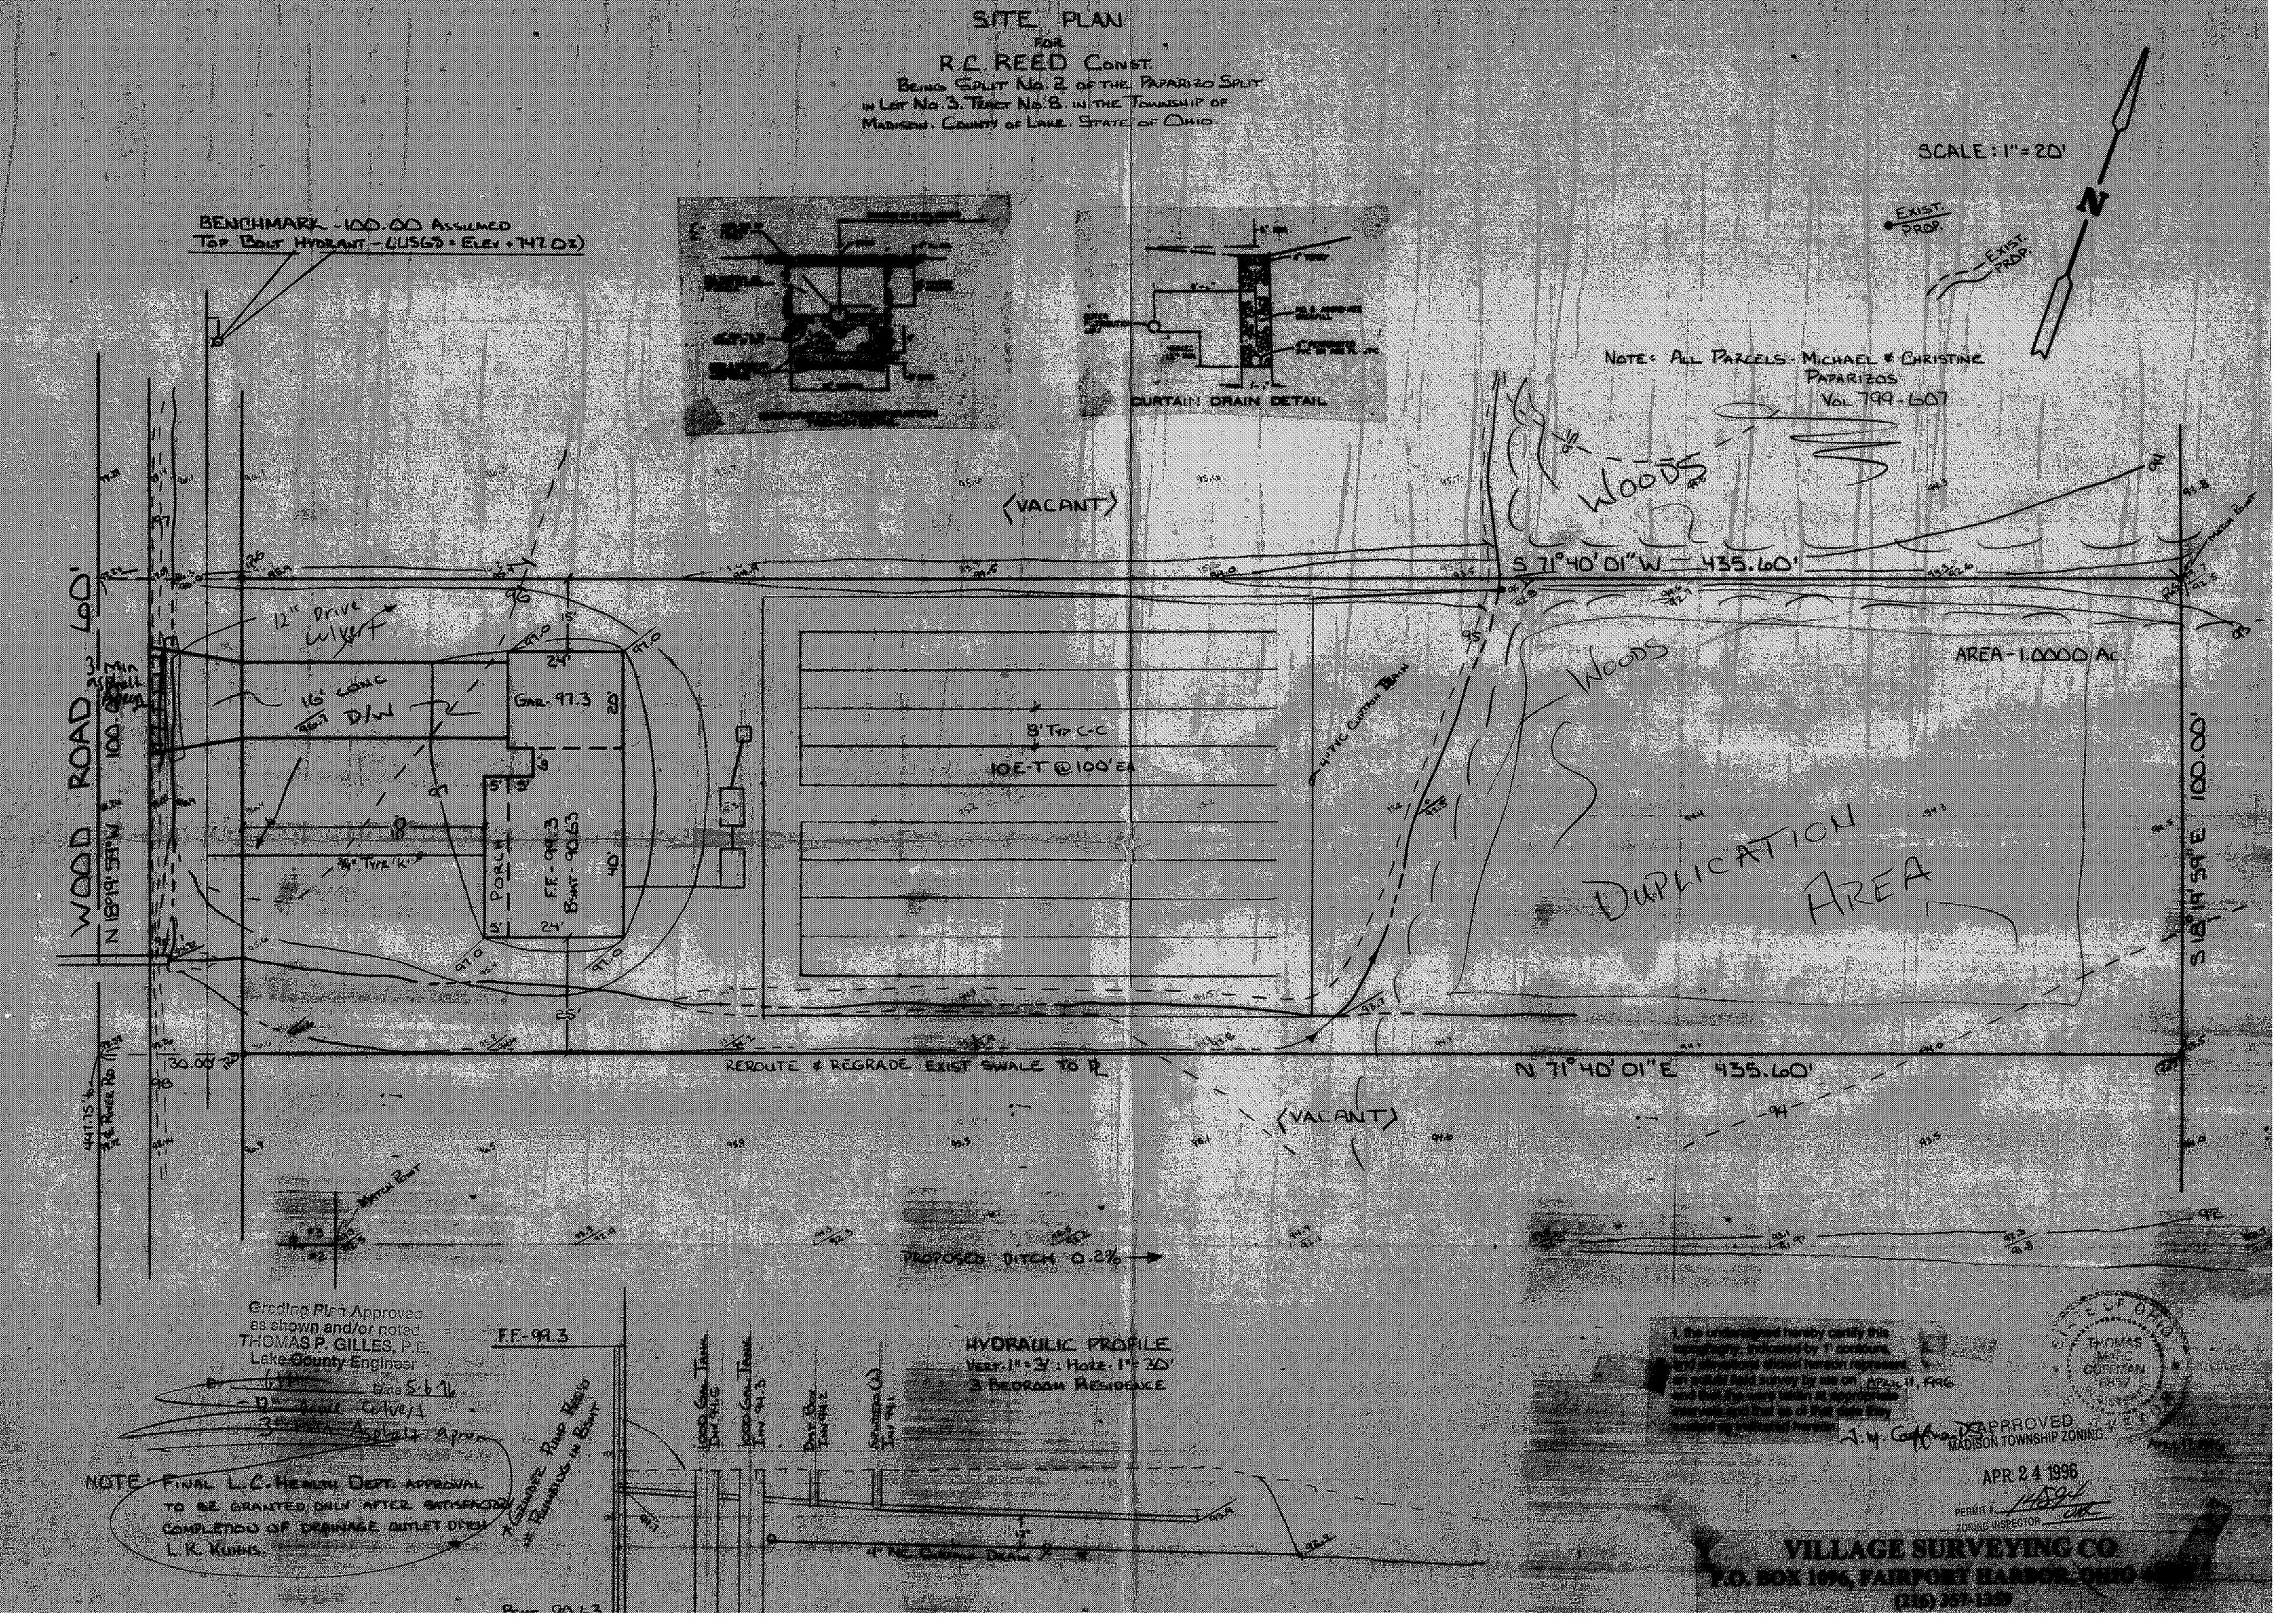

Grading Plan Approved as shown and/or noted
THOMAS P. GILLES, P.E.
Lake County Engineer
By _____ Date 5-6-96
12" Culvert
3" Asphalt Apron

NOTE: FINAL L.C. HEALTH DEPT. APPROVAL TO BE GRANTED ONLY AFTER SATISFACTORY COMPLETION OF DRAINAGE OUTLET DITCH
L.K. KUHNS

I, the undersigned hereby certify this topography, indicated by 1' contours, and the other details hereon represent an actual field survey by me on APRIL 11, 1996 and that the work was done in accordance therewith and that to the best of my knowledge and belief it is correct.

T.M. Gallagher

APPROVED
MADISON TOWNSHIP ZONING

APR 24 1996

PERMIT #
ZONING INSPECTOR

THOMAS MARC GALLAGHER 6857 STATE OF OHIO

VILLAGE SURVEYING CO.
P.O. BOX 1096, FAIRPORT HARBOR, OHIO
(216) 357-1359