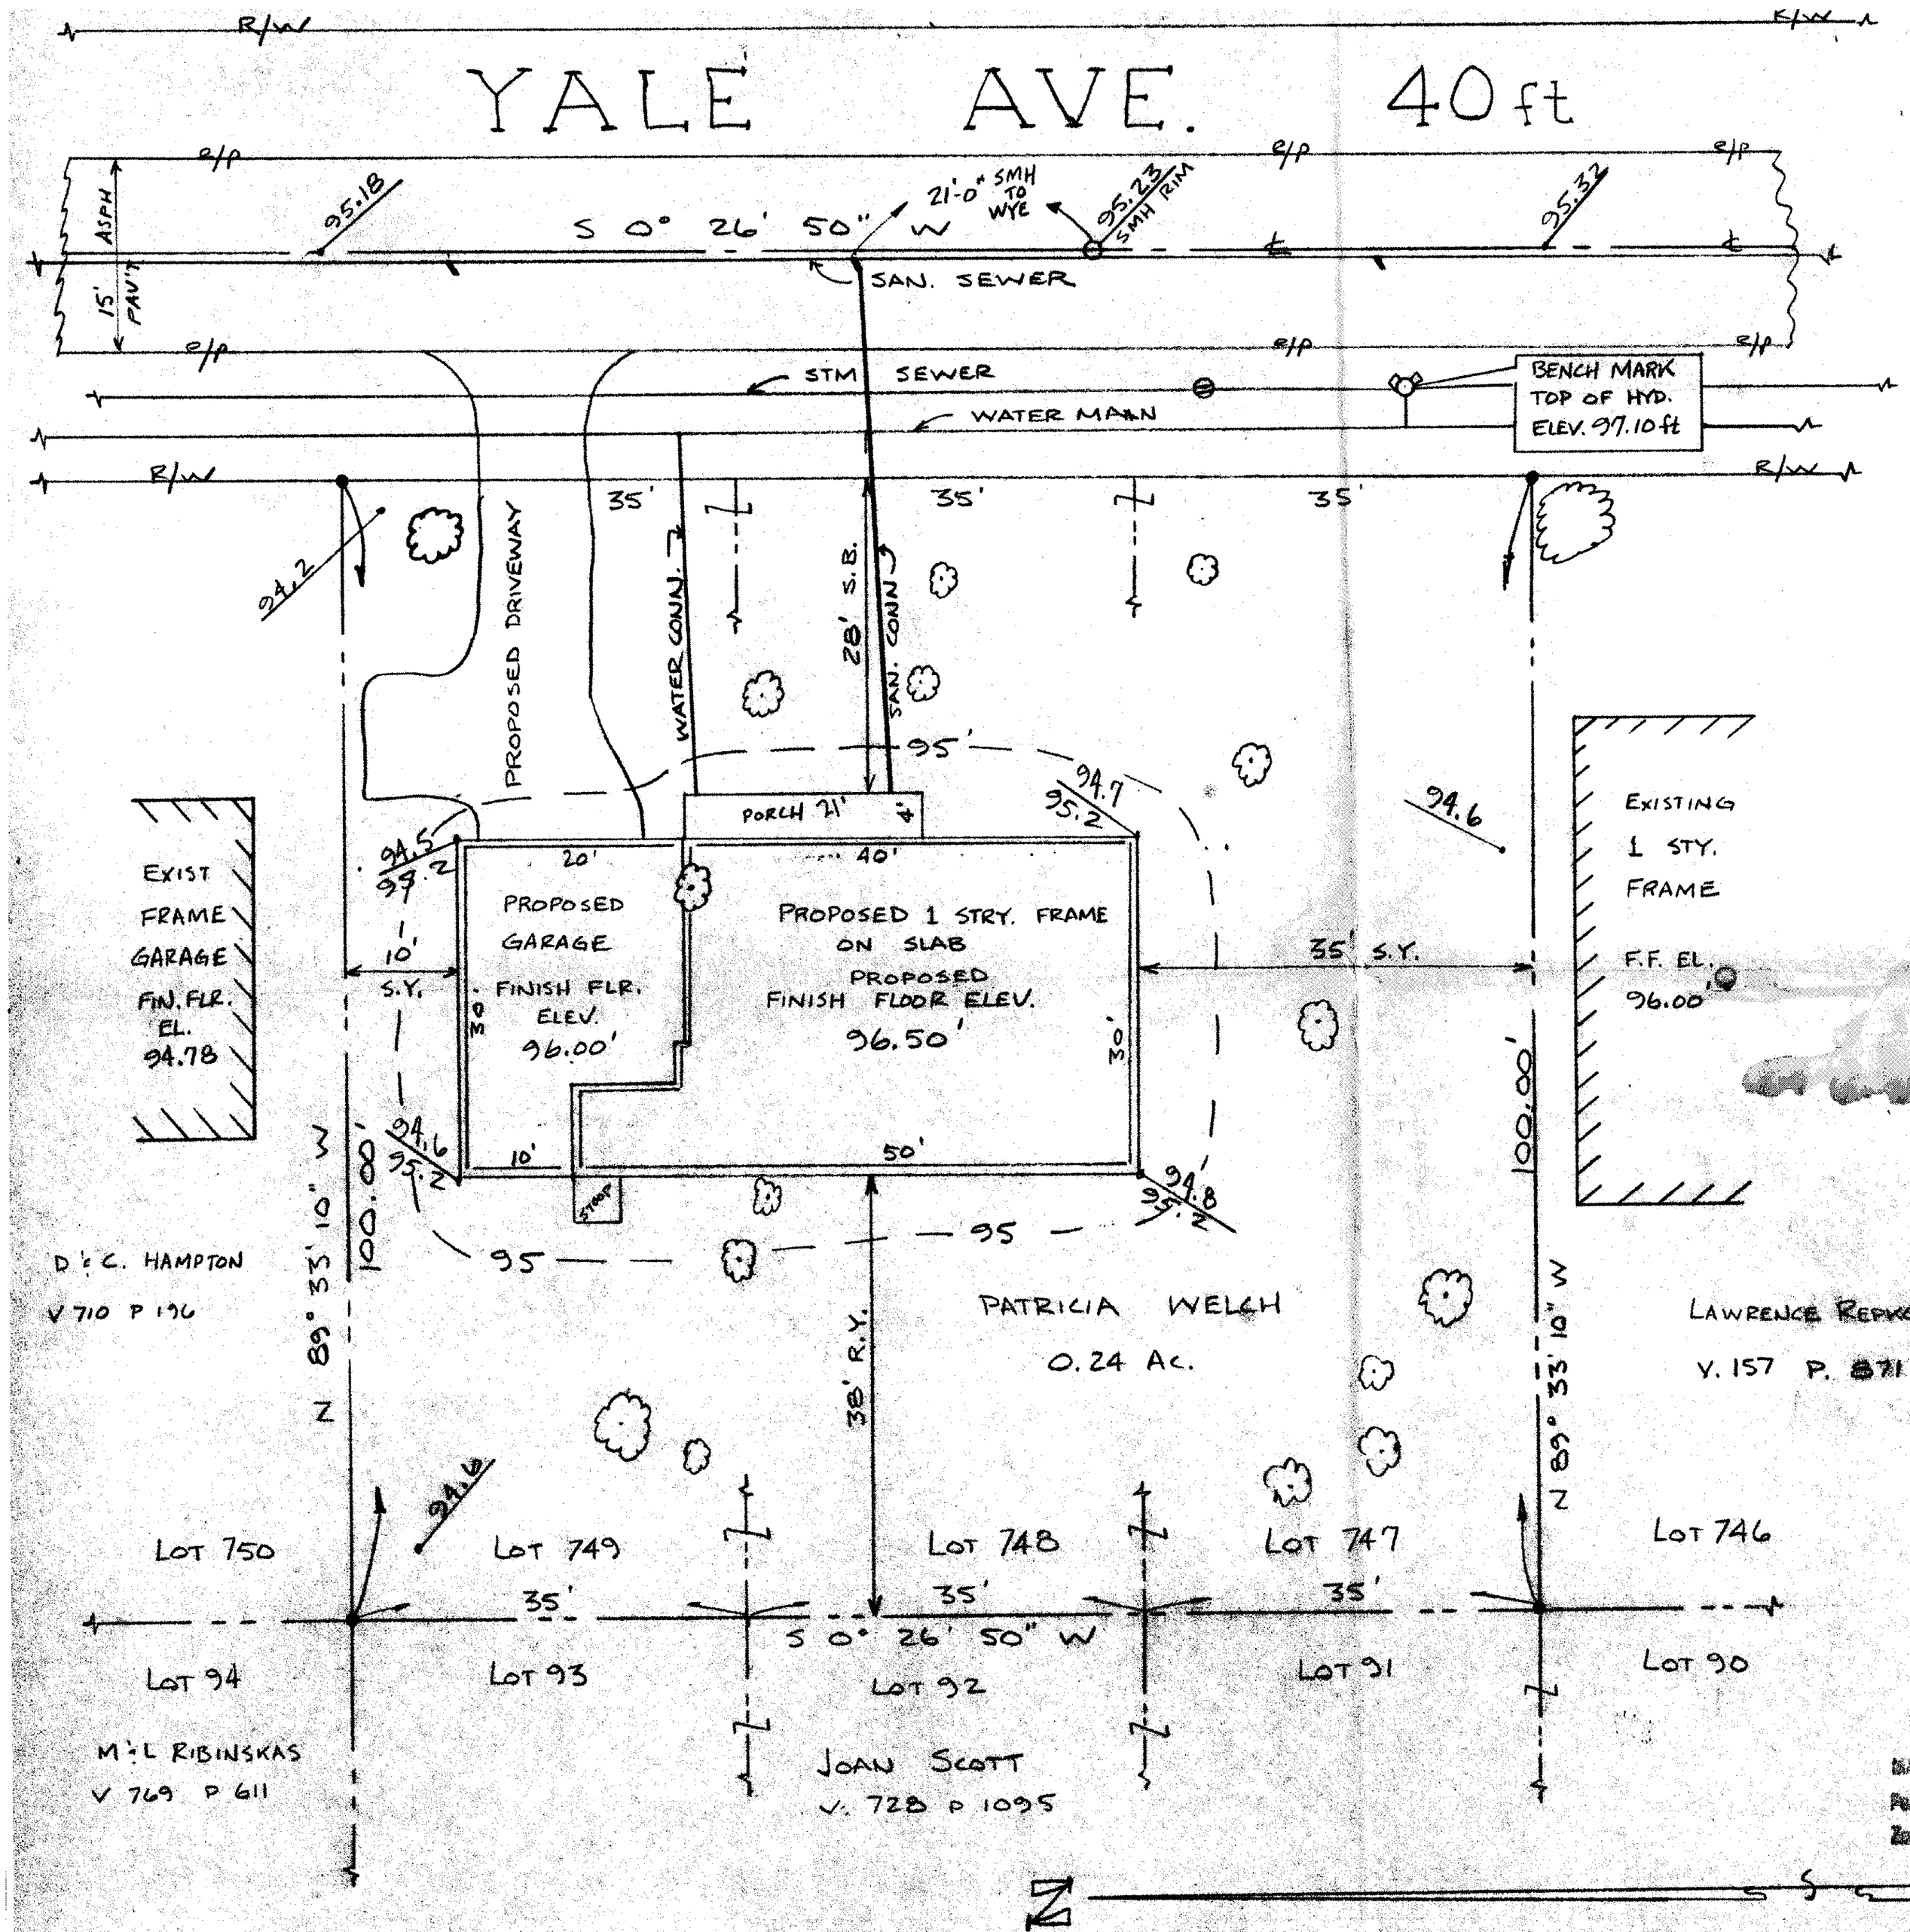

SITE PLAN

FOR

DAVE WELCH

LOT'S 747, 748 & 749
MADISON LAKELANDS SUBD. NO. 2
TRACT 3 LOTS 3 & 4 MADISON TWP.
LAKE COUNTY, OHIO
PLAT BK. D PG. 52

10 DEC. 1992

SCALE 1" = 10 ft.

JIM PETER LAND SURVEY
4759 CROSBY-COOK RD.
ROME, OHIO 44085

NOTE

SAN. MAIN FLOW NORTH
THRU 8" PIPE @ 0.4% & 8 ft deep

Approved
as noted
LES, P.E.
Engineer
GJH Date 12 24 92
FINISHED GRADE SHALL NOT EXCEED EXISTING HOMES

APPROVED
MADISON TWP. ZONING
Permit: 13667
Zoning Inspector:
DEC 21 1992

JM Peter