SURVEY FOR S/L 713 & S/L 714 IN THE
MADISON LAKELAND SUBDIVISION No.2
TRACT 3, LOTS No. 3 & 4
MADISON TWP.
LAKE COUNTY, OHIO

N

SCALE: 1" 10'

Madison Township
RECEIVED JUN 23 1987

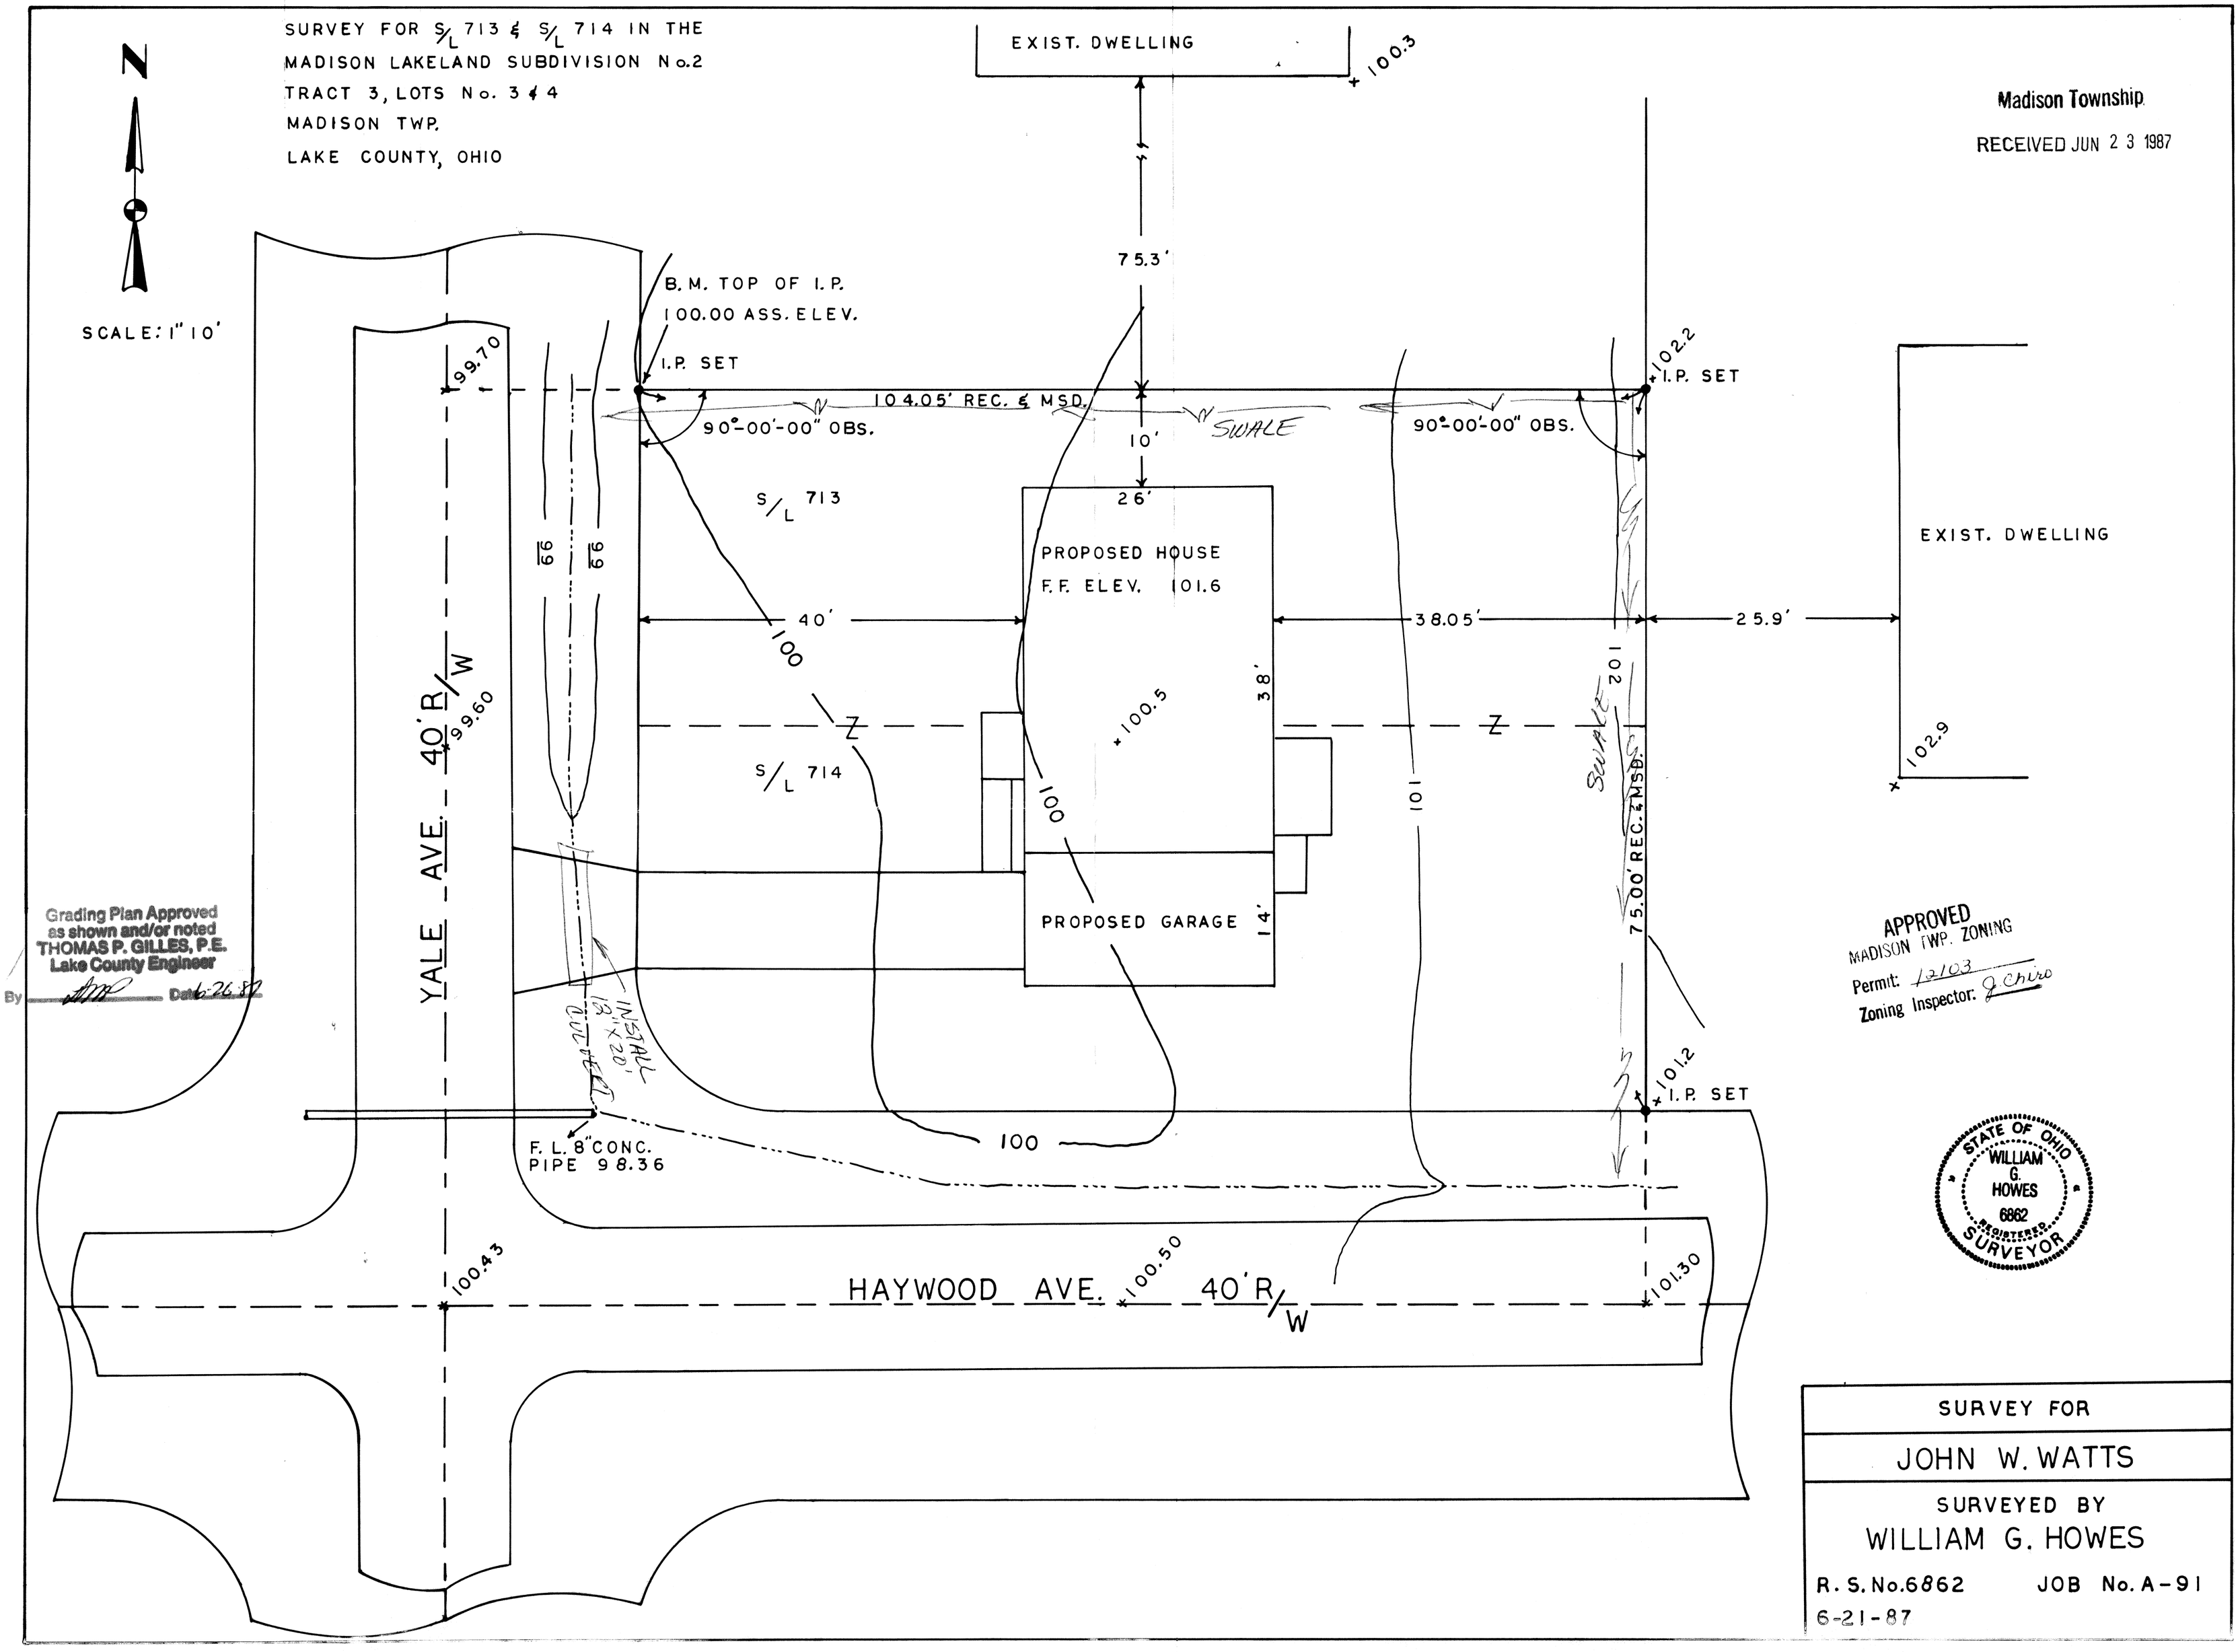

Grading Plan Approved
as shown and/or noted
THOMAS P. GILLES, P.E.
Lake County Engineer
By _____ Date 6-26-87

APPROVED
MADISON TWP. ZONING
Permit: 12103
Zoning Inspector: J. Chiro

STATE OF OHIO
WILLIAM G. HOWES
6862
REGISTERED SURVEYOR

SURVEY FOR
JOHN W. WATTS
SURVEYED BY
WILLIAM G. HOWES
R.S. No.6862 JOB No. A-91
6-21-87