5840 WOODSIDE RD.
MENTOR-ON-THE-LAKE

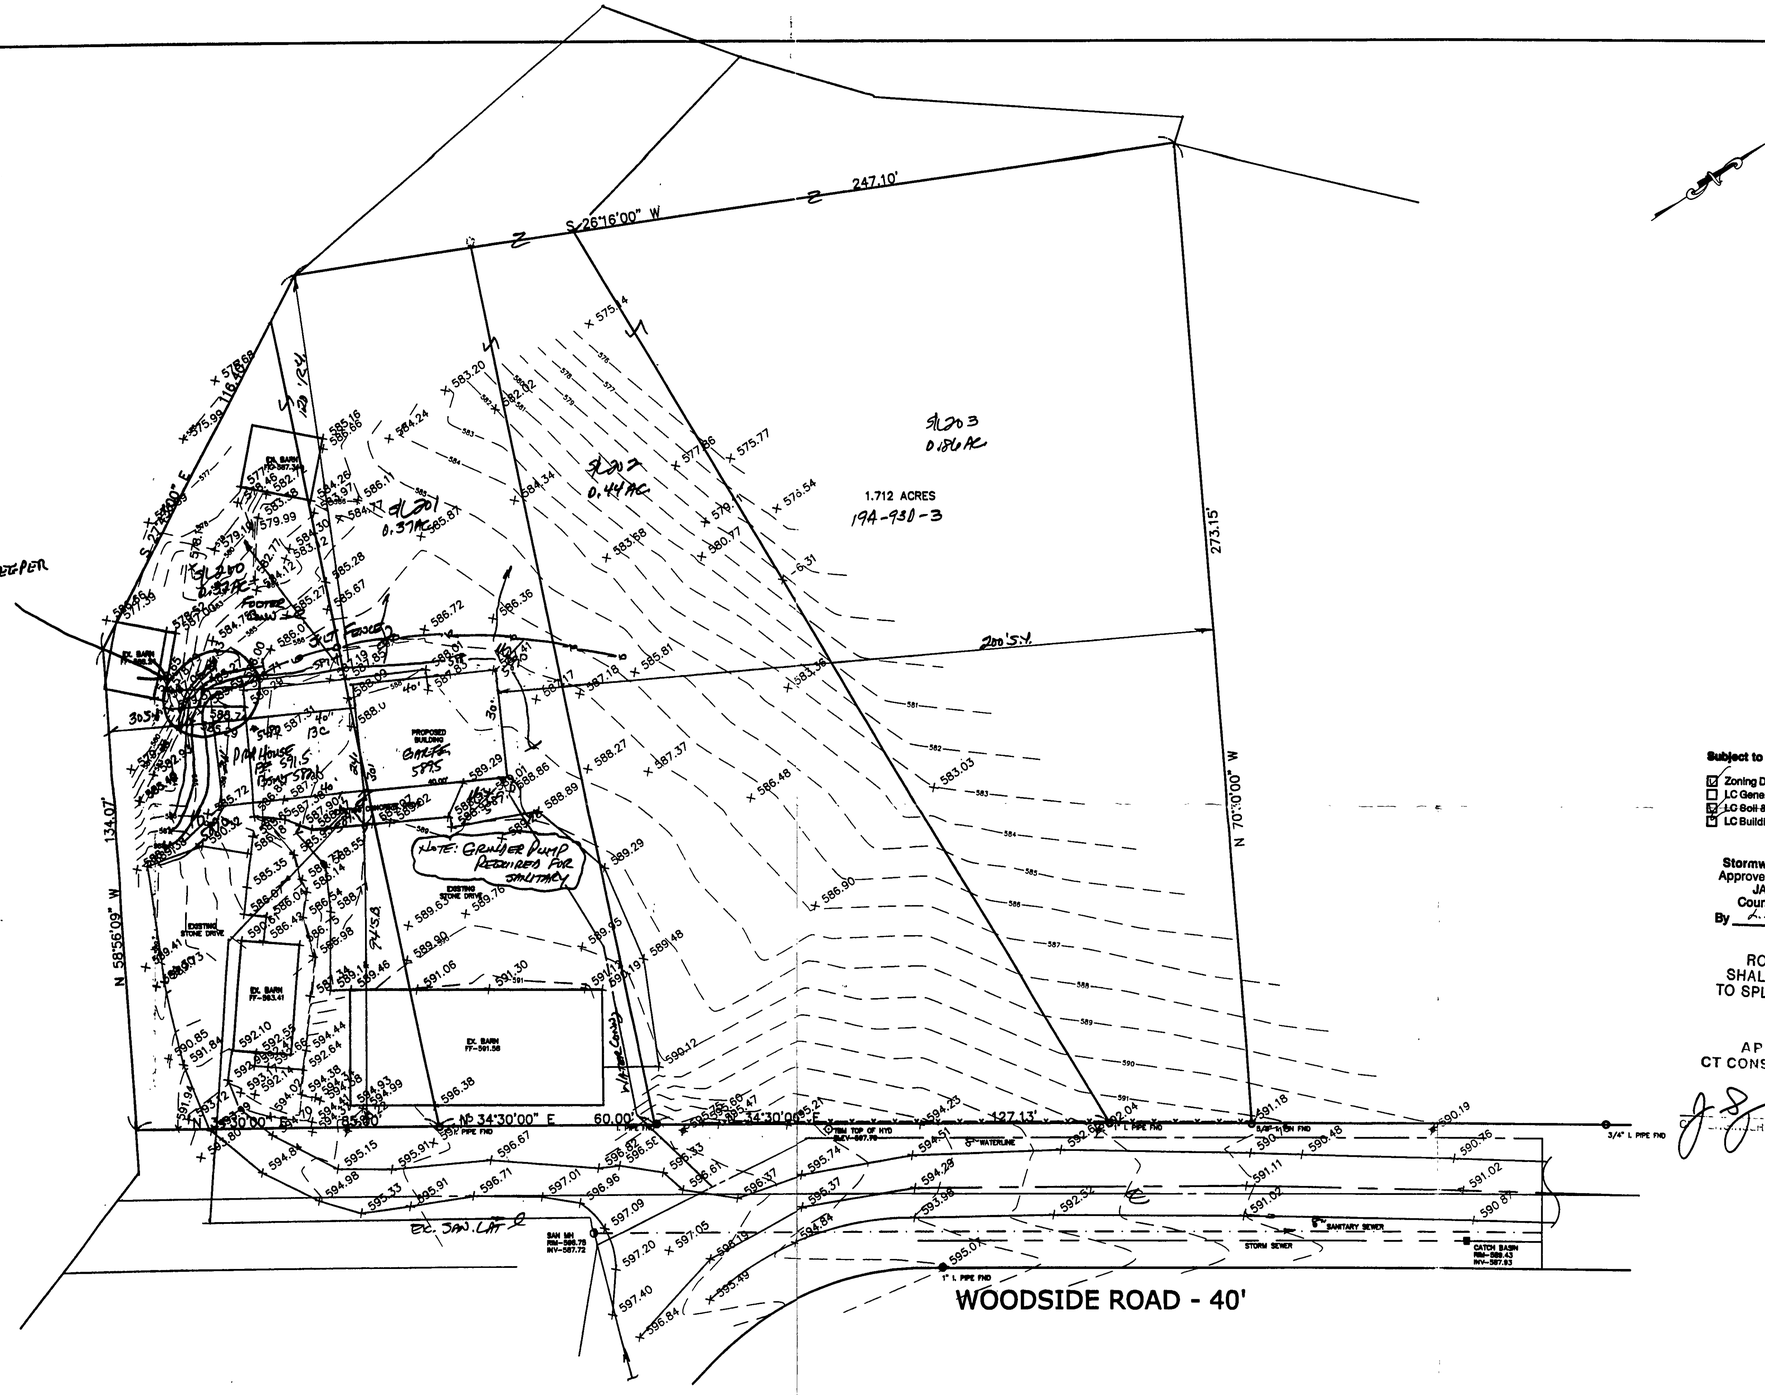

"I, the undersigned hereby certify that this topography indicated by 6", 1', or 2' contours, and elevations shown hereon represent an actual field survey made by me on the 12th day of Nov., 2003 and that the elevations were taken at appropriate intervals and that as of that date they existed as indicated hereon."

Harry Joyce 6313
Name Reg. No.

Subject to approval by:

- [x] Zoning Department
- [ ] LC General Health District
- [x] LC Soil & Water Conservation District
- [x] LC Building Department (final approval)

Stormwater Management Plan
Approved as shown and/or noted
JAMES R. GILLS, P.E.
County Drainage Engineer
By L.S. Date 2/17/04

ROOF DRAINS SHALL DISCHARGE TO SPLASH BLOCKS.

APPROVED AS NOTED
CT CONSULTANTS INC.
2-5-04
CHECKED DATE

591.5 1st Floor F.F. Per Approved Site Plan

"As-built"Top of Block/Slab

1st Floor F.F. Per "As-built" Site Plan

TBM TOP OF FIRE HYDRANT
ELEV-597.79

EXISTING UTILITIES NOTE:
THE SIZE AND LOCATION, BOTH HORIZONTAL AND VERTICAL OF THE UNDERGROUND UTILITIES SHOWN HEREON, HAVE BEEN OBTAINED BY A SEARCH OF AVAILABLE RECORDS. VERIFICATION BY FIELD OBSERVATION HAS BEEN CONDUCTED WHERE PRACTICAL, HOWEVER, BABCOCK, JONES AND ASSOCIATES INC. DOES NOT GUARANTEE THE COMPLETENESS NOR ACCURACY THEREOF.

STATE OF OHIO — HARRY E. JOYCE JR. — E-6313 — PROFESSIONAL SURVEYOR

REV NO.	DESCRIPTION	DATE	BY	CHK'D
1	Added 30'x40' ATTACHED GARAGE	1-16-04	HJ	HJ

BABCOCK, JONES AND ASSOCIATES, INC
CIVIL ENGINEERS – SURVEYORS – LAND PLANNERS
PAINESVILLE OHIO 44077

DATE	11/17/03
DESIGN BY	HJ
DRAWN BY	NS
APPROVED BY	HJ

SITE PLAN
FOR
DON JACOBSON

5480 WOODSIDE ROAD PARCEL 19A-93D-3
MENTOR ON THE LAKE LAKE COUNTY STATE OF OHIO

SCALE 1"=20'
JOB NO 03-270
SHEET 1 OF 1