SITE PLAN
FOR
KEN STRAYER

OF A PART OF SUBLOT No. 1 IN THE LAMPINEN SUBDIVISION AS RECORDED IN VOLUME 2 PAGE 50 OF LAKE COUNTY PLAT RECORDS AND LOCATED IN . . . .

PAINESVILLE TOWNSHIP
LAKE COUNTY OHIO

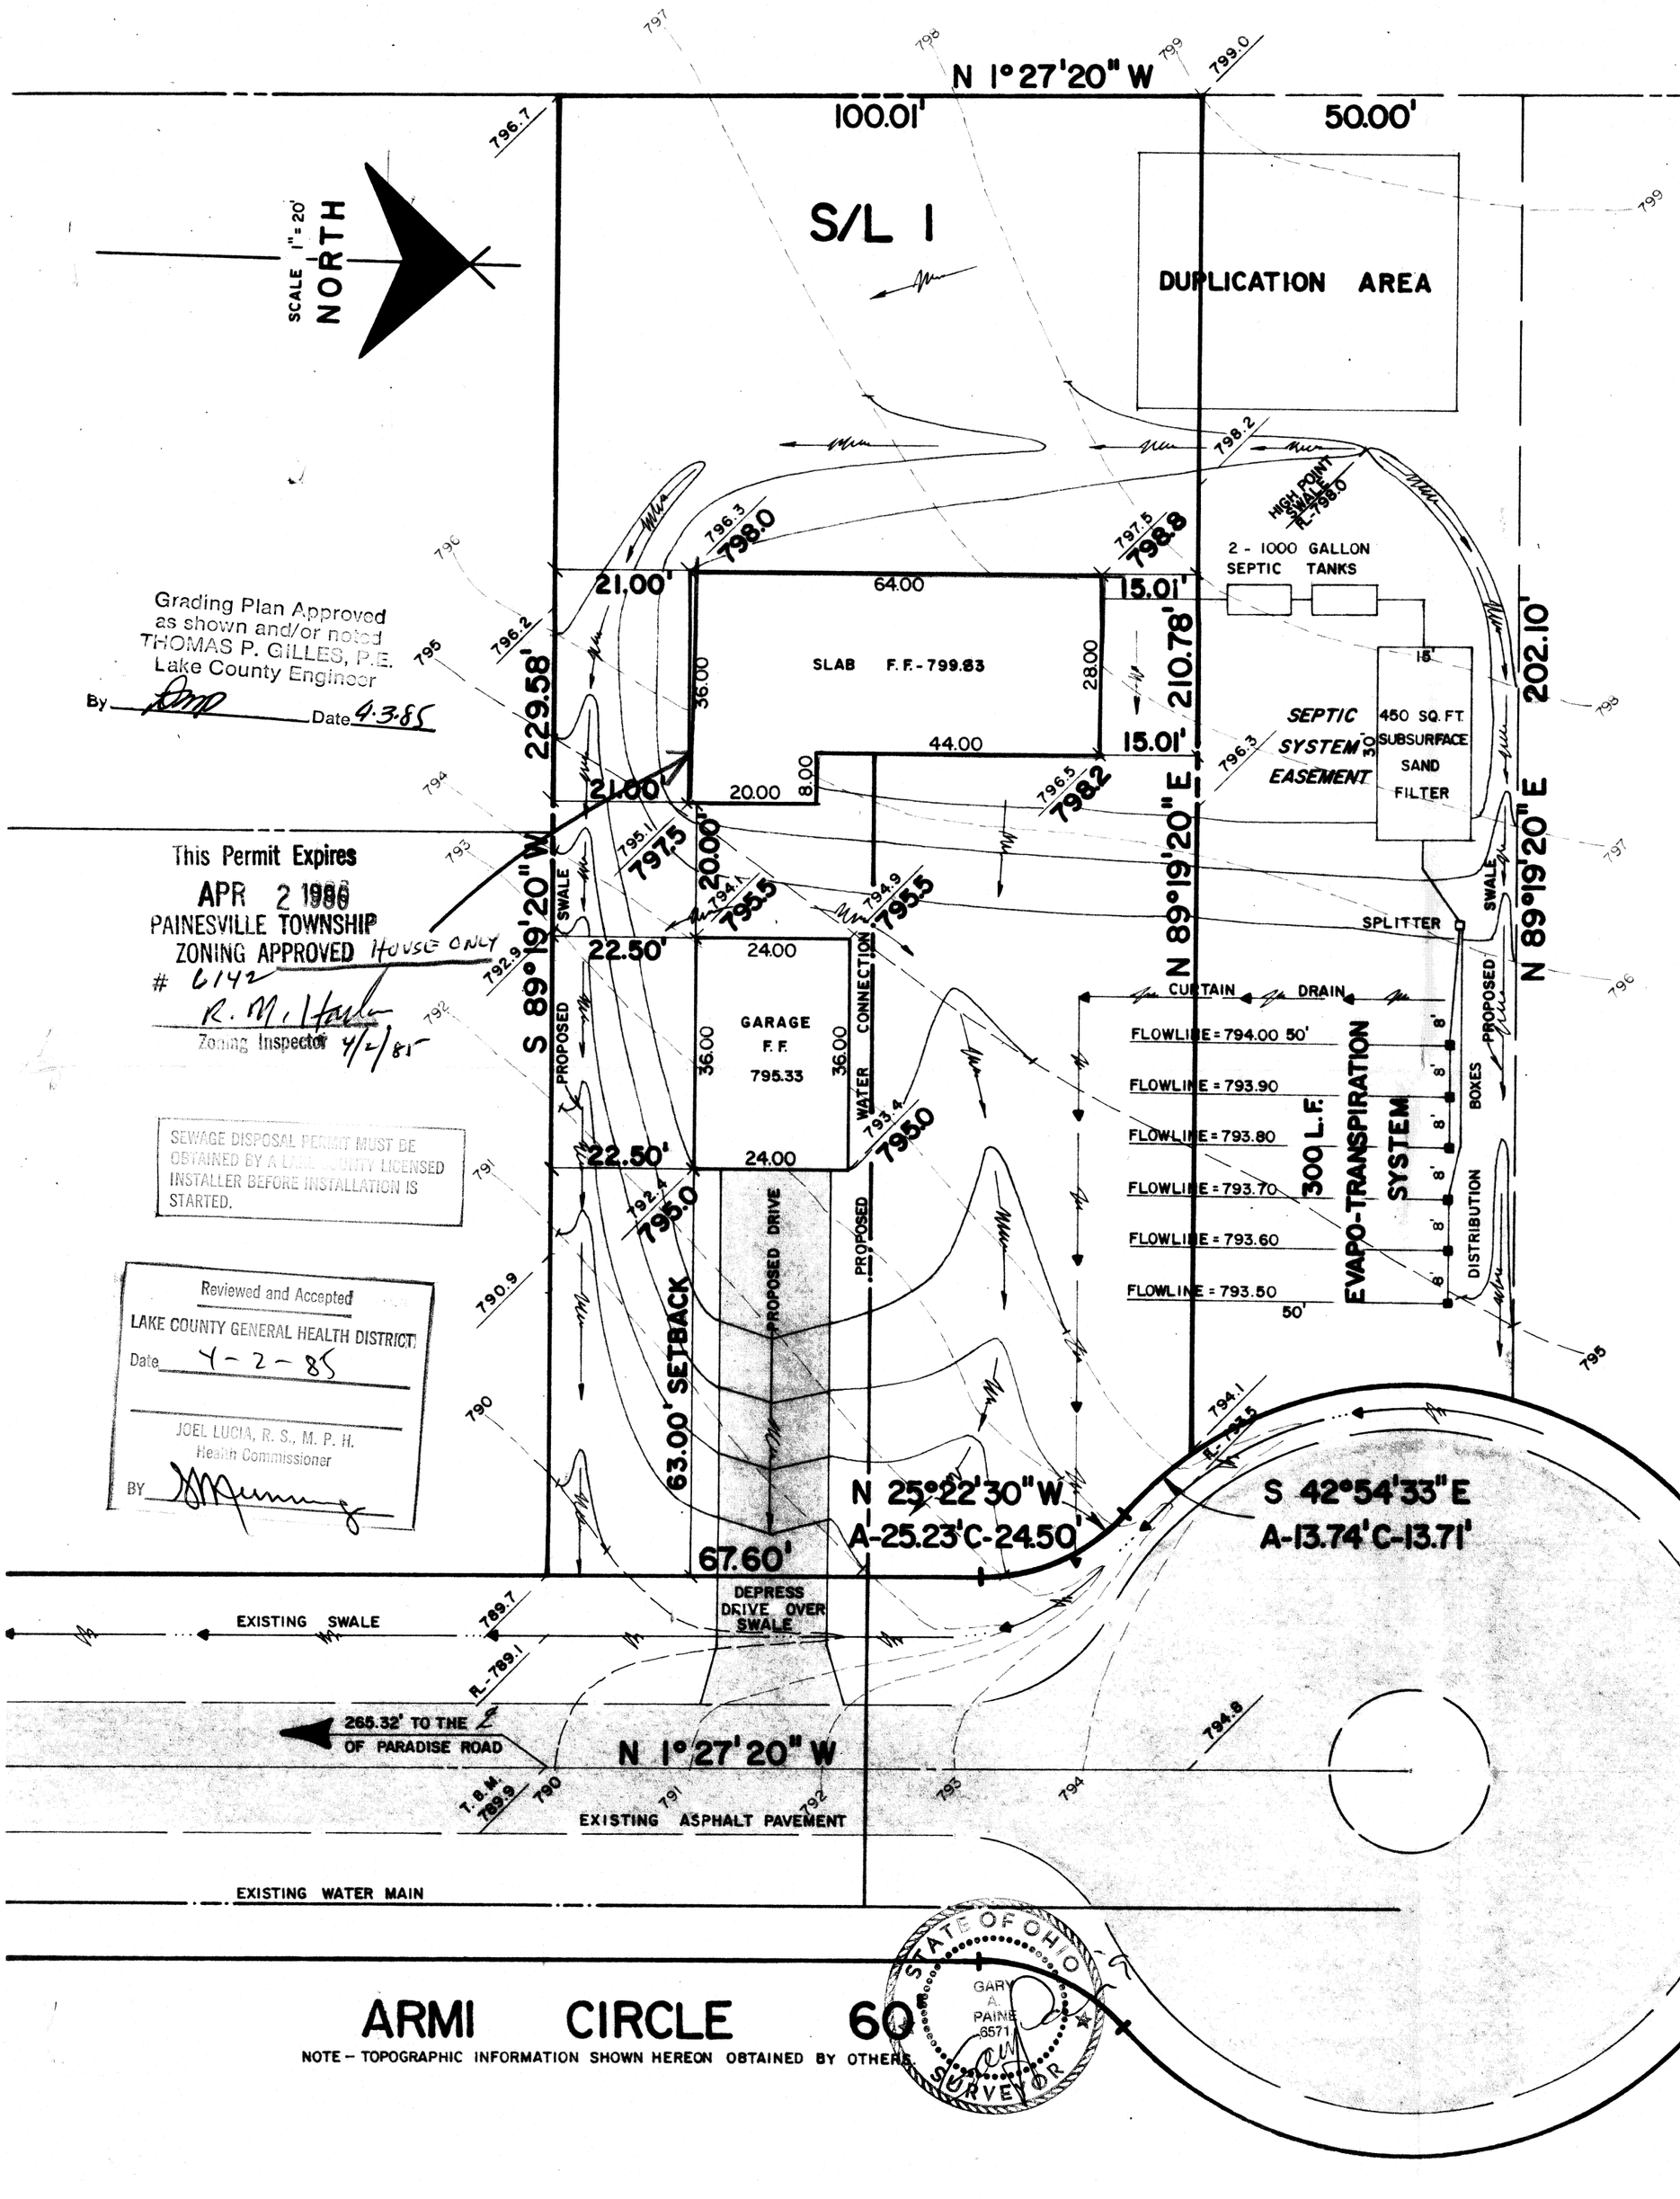

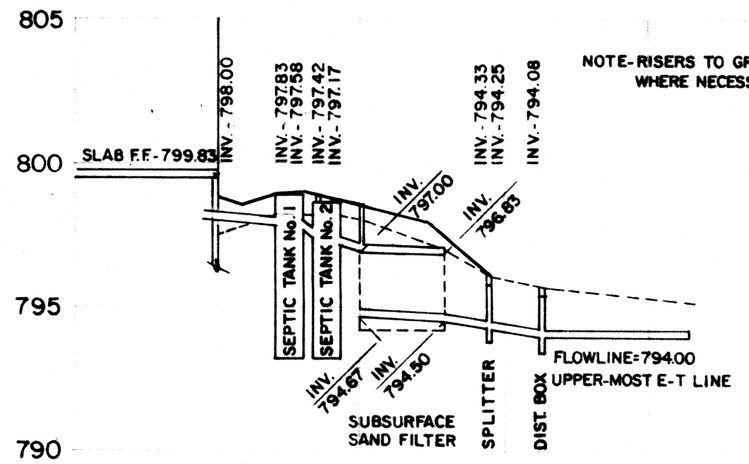

HYDRAULIC PROFILE

SCALES

HORIZONTAL 1" = 50'

VERTICAL 1" = 5'

EXISTING GROUND - - -

PROPOSED GROUND ——

STANDARD SUBSURFACE FILTER

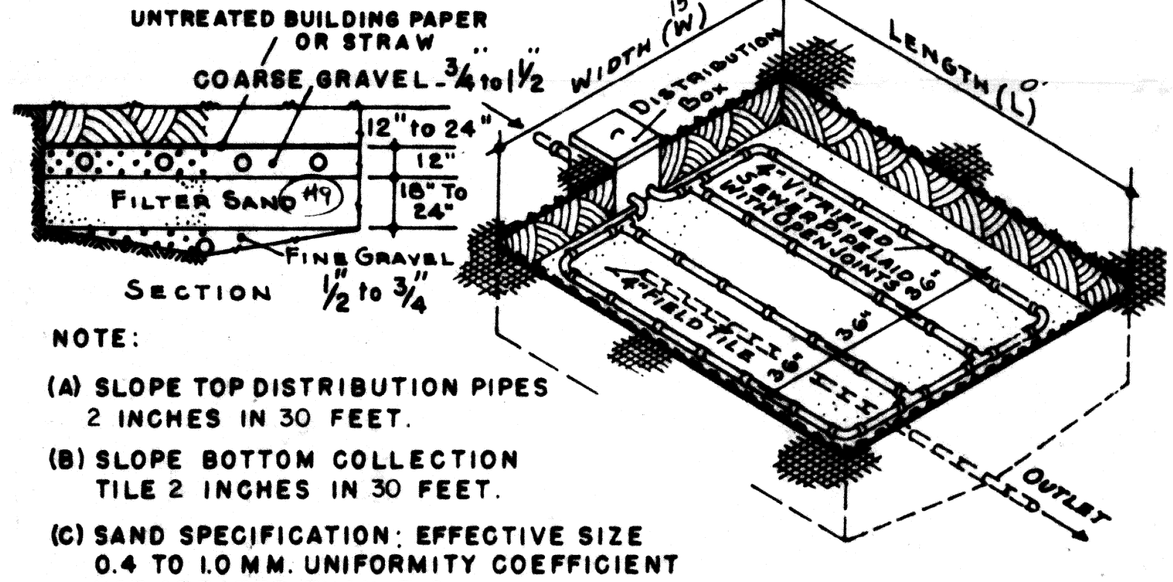

NOTE:

(A) SLOPE TOP DISTRIBUTION PIPES 2 INCHES IN 30 FEET.

(B) SLOPE BOTTOM COLLECTION TILE 2 INCHES IN 30 FEET.

(C) SAND SPECIFICATION: EFFECTIVE SIZE 0.4 TO 1.0 MM. UNIFORMITY COEFFICIENT NOT GREATER THAN 3.0

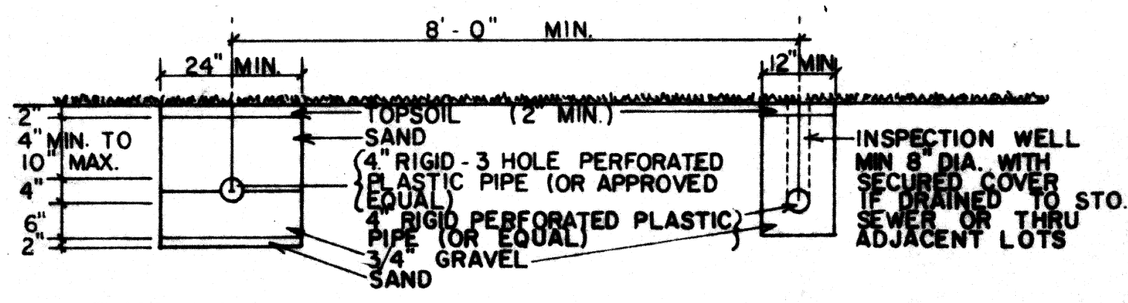

EVAPO-TRANSPIRATION TRENCH

CURTAIN DRAIN TRENCH

TYPICAL SECTION

SCALE 1/2" = 1'-0"

STATE OF OHIO GARY A. PAINE 6571 SURVEYOR

ARMI CIRCLE 60

NOTE - TOPOGRAPHIC INFORMATION SHOWN HEREON OBTAINED BY OTHERS