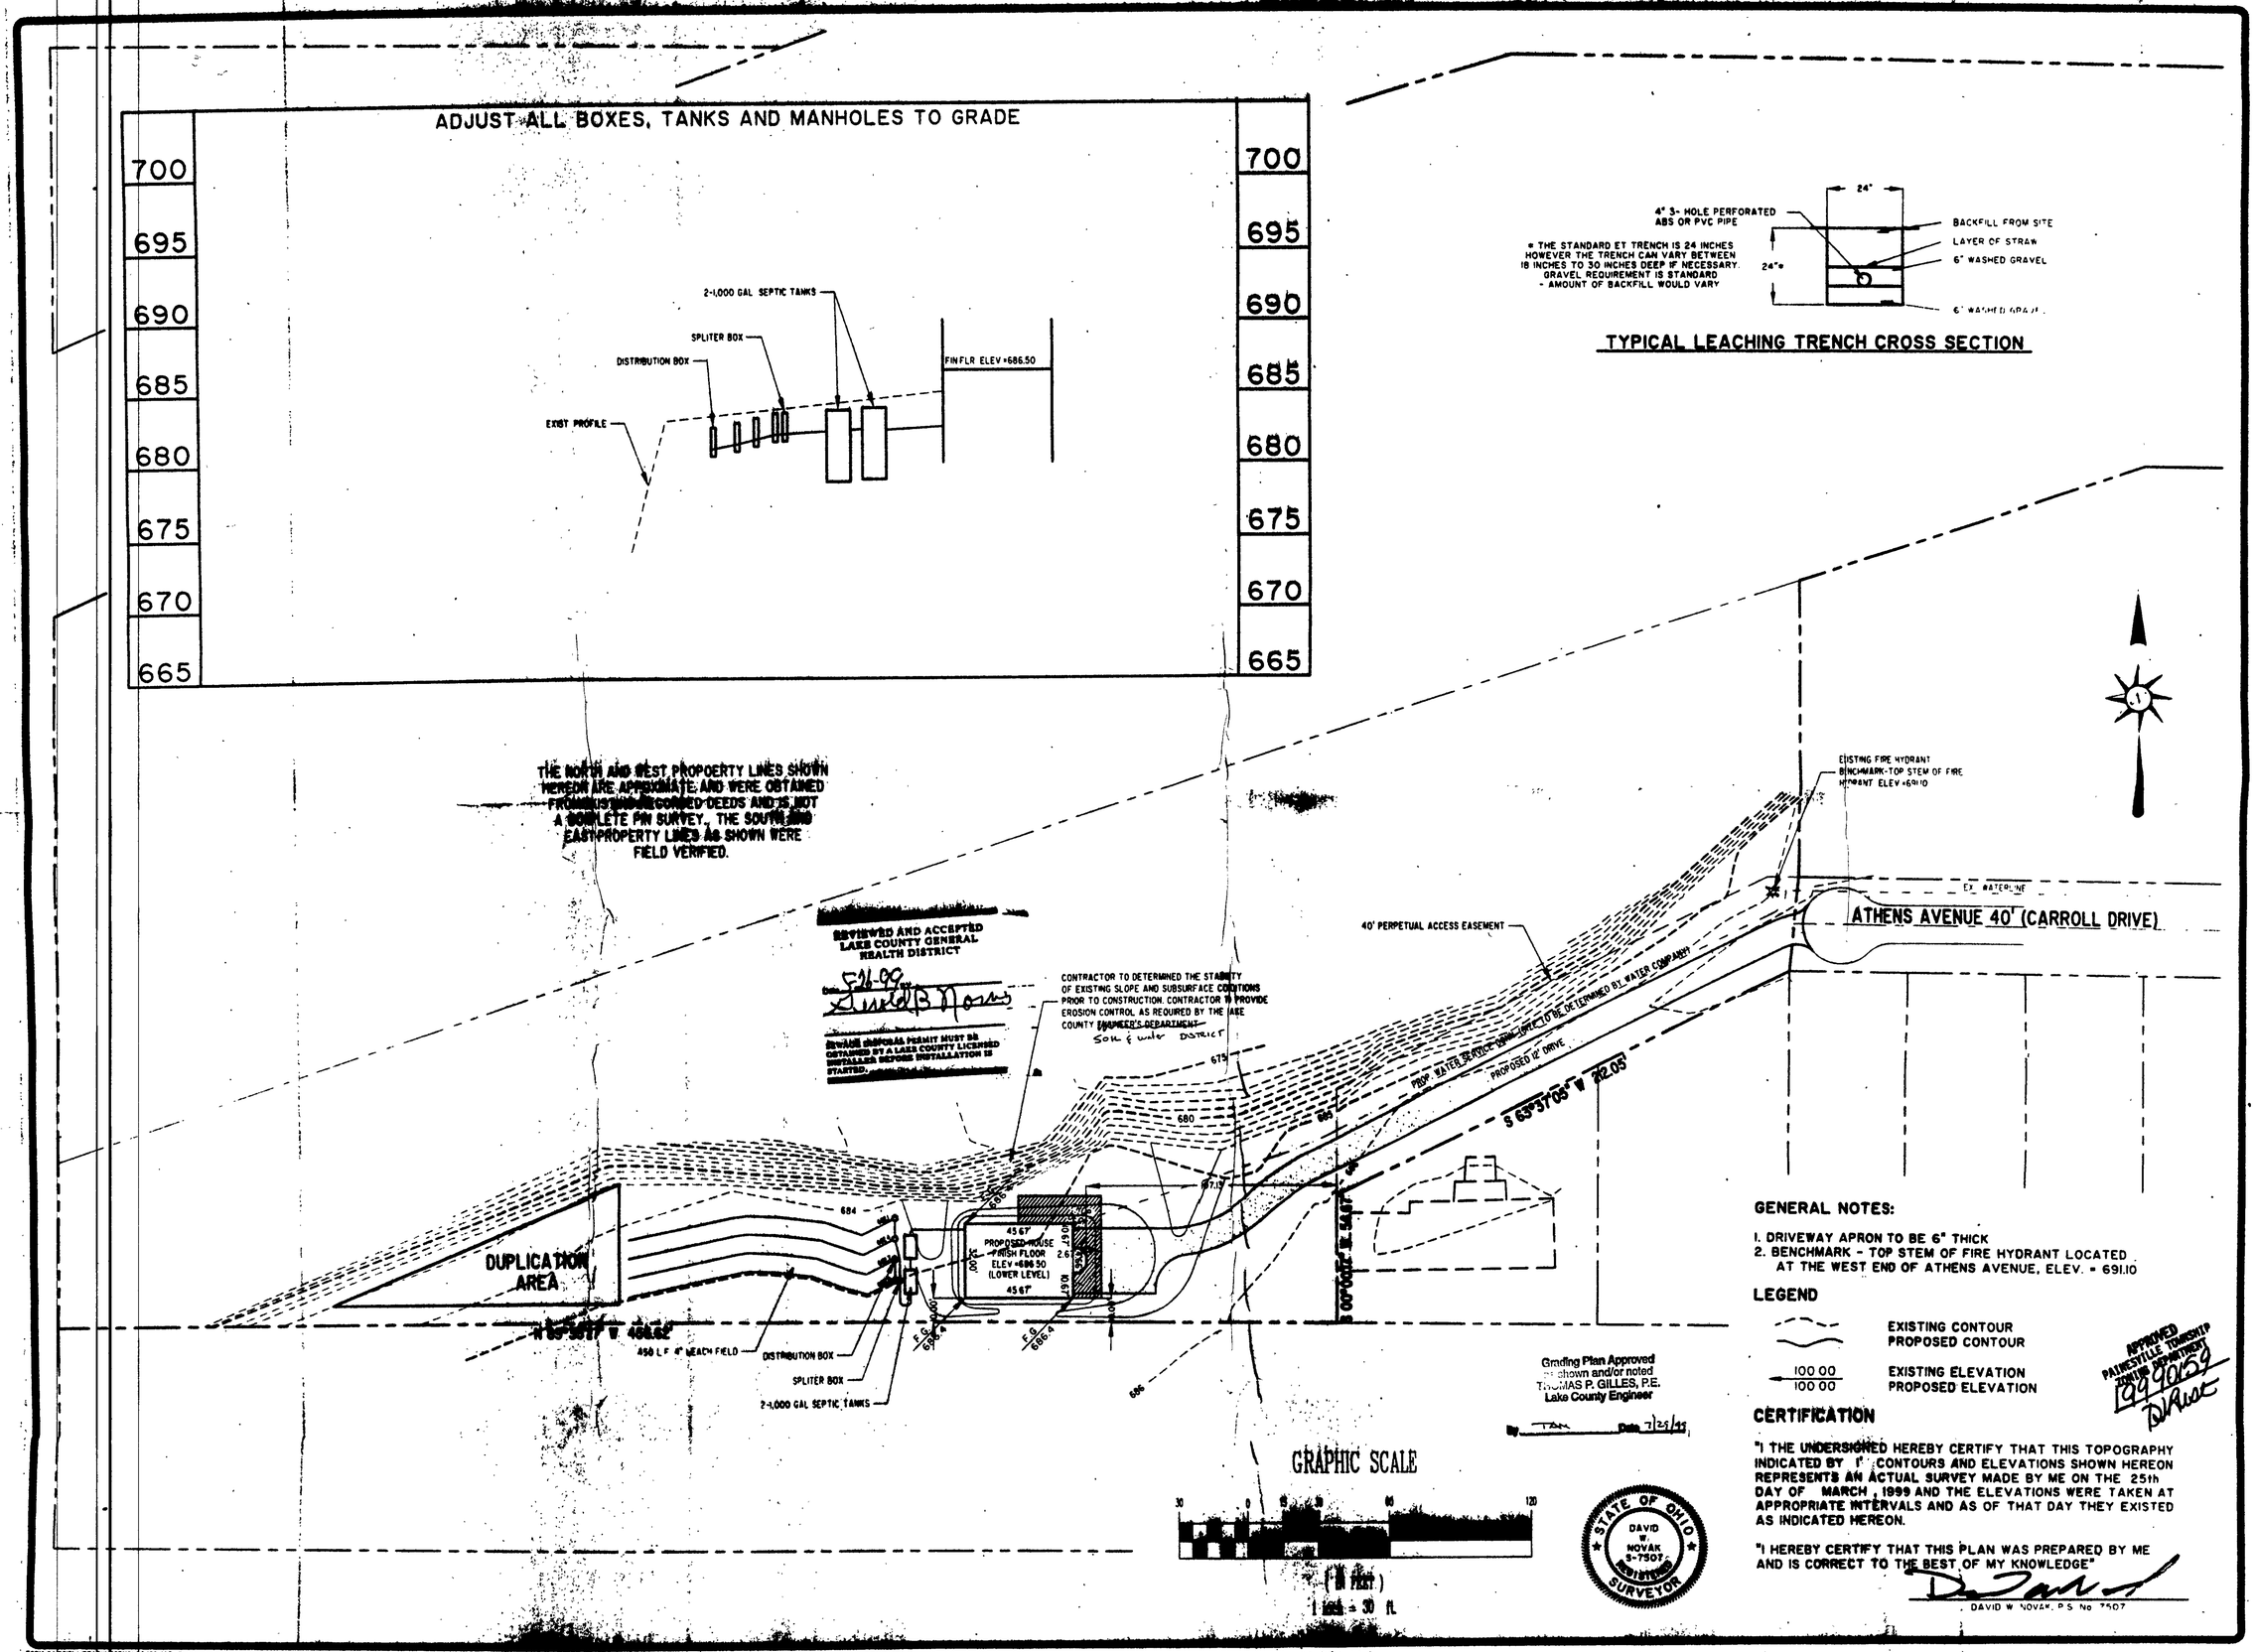

GENERAL NOTES:

1. DRIVEWAY APRON TO BE 6" THICK
2. BENCHMARK - TOP STEM OF FIRE HYDRANT LOCATED AT THE WEST END OF ATHENS AVENUE, ELEV. = 691.10

LEGEND

EXISTING CONTOUR
PROPOSED CONTOUR
100.00 EXISTING ELEVATION
100.00 PROPOSED ELEVATION

CERTIFICATION

"I THE UNDERSIGNED HEREBY CERTIFY THAT THIS TOPOGRAPHY INDICATED BY 1' CONTOURS AND ELEVATIONS SHOWN HEREON REPRESENTS AN ACTUAL SURVEY MADE BY ME ON THE 25th DAY OF MARCH, 1999 AND THE ELEVATIONS WERE TAKEN AT APPROPRIATE INTERVALS AND AS OF THAT DAY THEY EXISTED AS INDICATED HEREON.

"I HEREBY CERTIFY THAT THIS PLAN WAS PREPARED BY ME AND IS CORRECT TO THE BEST OF MY KNOWLEDGE"

DAVID W. NOVAK, P.S. No. 7507

REVISIONS	BY
REVISED HOUSE LOCATION 05/05/99	DWN
REVISED SEPTIC & HSE LOC. 05/19/99	DWN
REVISED BOUNDARY INFO. 05/26/99	DWN

Himebaugh and Novak
Surveyors and Site Consultants
38342 Western Parkway, Unit 10
Willoughby, Ohio 44094
(440) 946-1761, (440) 918-0486 Fax

SITE PLAN

PP No. 11B-32-12, 13, 42 ATHENS AVENUE, PAINESVILLE TOWNSHIP

SCHONIGER BROS. CONST. INC.

DRAWN D.W. NOVAK
CHECKED DWN
DATE APRIL 29, 1999
SCALE 1" = 30'
JOB NO. 99032
SHEET 1/1 OF SHEETS

99032