PAINESVILLE TOWNSHIP
ZONING APPROVED

#DRAINAGE REVIEWED
R. M. Hall 7/19/78
[redacted]

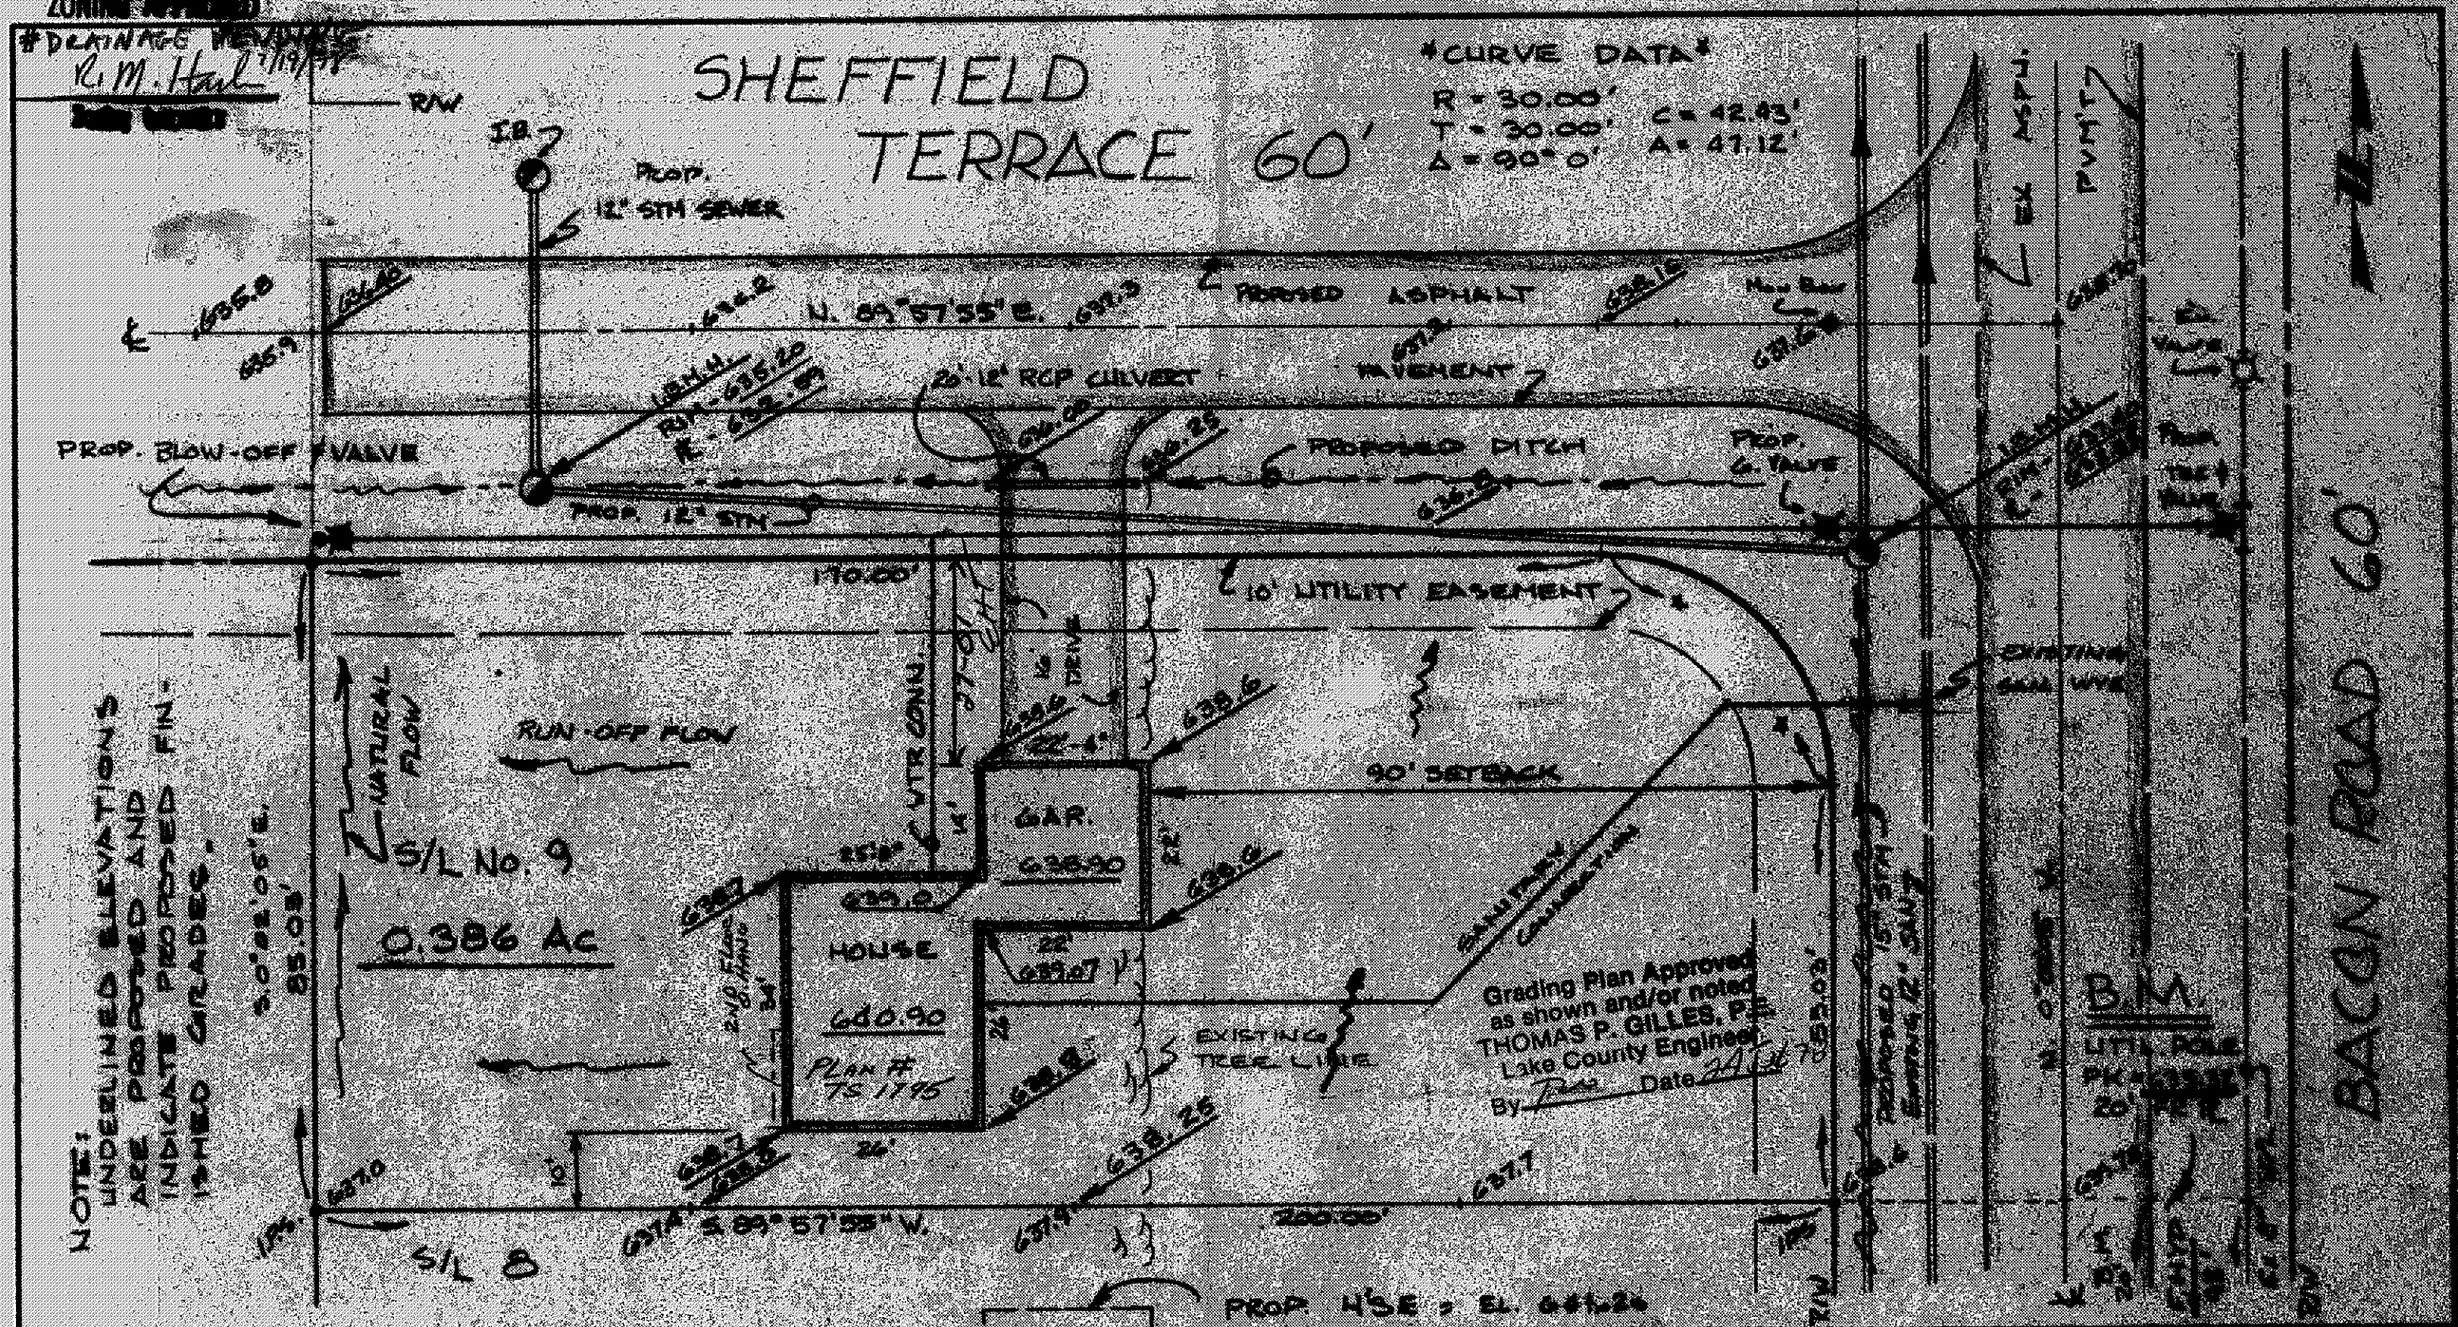


| DESIGN CERTIFICATION | AS BUILT CERTIFICATION | | | |
|---|---|---|---|---|
| THIS PLAT WAS PREPARED BY ME, AND IS CORRECT TO THE BEST OF MY KNOWLEDGE AND BELIEF. | I HEREBY CERTIFY THAT THE CIRCLED GRADES ARE EXISTING FINISH GRADES CHECKED IN THE FIELD ON _____ AND THAT SURVEY IS CORRECT TO THE BEST OF MY KNOWLEDGE AND BELIEF. | COLPETZER · WOODS CONSULTANTS, INC. 180 SOUTH STATE STREET • PAINESVILLE, OHIO 44077 • (216) 357-7589 | DATE JULY 1978 SCALE 1" = 20' DRWN BY JG CHKD BY JOB NO. 78156 FB 332 PG | SITE PLAN FOR EDWARD TRESGER INC. BEING SUBLOT 9 IN THE PINES SUBDIVISION No. 1 D'VILLE TOWNSHIP, LAKE COUNTY, OHIO |
| REG. SURVEYOR NO. 4785 | REG. SURVEYOR NO. | | | |