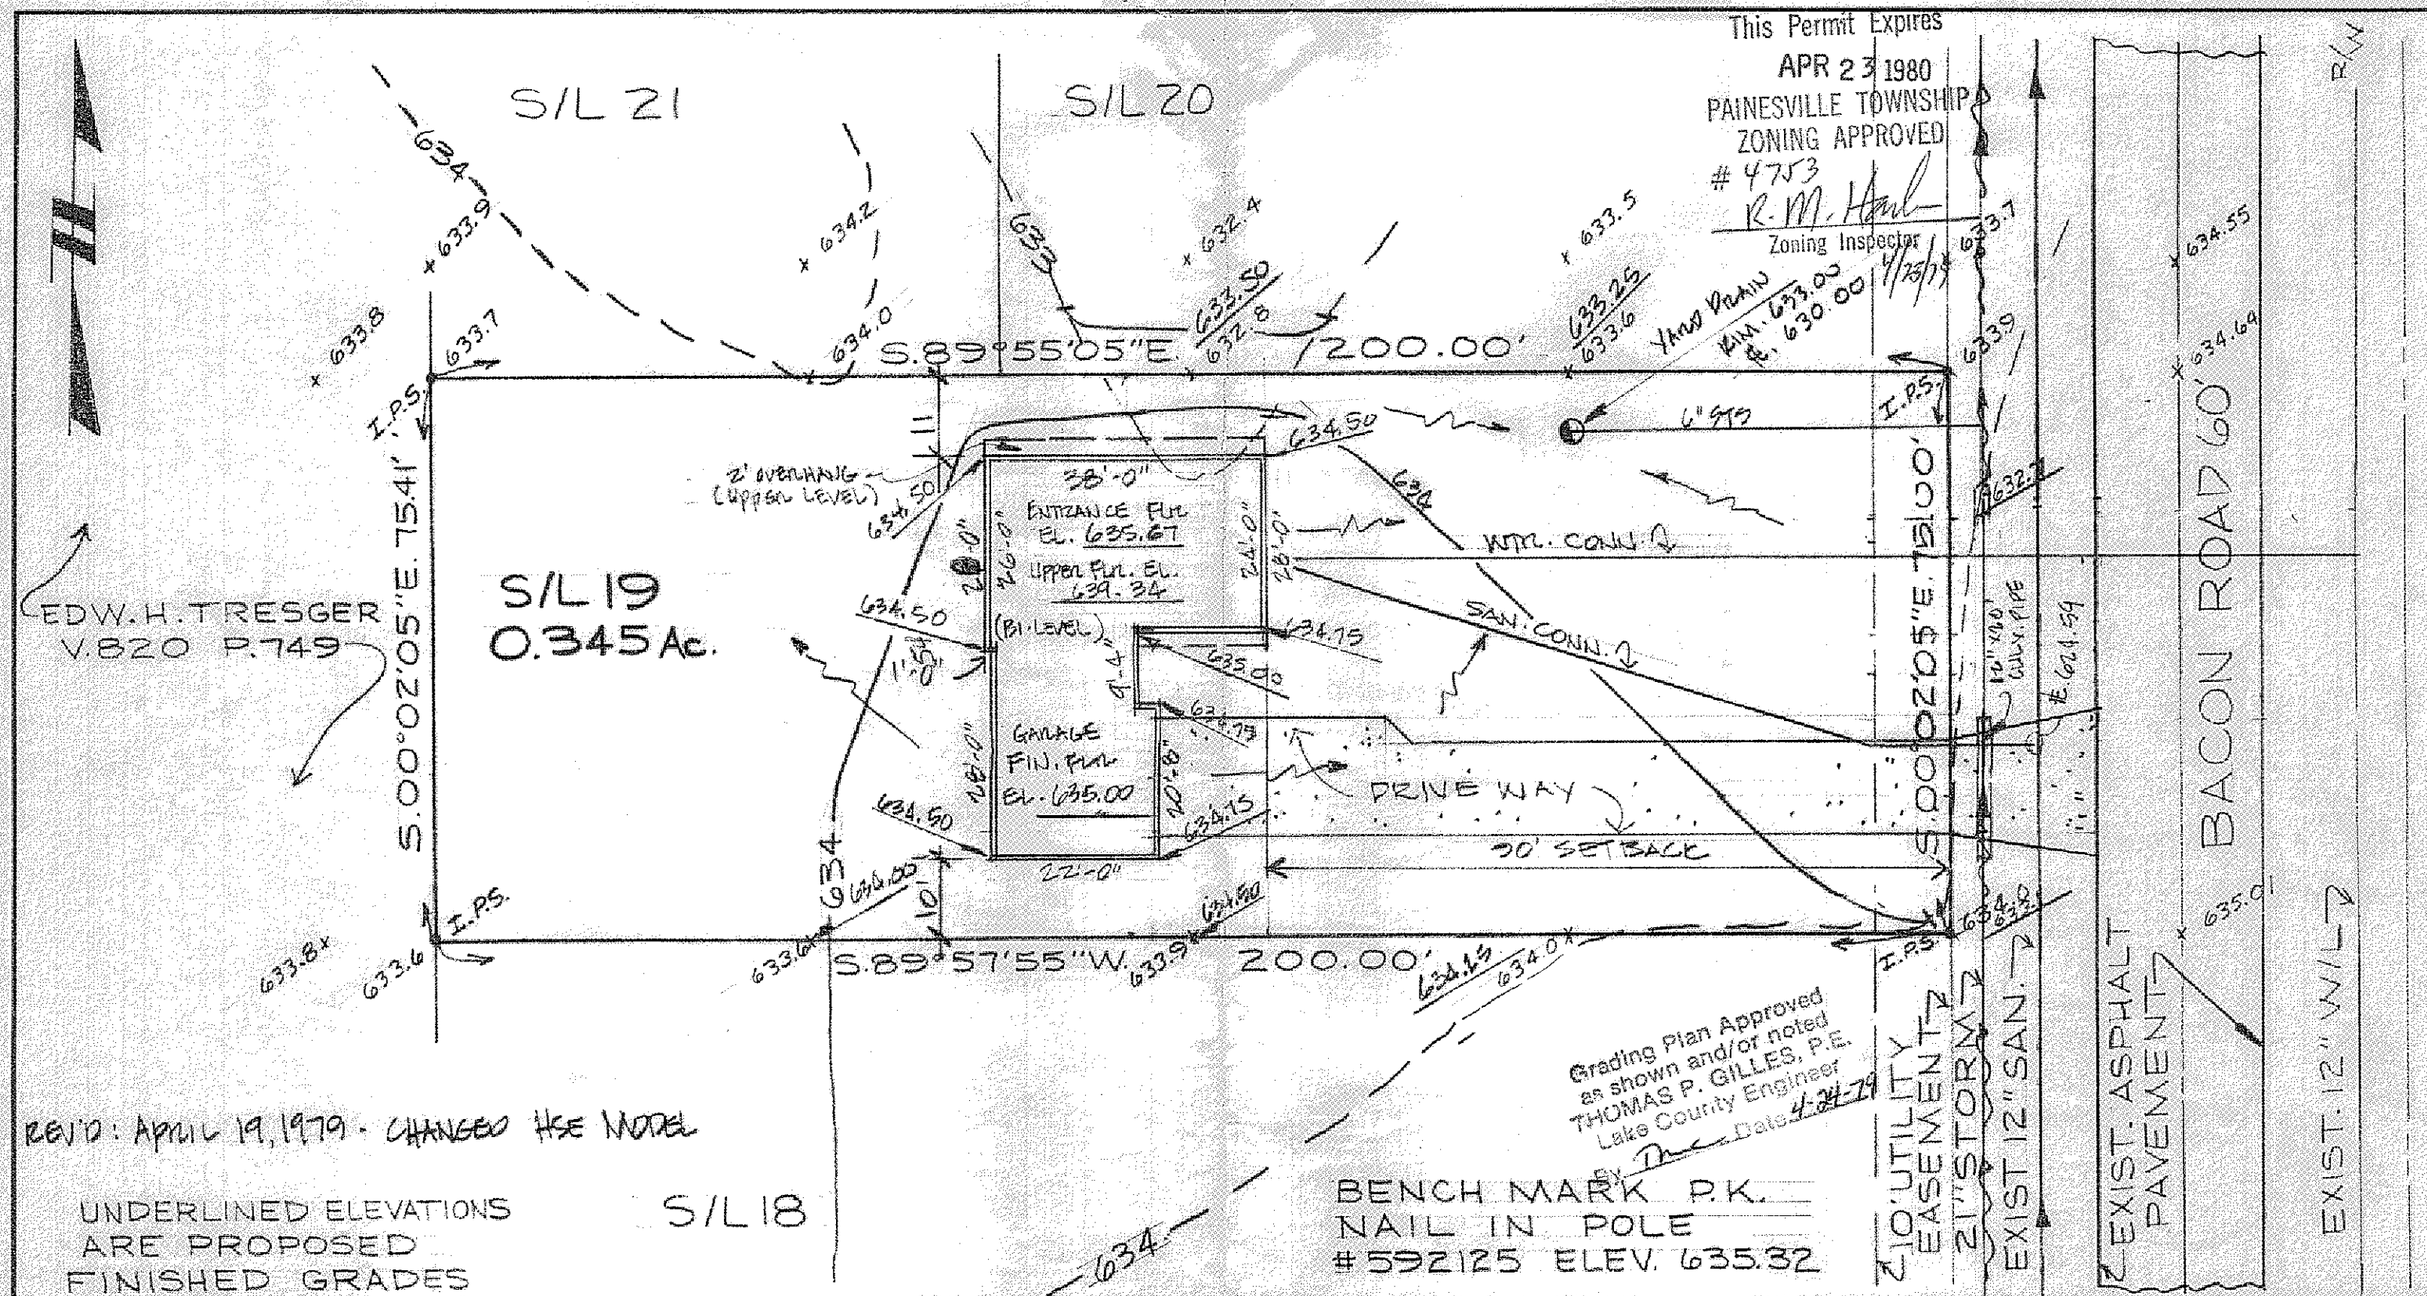

DESIGN CERTIFICATION	AS BUILT CERTIFICATION			
THIS PLAT WAS PREPARED BY ME, AND IS CORRECT TO THE BEST OF MY KNOWLEDGE AND BELIEF.	I HEREBY CERTIFY THAT THE CIRCLED GRADES ARE EXISTING FINISH GRADES CHECKED IN THE FIELD ON _____ AND THAT SURVEY IS CORRECT TO THE BEST OF MY KNOWLEDGE AND BELIEF.	COLPETZER · WOODS CONSULTANTS, INC.	DATE 3/12/79	SITE PLAN FOR INDIAN OAKS COMP.
[signature]		[redacted] • (216) 357-7569	SCALE 1" = 20'	SUBLOT No. 19
REG. SURVEYOR NO. 5176	REG. SURVEYOR NO. _____	9470 MENTOR AVE. MENTOR, OH. 44060	DRWN BY D.E.	PINES SUBDIVISION I.
			CHKD BY _____	PAINESVILLE TWP., LAKE COUNTY, O.
			JOB NO. 79/054	
			FB 332 PG _____	